



PLAT OF SURVEY - PERMIT
LOT 2 OF CERTIFIED SURVEY MAP NO. 4647

LOCATED IN THE NW 1/4 OF THE SE 1/4
OF SECTION 9, TOWN 1 NORTH, RANGE 16 EAST,
TOWN OF WALWORTH, WALWORTH COUNTY, WISCONSIN

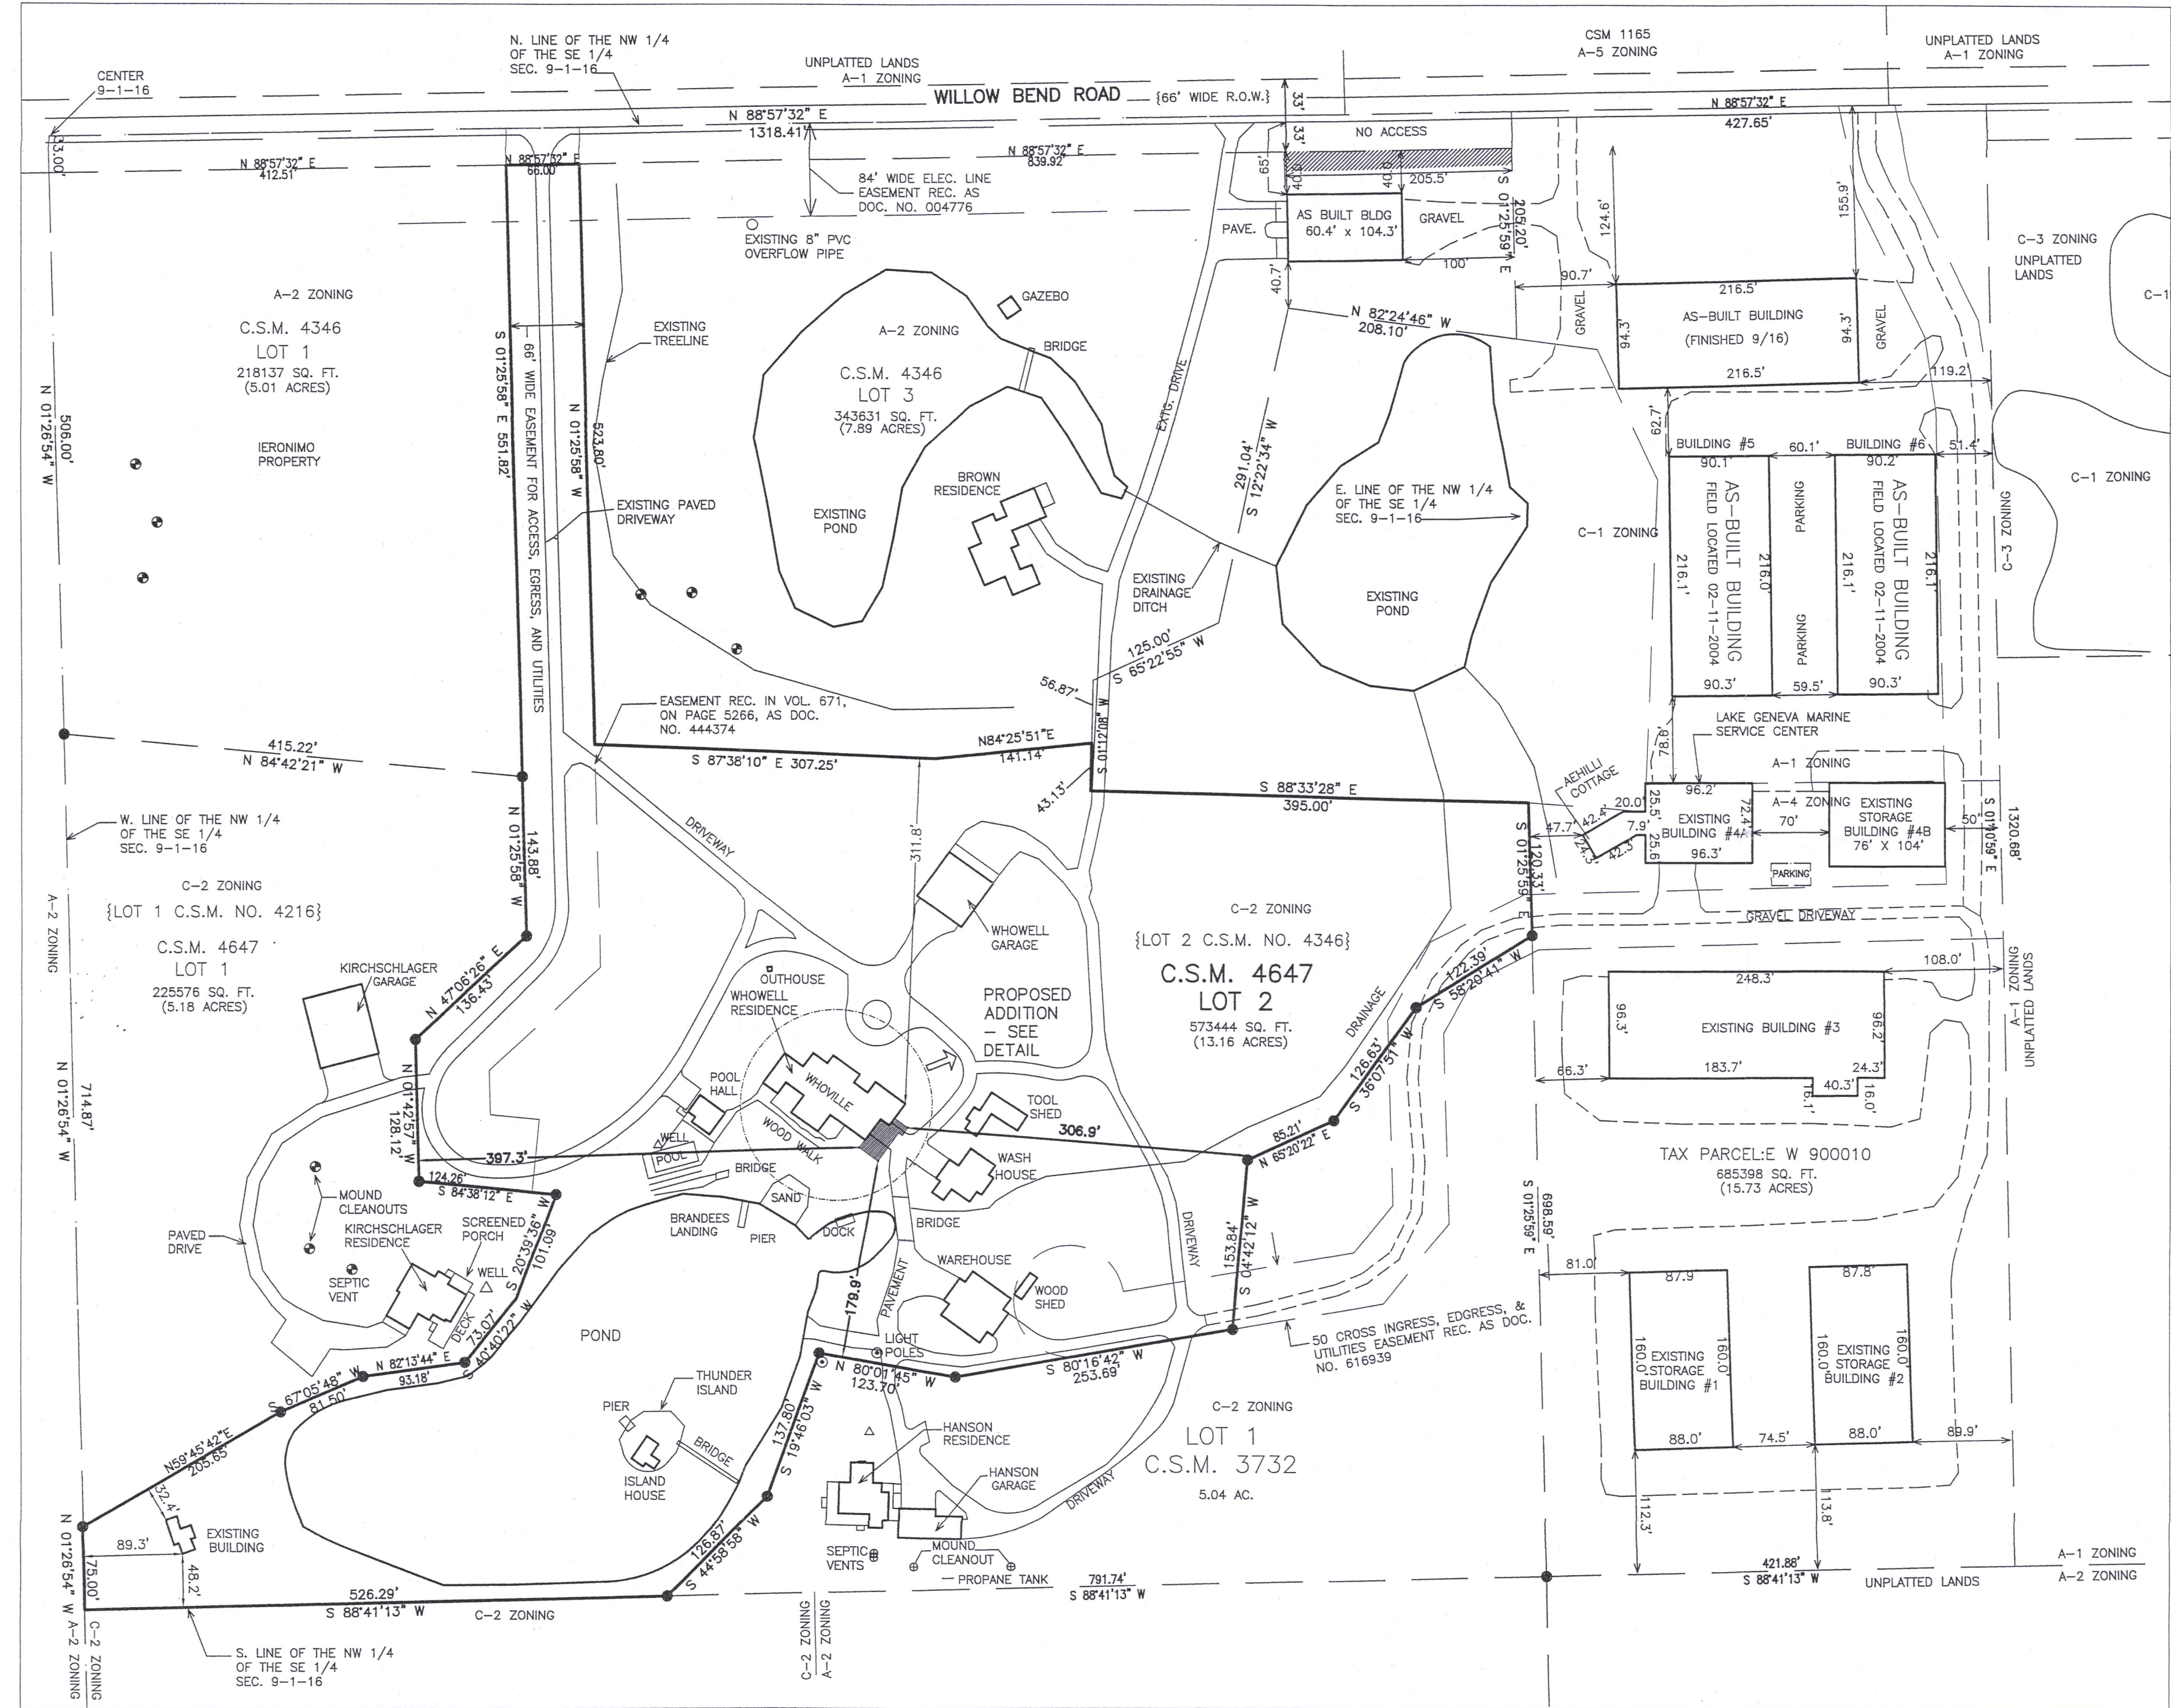

LEGEND
● = FOUND IRON REBAR STAKE
{XXX} = RECORDED AS

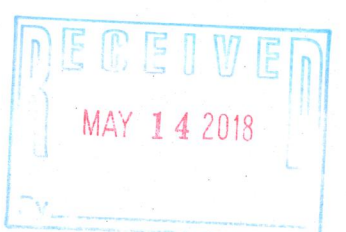


NOTE: COPIES OF THIS MAP TO WHICH THE FOLLOWING CERTIFICATE WILL APPLY SHOW THE SURVEYOR'S ORIGINAL SEAL AND SIGNATURE IN RED INK. COPIES BY ANY OTHER MEANS MAY HAVE ALTERATIONS WHICH DO NOT REPRESENT THE SURVEYOR'S WORK PRODUCT.

I HEREBY CERTIFY THAT THE ABOVE DESCRIBED PROPERTY HAS BEEN SURVEYED UNDER MY DIRECTION AND THAT THE ABOVE MAP IS A TRUE REPRESENTATION THEREOF AND SHOWS THE SIZE AND LOCATION OF THE PROPERTY AND ITS EXTERIOR BOUNDARIES. THIS SURVEY IS MADE FOR THE USE OF THE PRESENT OWNERS OF THE PROPERTY, AND ALSO THOSE WHO PURCHASE, MORTGAGE, OR GUARANTEE THE TITLE THERETO WITHIN ONE YEAR FROM THE DATE HEREOF.



DATED: 05/04/2018

BRIAN M. CARLSON P.L.S. 2039

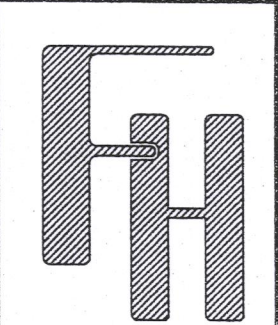

PLAT OF SURVEY - PERMIT
W6287 WILLOW BEND ROAD
WALWORTH, WI 53184

WORK ORDERED BY -
JAMIE HOWELL
P.O. BOX 22
FONTANA, WI 53125

FARRIS, HANSEN & ASSOCIATES, INC.
ENGINEERING - ARCHITECTURE - SURVEYING
7 RIDGWAY COURT P.O. BOX 437
ELKHORN, WISCONSIN 53121
OFFICE: (262) 723-2099 FAX: (262) 723-5886

REVISIONS

PROJECT NO.
5507.16
DATE
05/04/2018
SHEET NO.
1 OF 1

EA 4647-2 116-1047

MAY 04 2018

X:\PROJECTS\5507\5507-16\ACAD\5507-16 PERMIT.DWG