


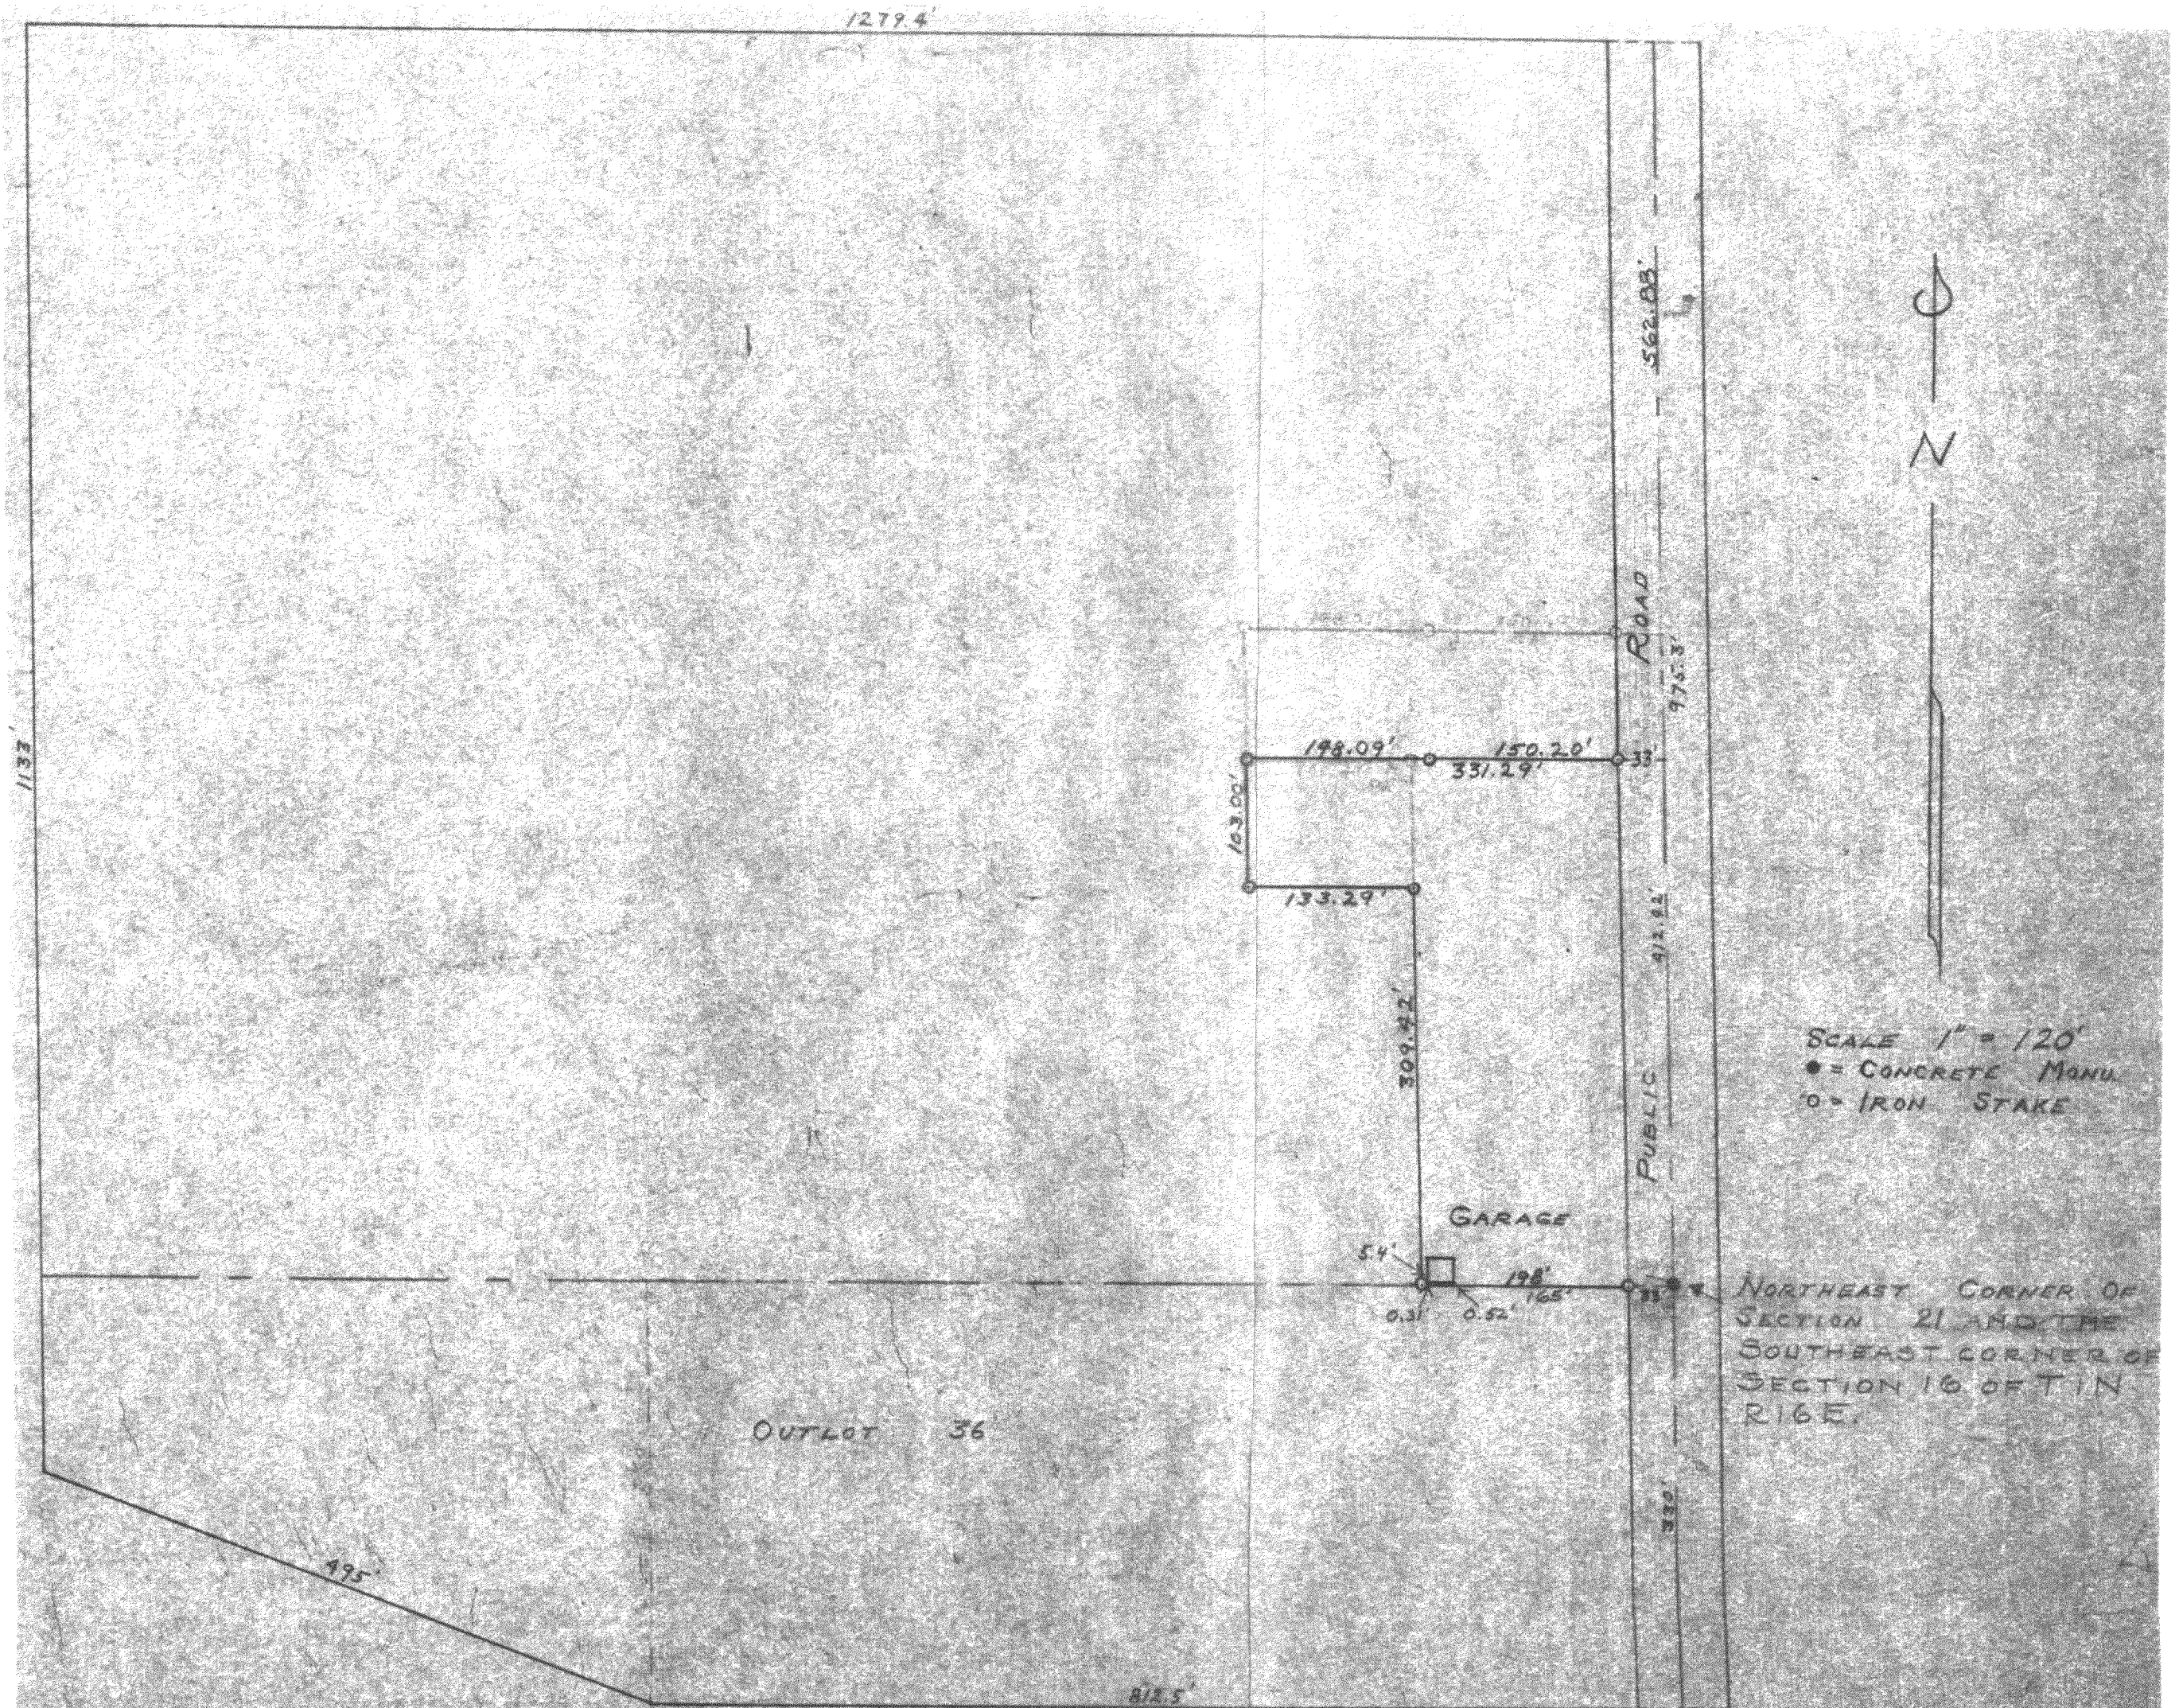

PLAT OF SURVEY OF LAND
LOCATED IN SECTIONS 16 AND 21
OF T1N R16E OF WALWORTH COUNTY
WISCONSIN
SEPTEMBER 22, 1951

VWP-7
VWP-4
11-1-41A

Lloyd L. Jensen
WALWORTH COUNTY SURVEYOR
W-16-24, 26, 27, 28, 29 in T1N R16E WALWORTH

116-26.1