ABELL
SURVEYING & MAPPING
DELAVAN, WISCONSIN 53115
414-728-6737

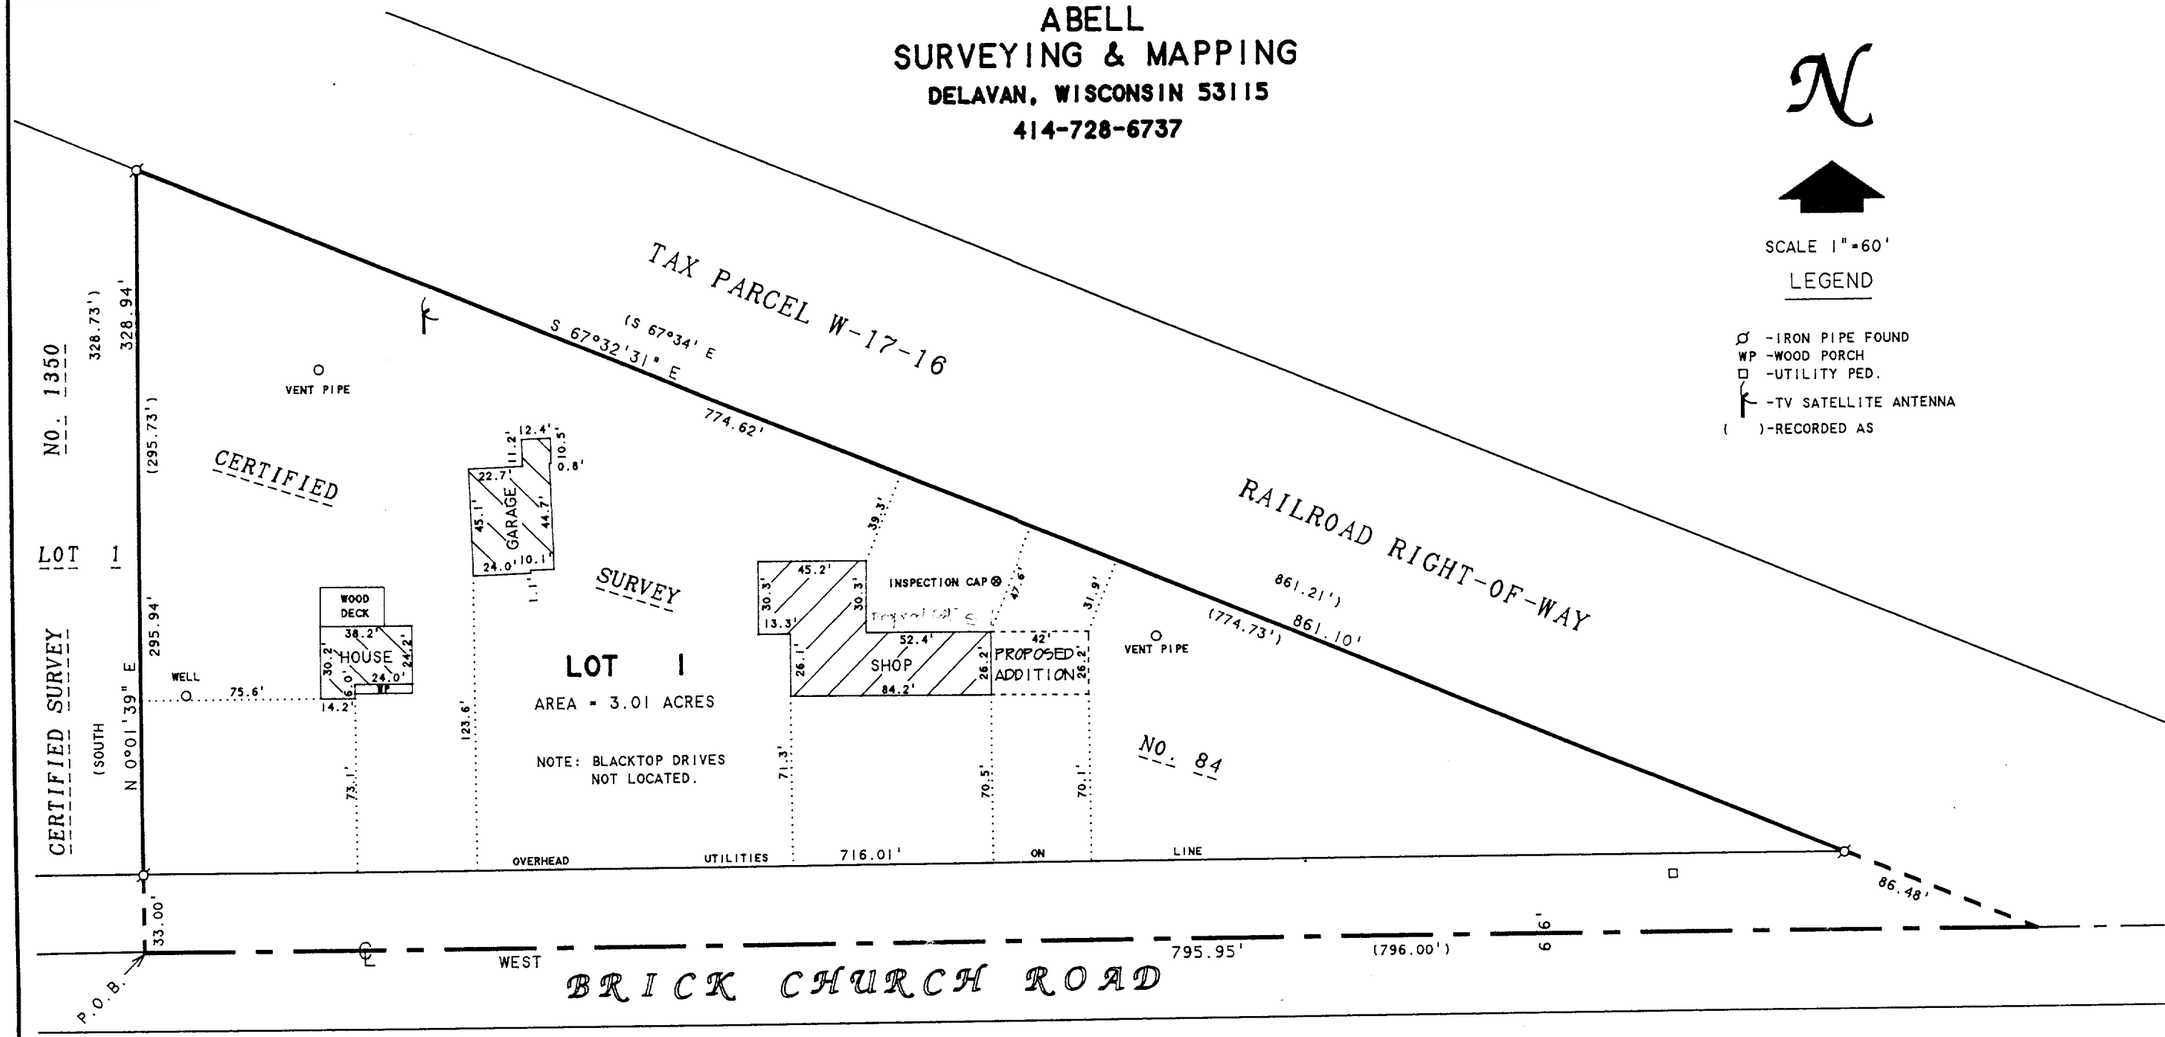

NOTE: BEARINGS ARE REFERENCED TO CERTIFIED SURVEY NO. 84.

PLAT OF SURVEY OF

LOT 1, CERTIFIED SURVEY NO. 84, LOCATED IN THE NORTHWEST 1/4 OF SECTION 17, T1N, R16E, WALWORTH COUNTY, WISCONSIN.

ORDERED BY: RICHARD WETER
W6760 BRICK CHURCH ROAD
WALWORTH, WI 53184

I, DAVID F. ABELL, DO HEREBY CERTIFY THAT I HAVE SURVEYED THE PROPERTY HEREON DESCRIBED ACCORDING TO THE OFFICAL RECORDS AND THAT THE PLAT HEREON IS A CORRECT REPRESENTATION OF THE PROPERTY LINES TO THE BEST OF MY KNOWLEDGE AND BELIEF.

David F. Abell

DAVID F. ABELL
WISCONSIN REGISTERED LAND SURVEYOR, S-1596

December 11, 1995

DATE

JOB NUMBER - 95206

NOTE: THIS IS NOT A CERTIFIED COPY UNLESS SEALED.

RECEIVED
MAR 13 1996

EA-84-1

116-440