



WORK ORDERED FOR:
JOHN & TRINA BARRY
BY: THE RAULAND AGENCY
WALWORTH, WISCONSIN

FARRIS, HANSEN & ASSOCIATES, INC.
ENGINEERING - ARCHITECTURE - SURVEYING
7 RIDGWAY COURT P.O. BOX 437
ELKHORN, WISCONSIN 53121
OFFICE: (262) 723-2098 FAX: (262) 723-5886

REVISIONS



PROJECT NO.
9206
DATE:
12-19-2014
SHEET NO.
1 OF 1

PLAT OF SURVEY

LOT 1 OF CERTIFIED SURVEY MAP 1770
LOCATED IN THE SE 1/4 OF THE SE 1/4 SECTION 29
TOWN 1 NORTH, RANGE 16 EAST
WALWORTH COUNTY, WISCONSIN


Lot 1 of Certified Survey Map No. 1770, recorded December 19, 1988 in Volume 8 of Certified Surveys on page 209 and located in the SE 1/4 of Section 29, T1N, R16E, Walworth County, Wisconsin.

Tax Key No.: EA177000001

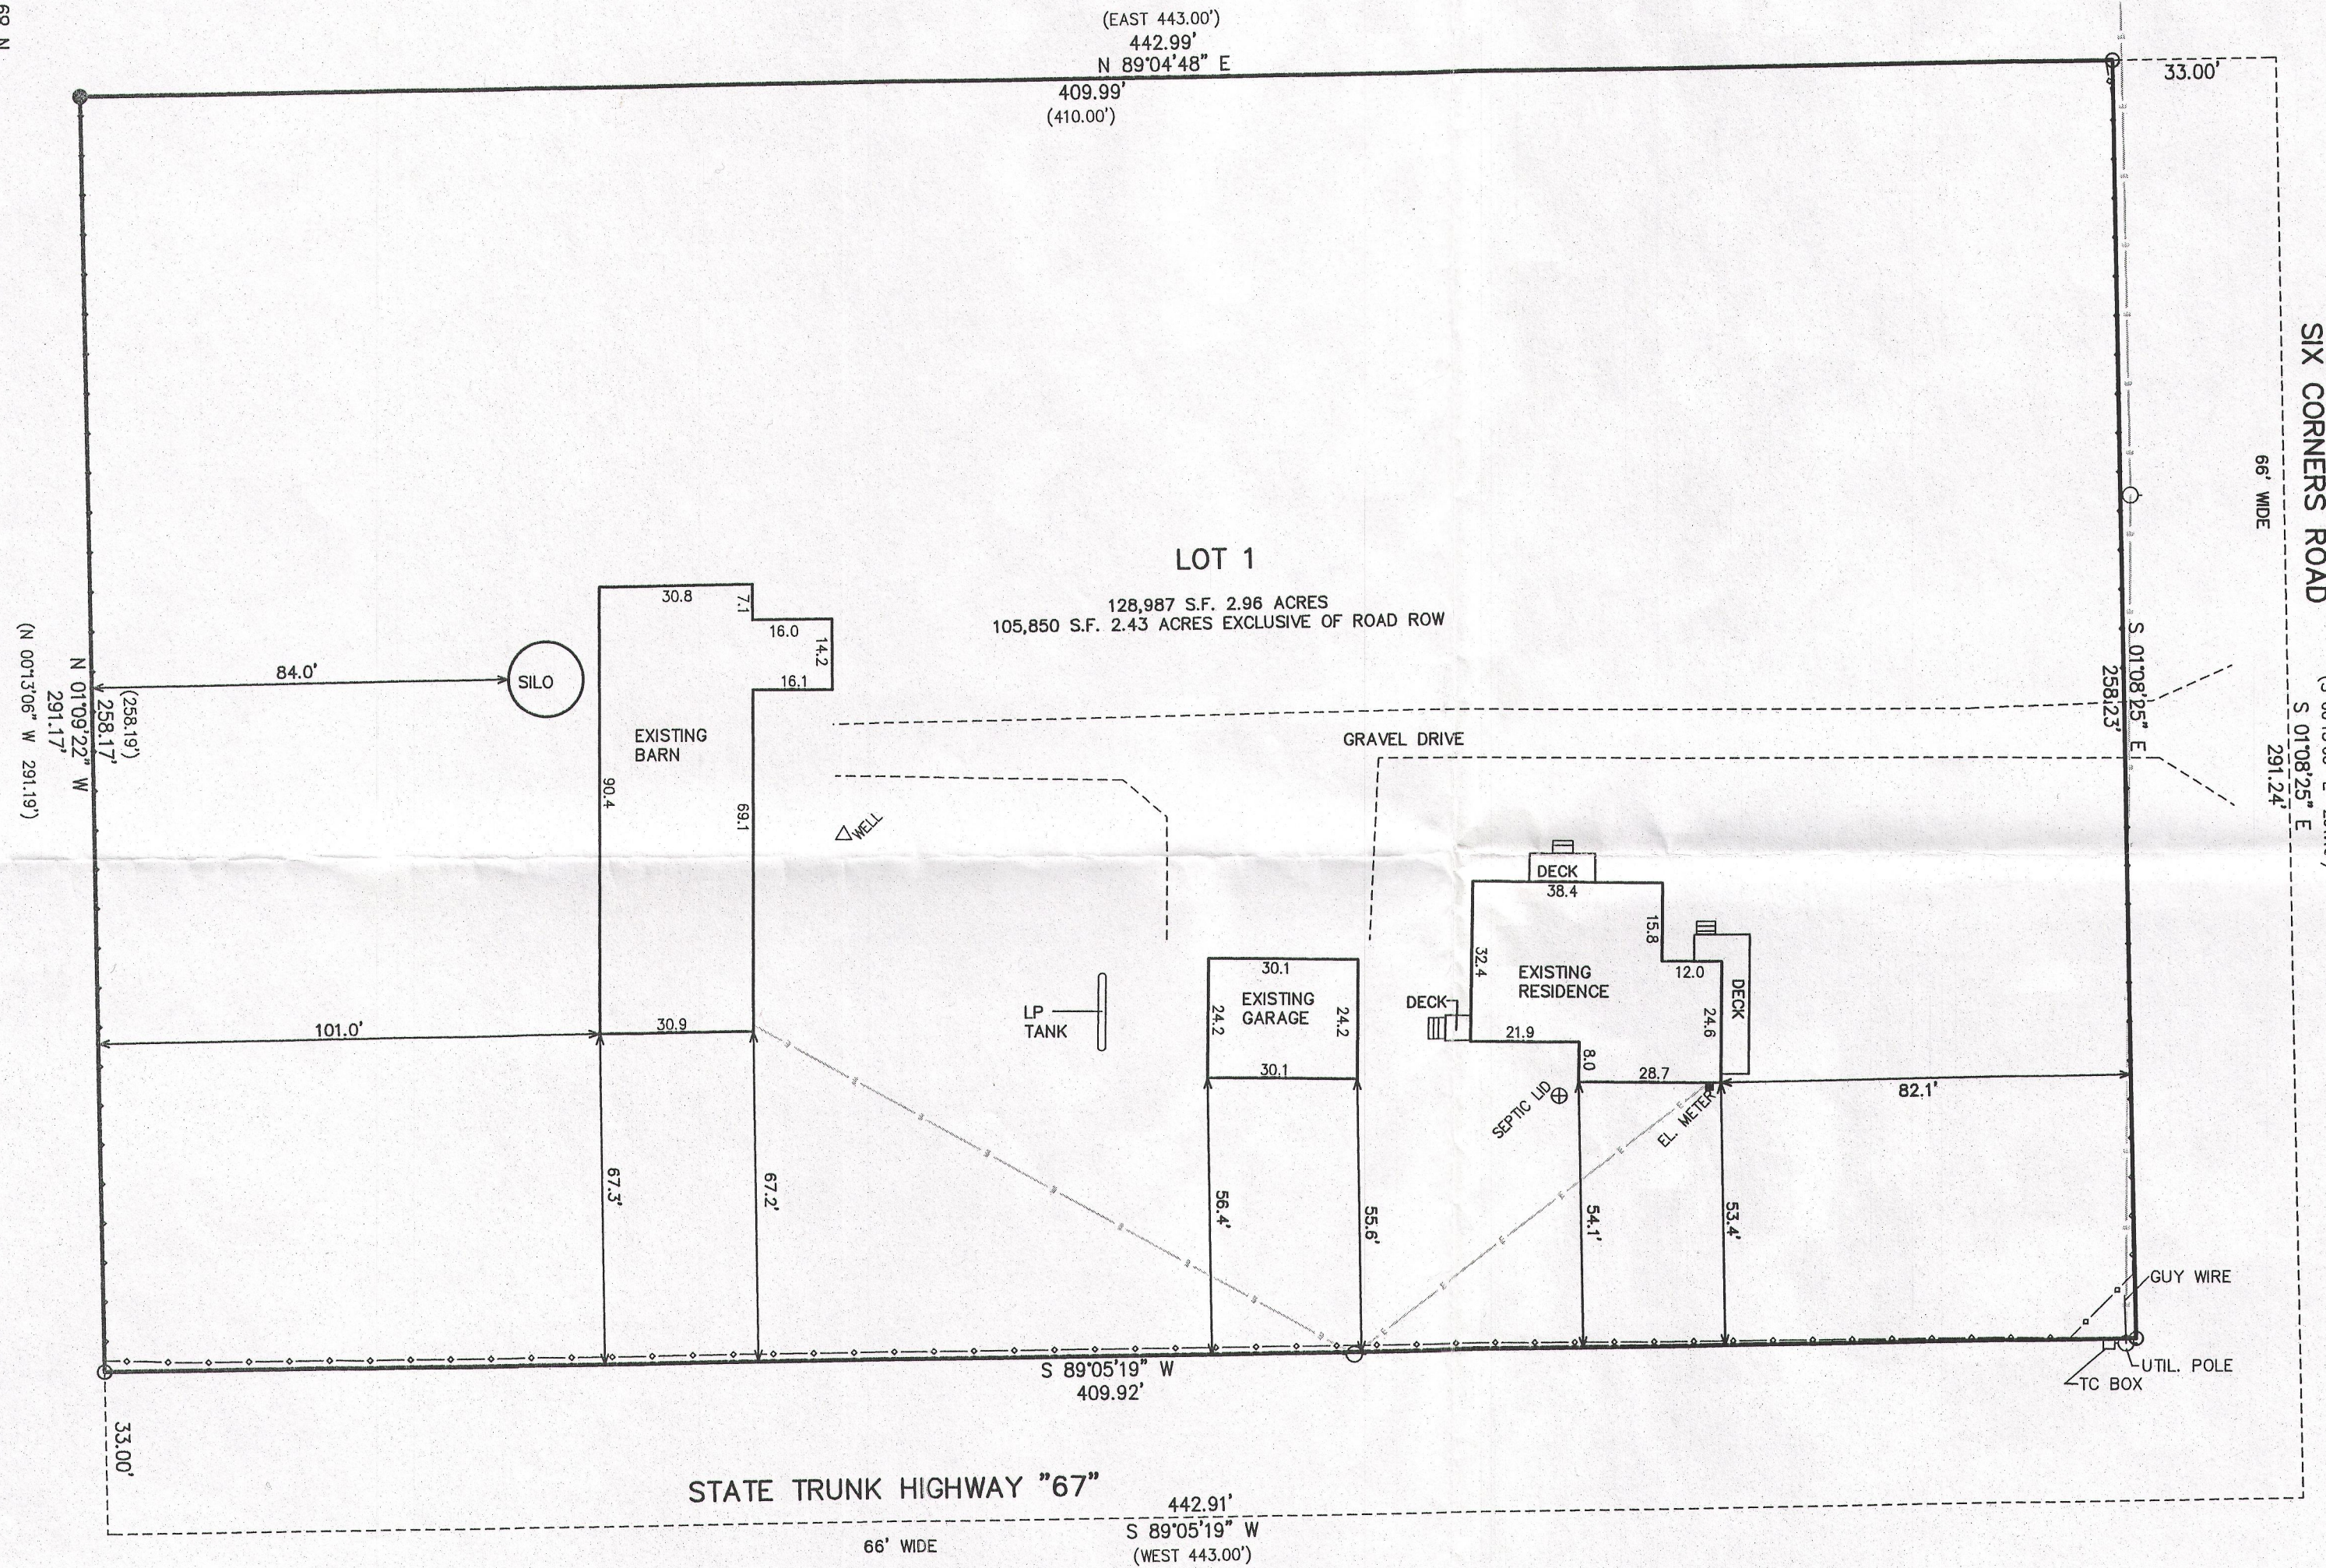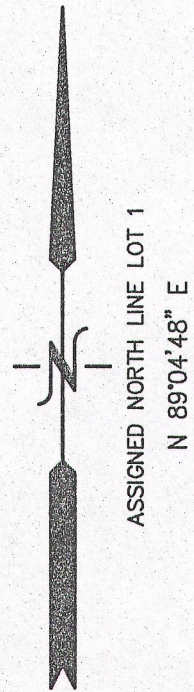

NOTE:
DOC. NO. 473933 ALLOWS FOR UTILITY
POLES AND ANCHORS ALONG HIGHWAY 67
WITH NO SPECIFIC WIDTH NOR LOCATION.

LEGEND
○ = FOUND IRON PIPE STAKE
● = FOUND IRON REBAR STAKE
(XXX) = RECORDED AS


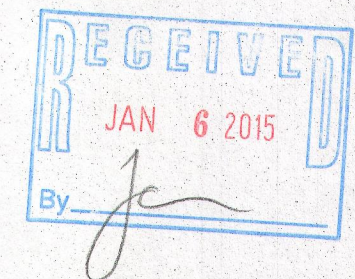


NOTE: COPIES OF THIS MAP TO WHICH THE FOLLOWING CERTIFICATE WILL APPLY SHOW THE SURVEYOR'S ORIGINAL SEAL AND SIGNATURE IN RED INK. COPIES BY ANY OTHER MEANS MAY HAVE ALTERATIONS WHICH DO NOT REPRESENT THE SURVEYOR'S WORK PRODUCT.

I HEREBY CERTIFY THAT THE ABOVE DESCRIBED PROPERTY HAS BEEN SURVEYED UNDER MY DIRECTION AND THAT THE ABOVE MAP IS A TRUE REPRESENTATION THEREOF AND SHOWS THE SIZE AND LOCATION OF THE PROPERTY, ITS EXTERIOR BOUNDARIES, THE LOCATION OF ALL VISIBLE STRUCTURES, AND DIMENSIONS OF ALL PRINCIPLE BUILDINGS THEREON, BOUNDARY FENCES, APPARENT EASEMENTS, ROADWAYS, AND VISIBLE ENCROACHMENTS, IF ANY. THIS SURVEY IS MADE FOR THE USE OF THE PRESENT OWNERS OF THE PROPERTY, AND ALSO THOSE WHO PURCHASE, MORTGAGE, OR GUARANTEE THE TITLE THERETO WITHIN ONE YEAR FROM THE DATE HEREOF.

DATED: DECEMBER 23, 2014

Peter S. Gordon
PETER S. GORDON

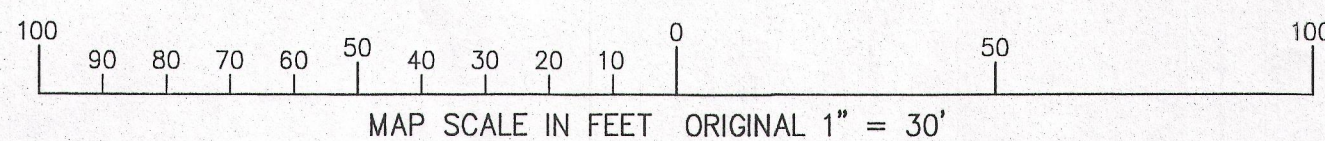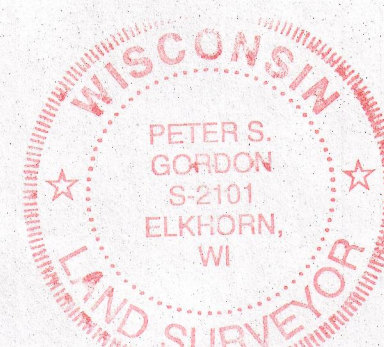

EA1770-1 116-960