


DUNHAM SURVEYING, S.C.
SURVEYING & SUBDIVIDING
DELAVAN, WISCONSIN 53115

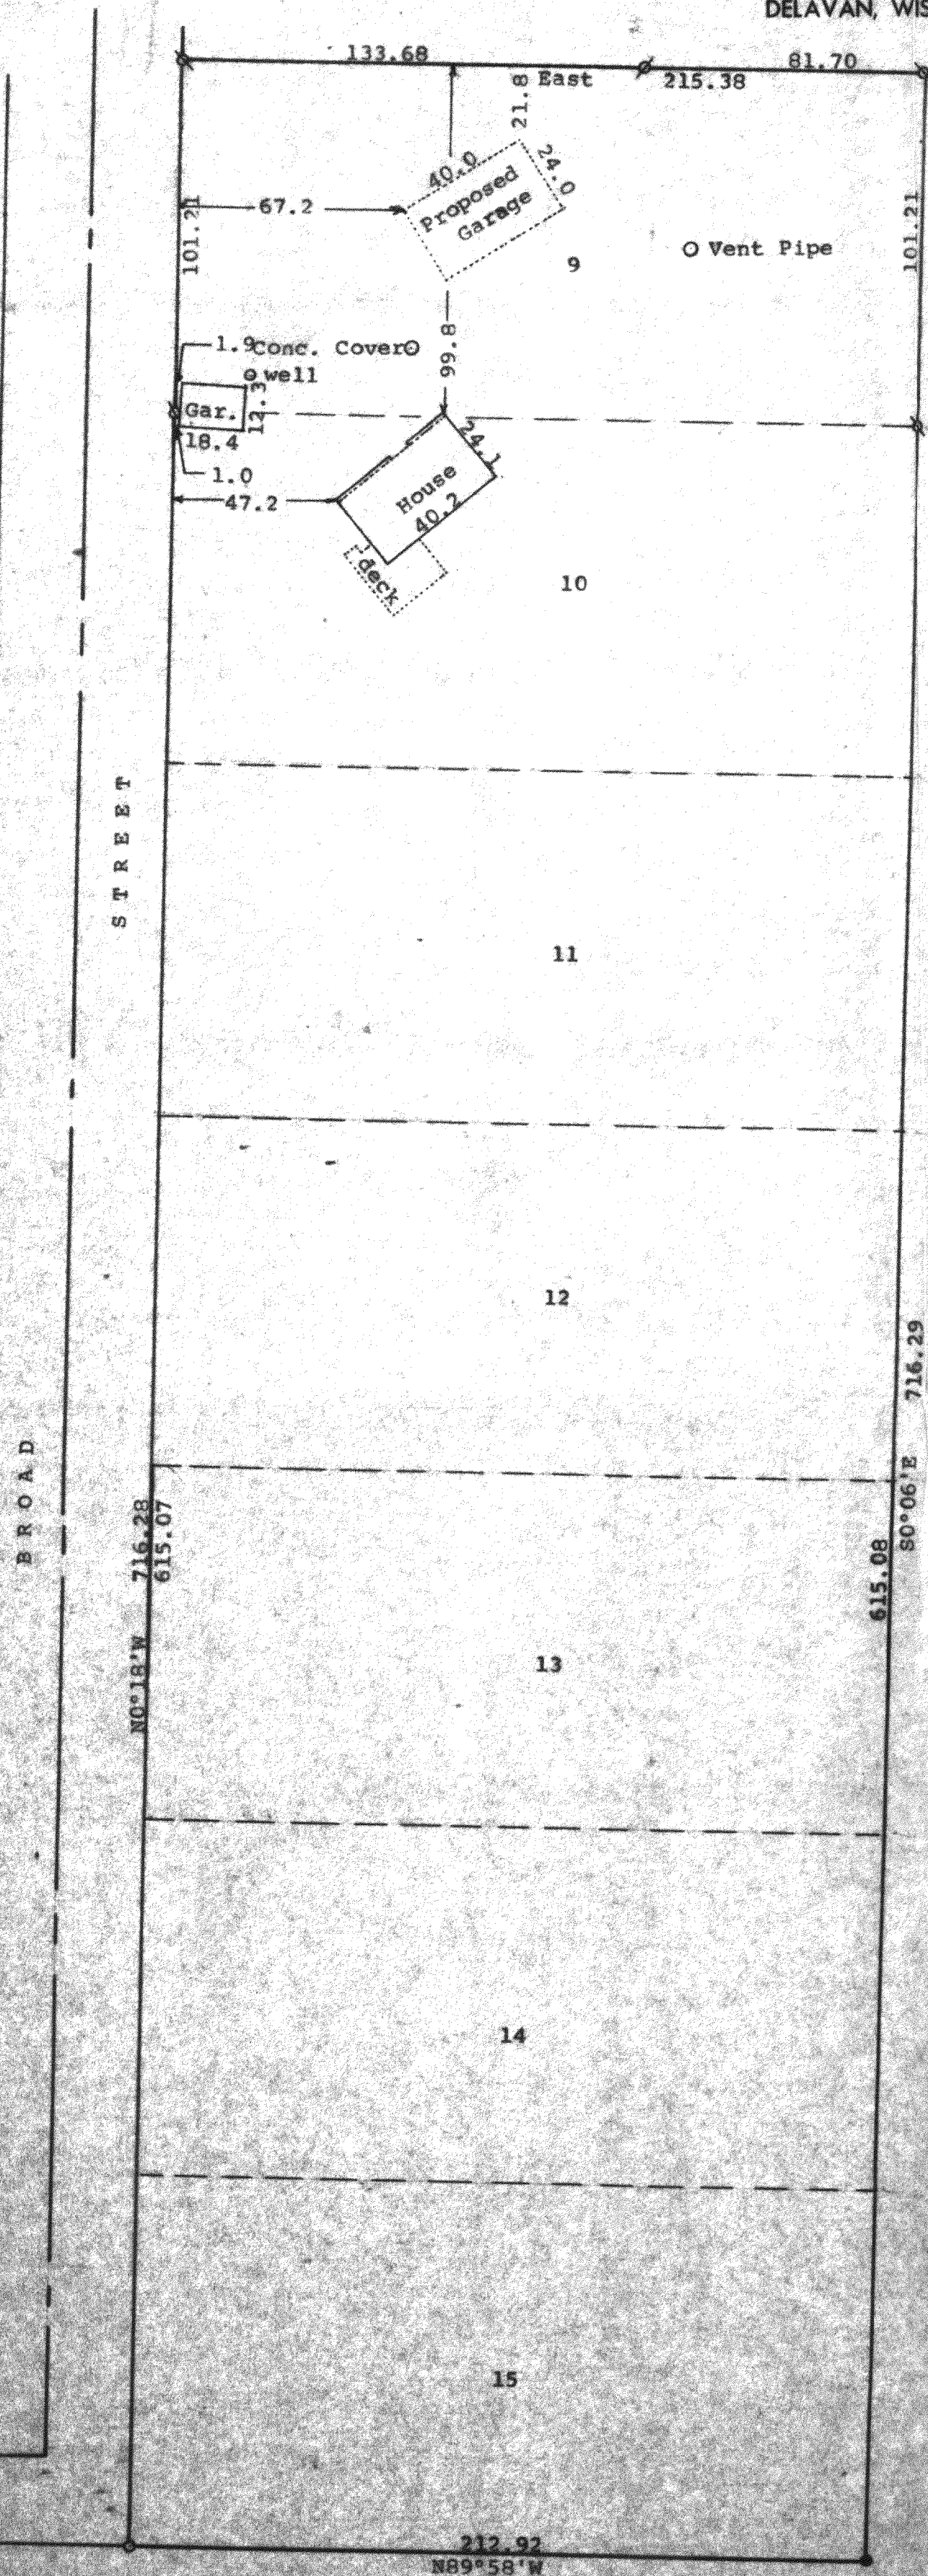

Scale - 1" = 40'

● = 2" Iron Pipe Found

○ = 1" Iron Pipe Found

○ = 1 1/4" X 30" Iron Pipe Set

Bearings shown are those on the recorded plat of
Addition No. 1 to Robbins Subdivision
Survey ordered by: James Mohr

R. 4, Box 362

Delavan, WI 53115



Ø = 3/4" Iron Pipe Set

STATE OF WISCONSIN)
COUNTY OF WALWORTH) SS

I, George T. Dunham, Surveyor, certify that I have surveyed the
property described as:

Lots 9-15 inclusive in Addition No. 1 to Robbins Subdivision,
located in Section 5, T 1 N, R 16 E, Walworth County, Wisconsin,
and that the plat shown hereon is a correct representation thereof and shows
the size and location of the property, its exterior boundaries, the location
of all visible structures and dimensions of all principal buildings thereon,
boundary fences, apparent easements, roadways and visible encroachments, if
any, and that I have surveyed the property hereon described, according to the
official records, to the best of my knowledge and belief.
July 2, 1991

George T. Dunham
George T. Dunham, Surveyor

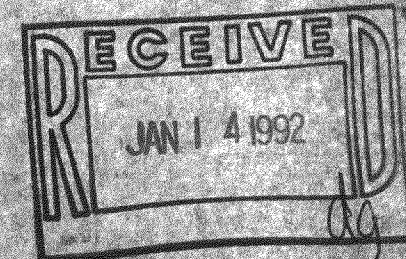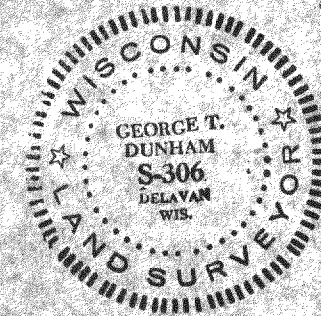

ERA-9
ERA-10
ERA-11
ERA-12
ERA-13
ERA-14
ERA-15