


PLAT OF SURVEY

-OF-

LOT 1 CERTIFIED SURVEY MAP NO. 4260, LOCATED IN THE
SOUTHEAST 1/4 OF THE SOUTHEAST 1/4 OF SECTION 35,
TOWN 1 NORTH, RANGE 16 EAST, WALWORTH COUNTY, WISCONSIN.

KROTT SURVEYING INC.

N3705 WILLOW BEND LANE
LAKE GENEVA WI. 53147
PHONE # (262)248-3697
FAX # (262)249-0639

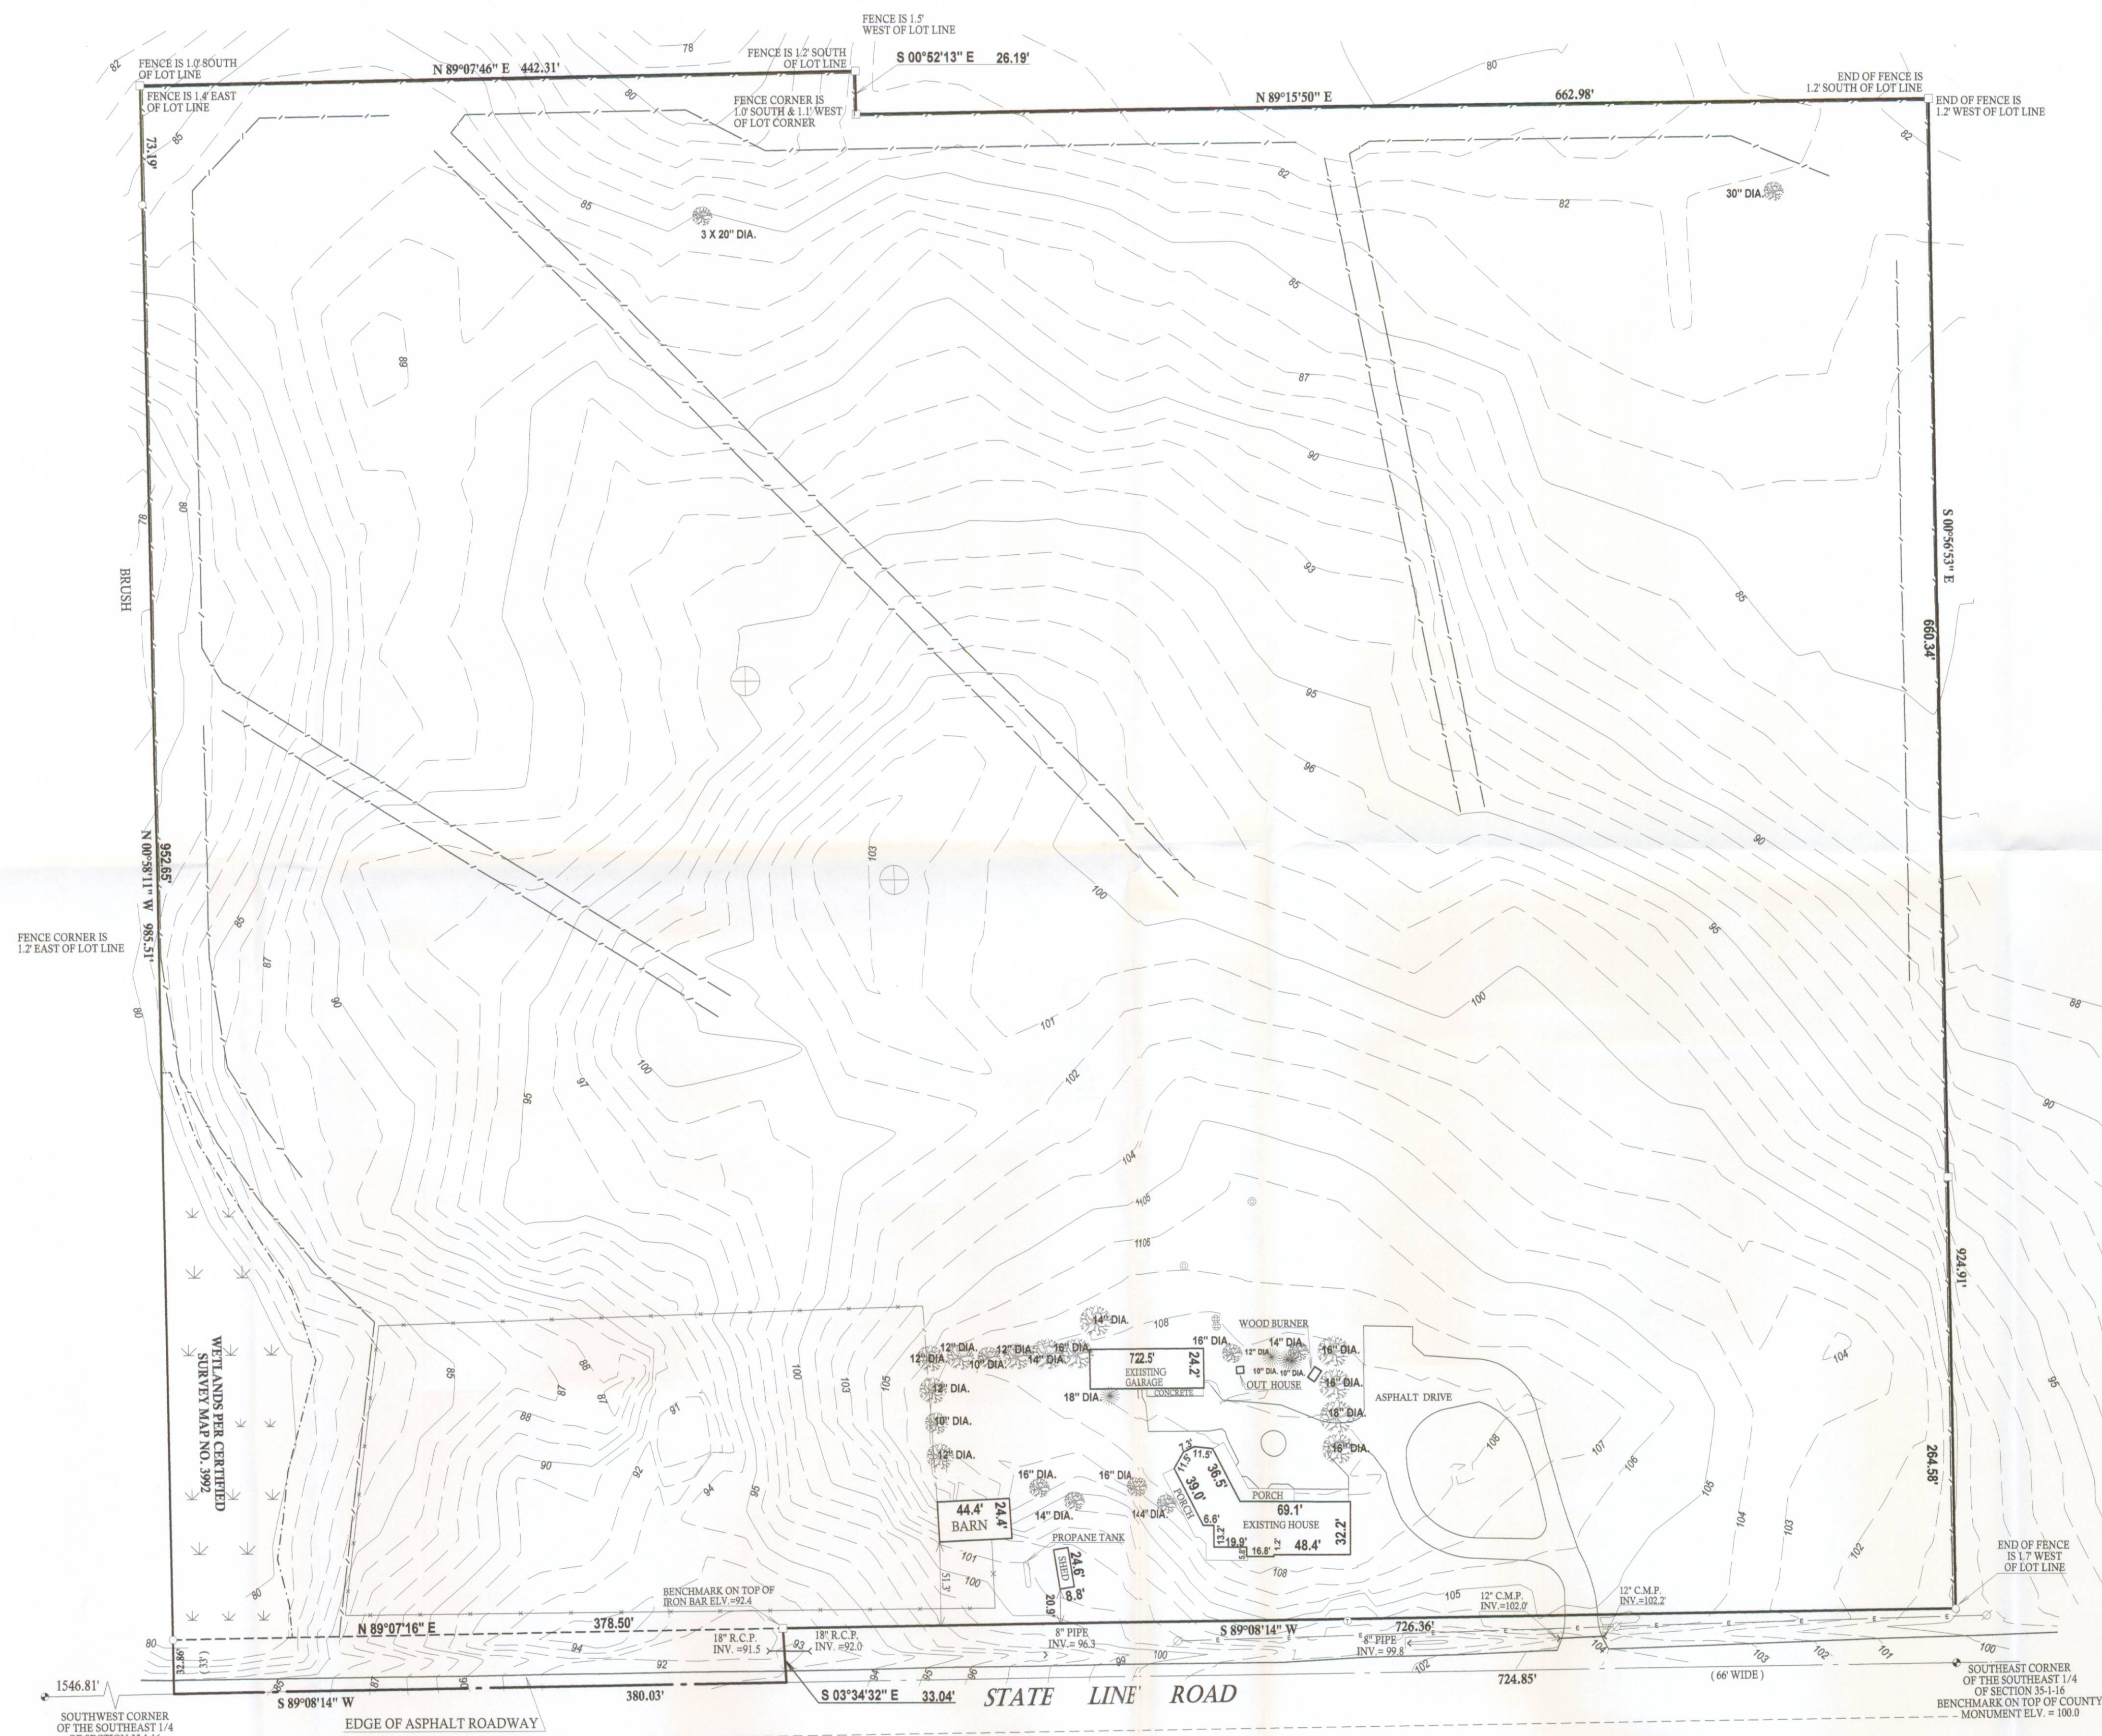

LEGEND

- FOUND 1" DIA. IRON PIPE
 - FOUND 3/4" DIA. IRON BAR
 - ✦ FOUND 6" X 9" CONCRETE MONUMENT WITH BRASS CAP
 - CONCRETE SEPTIC LID
 - ⊕ WIND TURBINE
 - 🌳 DECIDUOUS TREE
 - ☀ CONIFER TREE
 - 4" PVC PIPE
 - FENCE
 - WIRE FENCE
 - TELEPHONE PEDESTAL
 - ⊗ UTILITY POLE
 - OVERHEAD WIRES
- 000 RECORDED AS
 TAX ID # EA426000001
 JOB # 08-082TP



SCALE 1" = 60'

A horizontal scale bar with alternating black and white segments. The segments are labeled 0, 60, 120, 180, 240, and 300. Above the bar, a north arrow points upwards and is labeled 'S'.

I have surveyed the above-described property and the above map is a true representation thereof and shows the size and location of the property, its exterior boundaries, the location and dimensions of all structures thereon, fences, apparent easements and roadways and visible encroachments, if any.

This survey is made for the exclusive use of the present owners of the property, and also those who purchase, mortgage, or insure the title thereto within one (1) year from date hereof; and as to them I warrant the accuracy of said survey map.

NOTE : BEARINGS REFERENCED TO THE RECORD C.S.M.



JOHN KROTT S - 2258
Wisconsin Registered Land Surveyor
(original if signed in red)

DATED THIS 2nd DAY OF DECEMBER 2009.

116-853