PLAT OF SURVEY

LOT 2 OF CERTIFIED SURVEY MAP NO. 2848

LOCATED IN PART OF THE NE 1/4 OF THE NE 1/4 OF SECTION 27,
TOWN 1 NORTH, RANGE 16 EAST, WALWORTH COUNTY, WISCONSIN

BEARINGS PER CSM 2848

NOTE: COPIES OF THIS MAP TO WHICH THE FOLLOWING CERTIFICATE WILL APPLY SHOW THE SURVEYOR'S ORIGINAL SEAL AND SIGNATURE IN RED INK. COPIES BY ANY OTHER MEANS MAY HAVE ALTERATIONS WHICH DO NOT REPRESENT THE SURVEYOR'S WORK PRODUCT.

I HEREBY CERTIFY THAT THE ABOVE DESCRIBED PROPERTY HAS BEEN SURVEYED UNDER MY DIRECTION AND THAT THE ABOVE MAP IS A TRUE REPRESENTATION THEREOF AND SHOWS THE SIZE AND LOCATION OF THE PROPERTY AND ITS EXTERIOR BOUNDARIES. THIS SURVEY IS MADE FOR THE USE OF THE PRESENT OWNERS OF THE PROPERTY, AND ALSO THOSE WHO PURCHASE, MORTGAGE, OR GUARANTEE THE TITLE THERETO WITHIN ONE YEAR FROM THE DATE HEREOF.

DATED: MARCH 4, 1997

PETER S. GORDON R.L.S. 2101

WISCONSIN PETER S. GORDON S-2101 ELKHORN, WI LAND SURVEYOR

REVISED 8/30/2011–KB
TO SHOW IMPROVEMENTS & SIZE AND LOCATION OF PROPOSED SHED

REVISED 11–01–2011 TO SHOW SIZE & LOCATION OF AS BUILT SHED

REVISED 6/19/2013–KB
TO SHOW SIZE & LOCATION OF PROPOSED BARN

REVISED 8/27/2013–KB
TO SHOW SIZE & LOCATION OF AS–BUILT BUILDING

RECEIVED SEP 1 1 2013 By

LEGEND
● = IRON REBAR STAKE FOUND
{XXX} = RECORDED AS

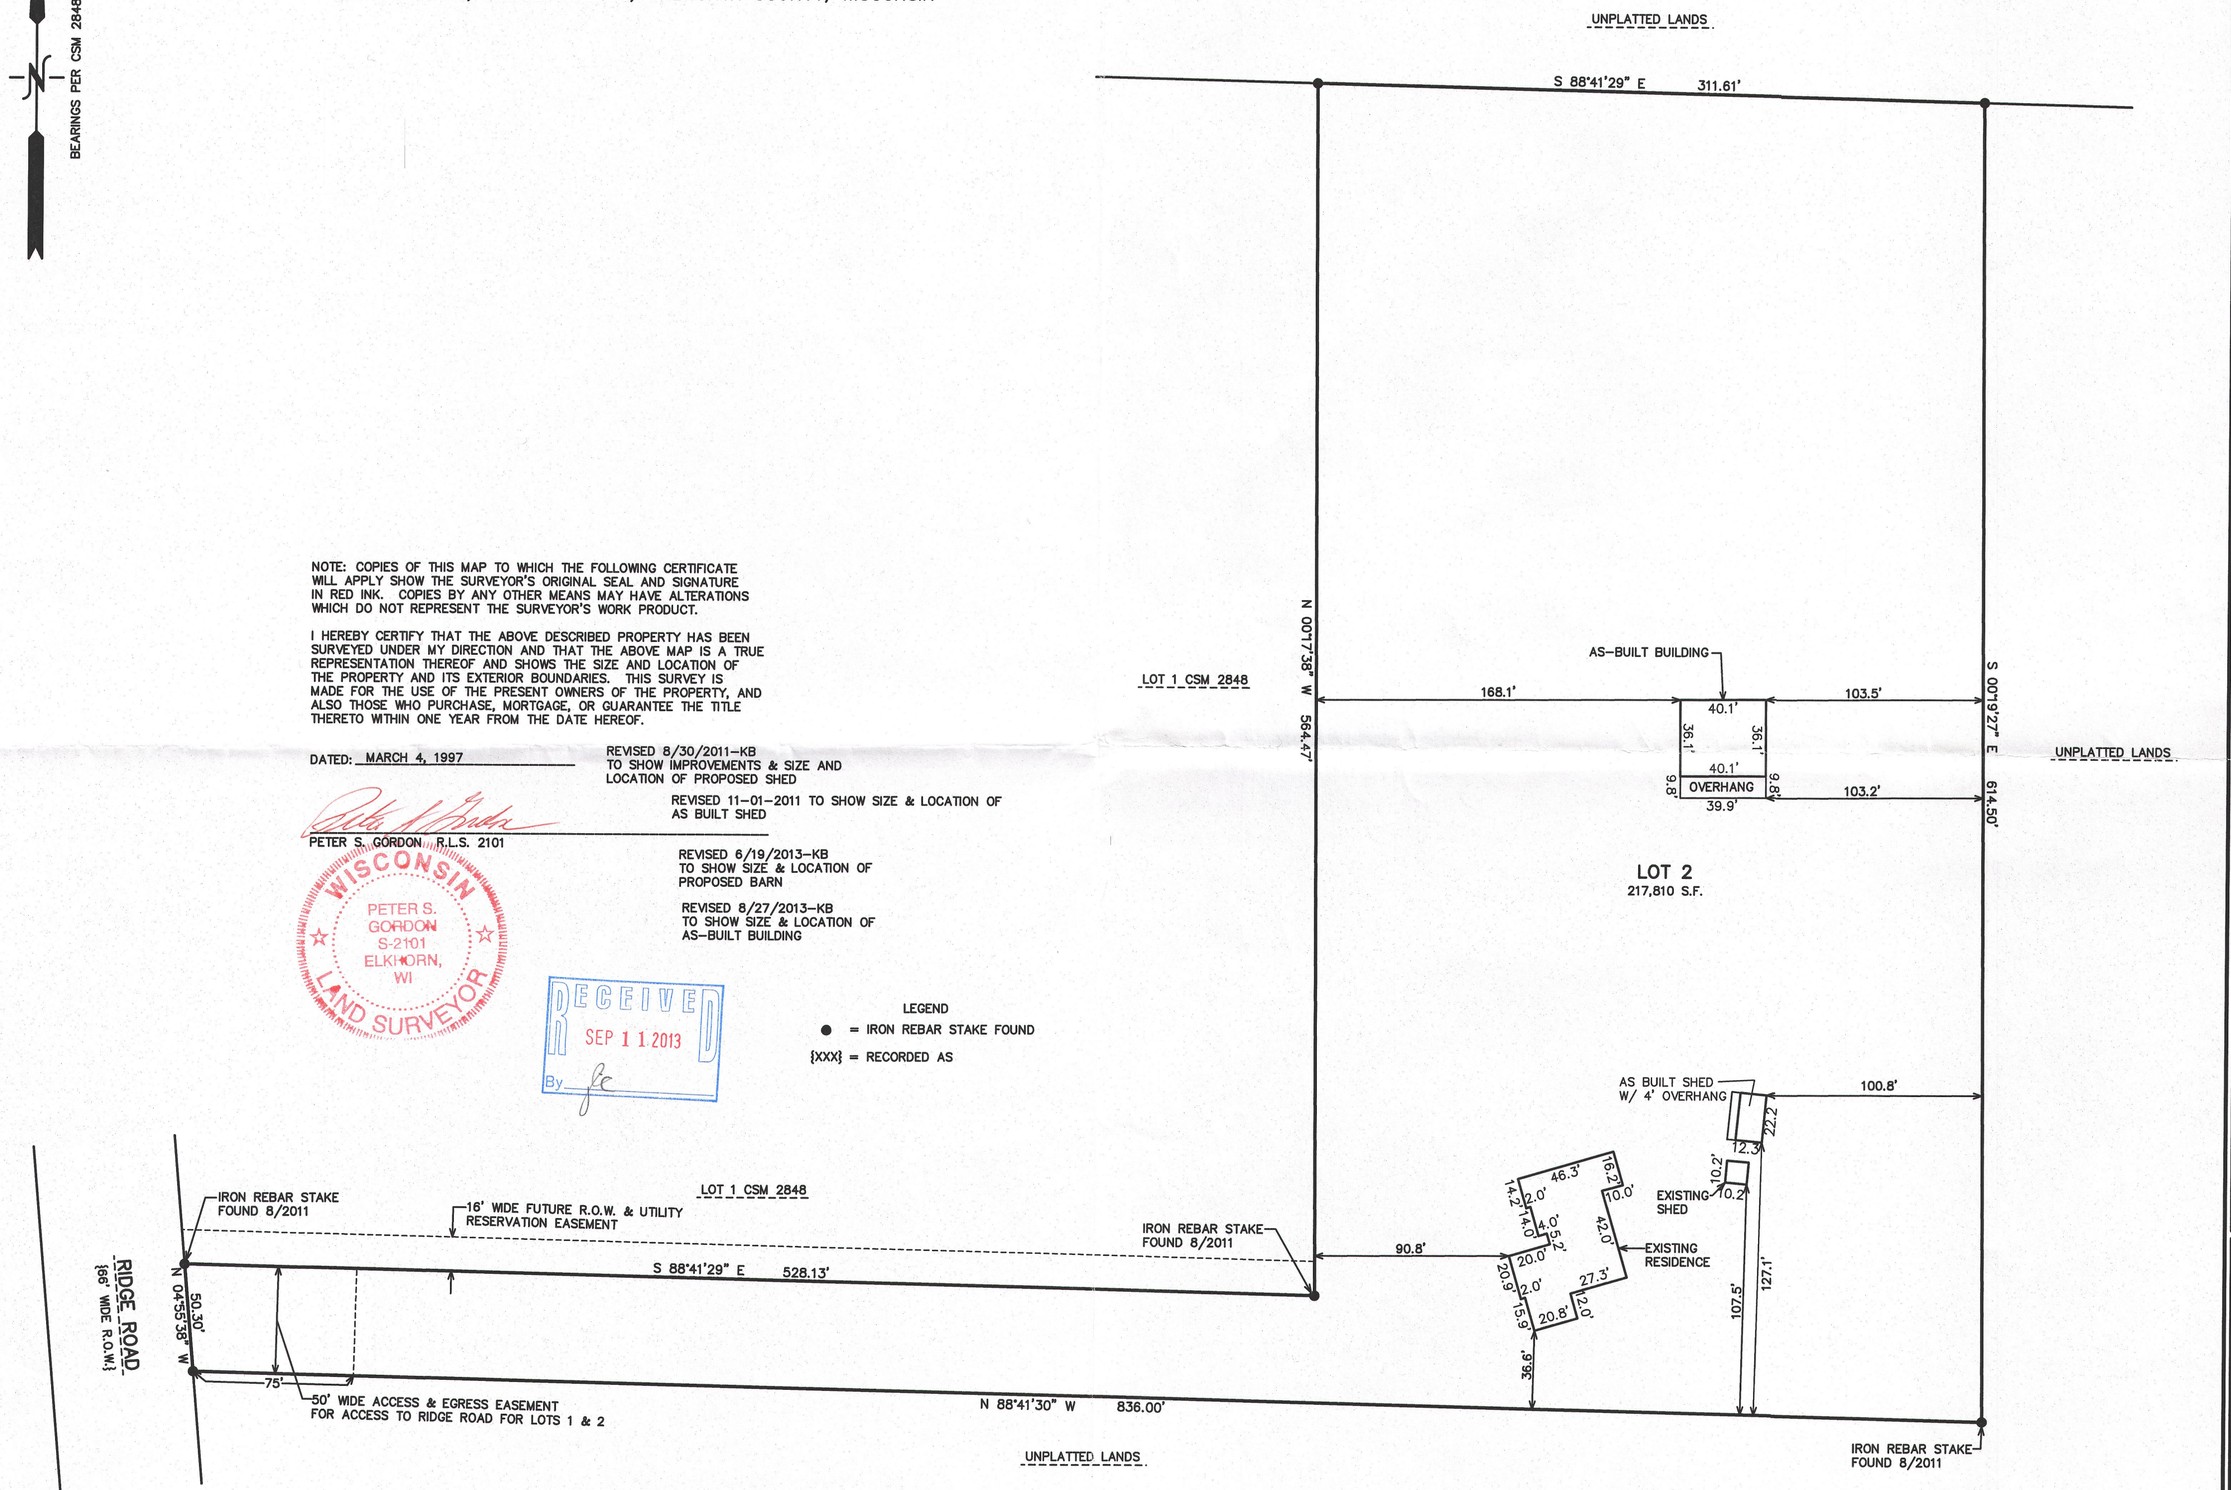

100 90 80 70 60 50 40 30 20 10 0 50 100
MAP SCALE IN FEET ORIGINAL 1" = 50'

8/27/2013 X:\Projects\4703\4703.02\Dcad\PERMIT_20110830

– WORK ORDERED BY –
LEE & ELLEN CHRISTENSEN
N852 RIDGE ROAD
WALWORTH, WI 53184

FARRIS, HANSEN & ASSOCIATES, INC.
ENGINEERING – ARCHITECTURE – SURVEYING
7 RIDGWAY COURT P.O. BOX 437
ELKHORN, WISCONSIN 53121
OFFICE: (262) 723–2098 FAX: (262) 723–5886

REVISIONS

PROJECT NO. 4703.02
DATE: 8/30/2011
SHEET NO. 1 OF 1

EA2848—2

116-927