


Geneva Lake

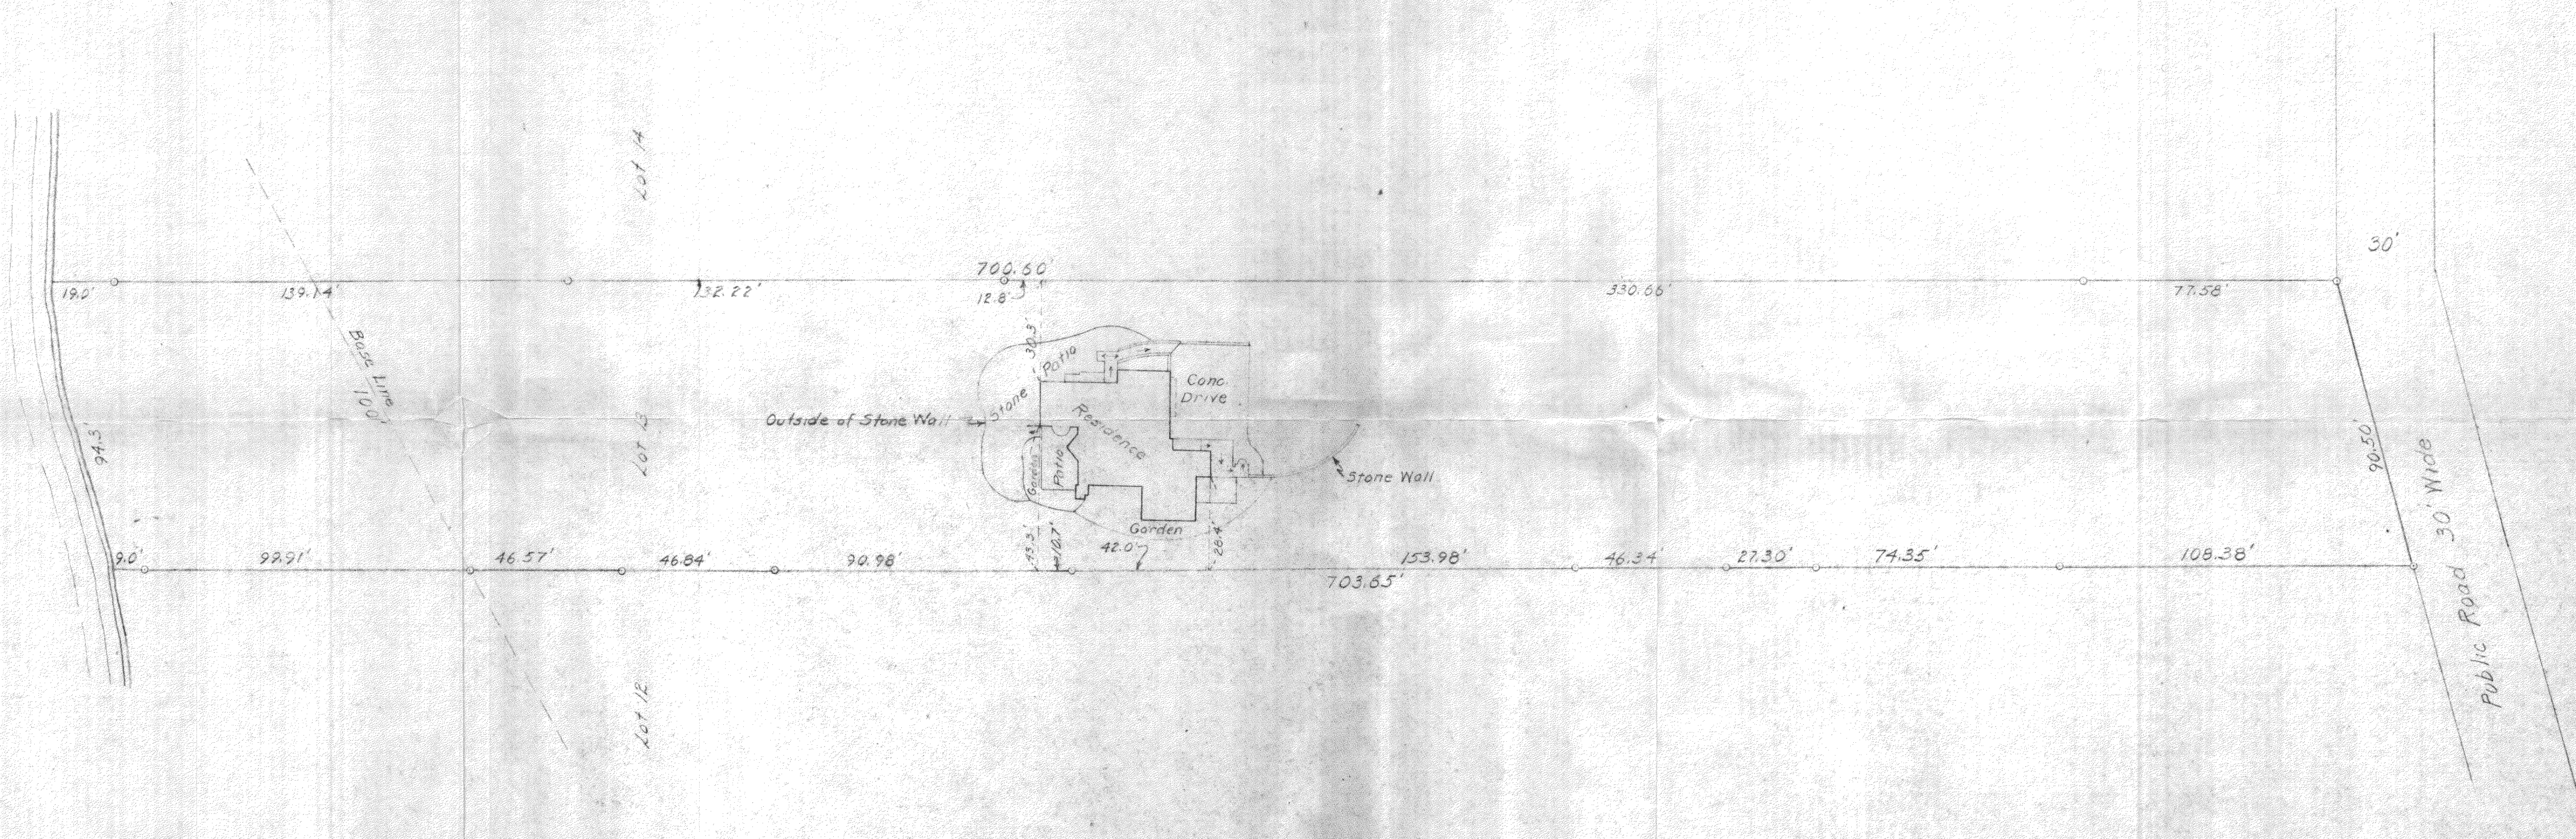

Legend
○ - Iron Pipe

Plat of Survey of Lot 13 of The Birches, located in T1N, R17E, Wainworth County, Wisconsin.		
DRAWN BY HK	JENSEN & JOHNSON CIVIL ENGINEERS ELKHORN, WIS. DATE Nov. 1959	SCALE: 1" = 30'
CHECKED BY [Signature]		REVISED
APPROVED BY		SHEET NO. OF