


DUNHAM SURVEYING, S.C.
SURVEYING & SUBDIVIDING
DELAVER, WISCONSIN 53115

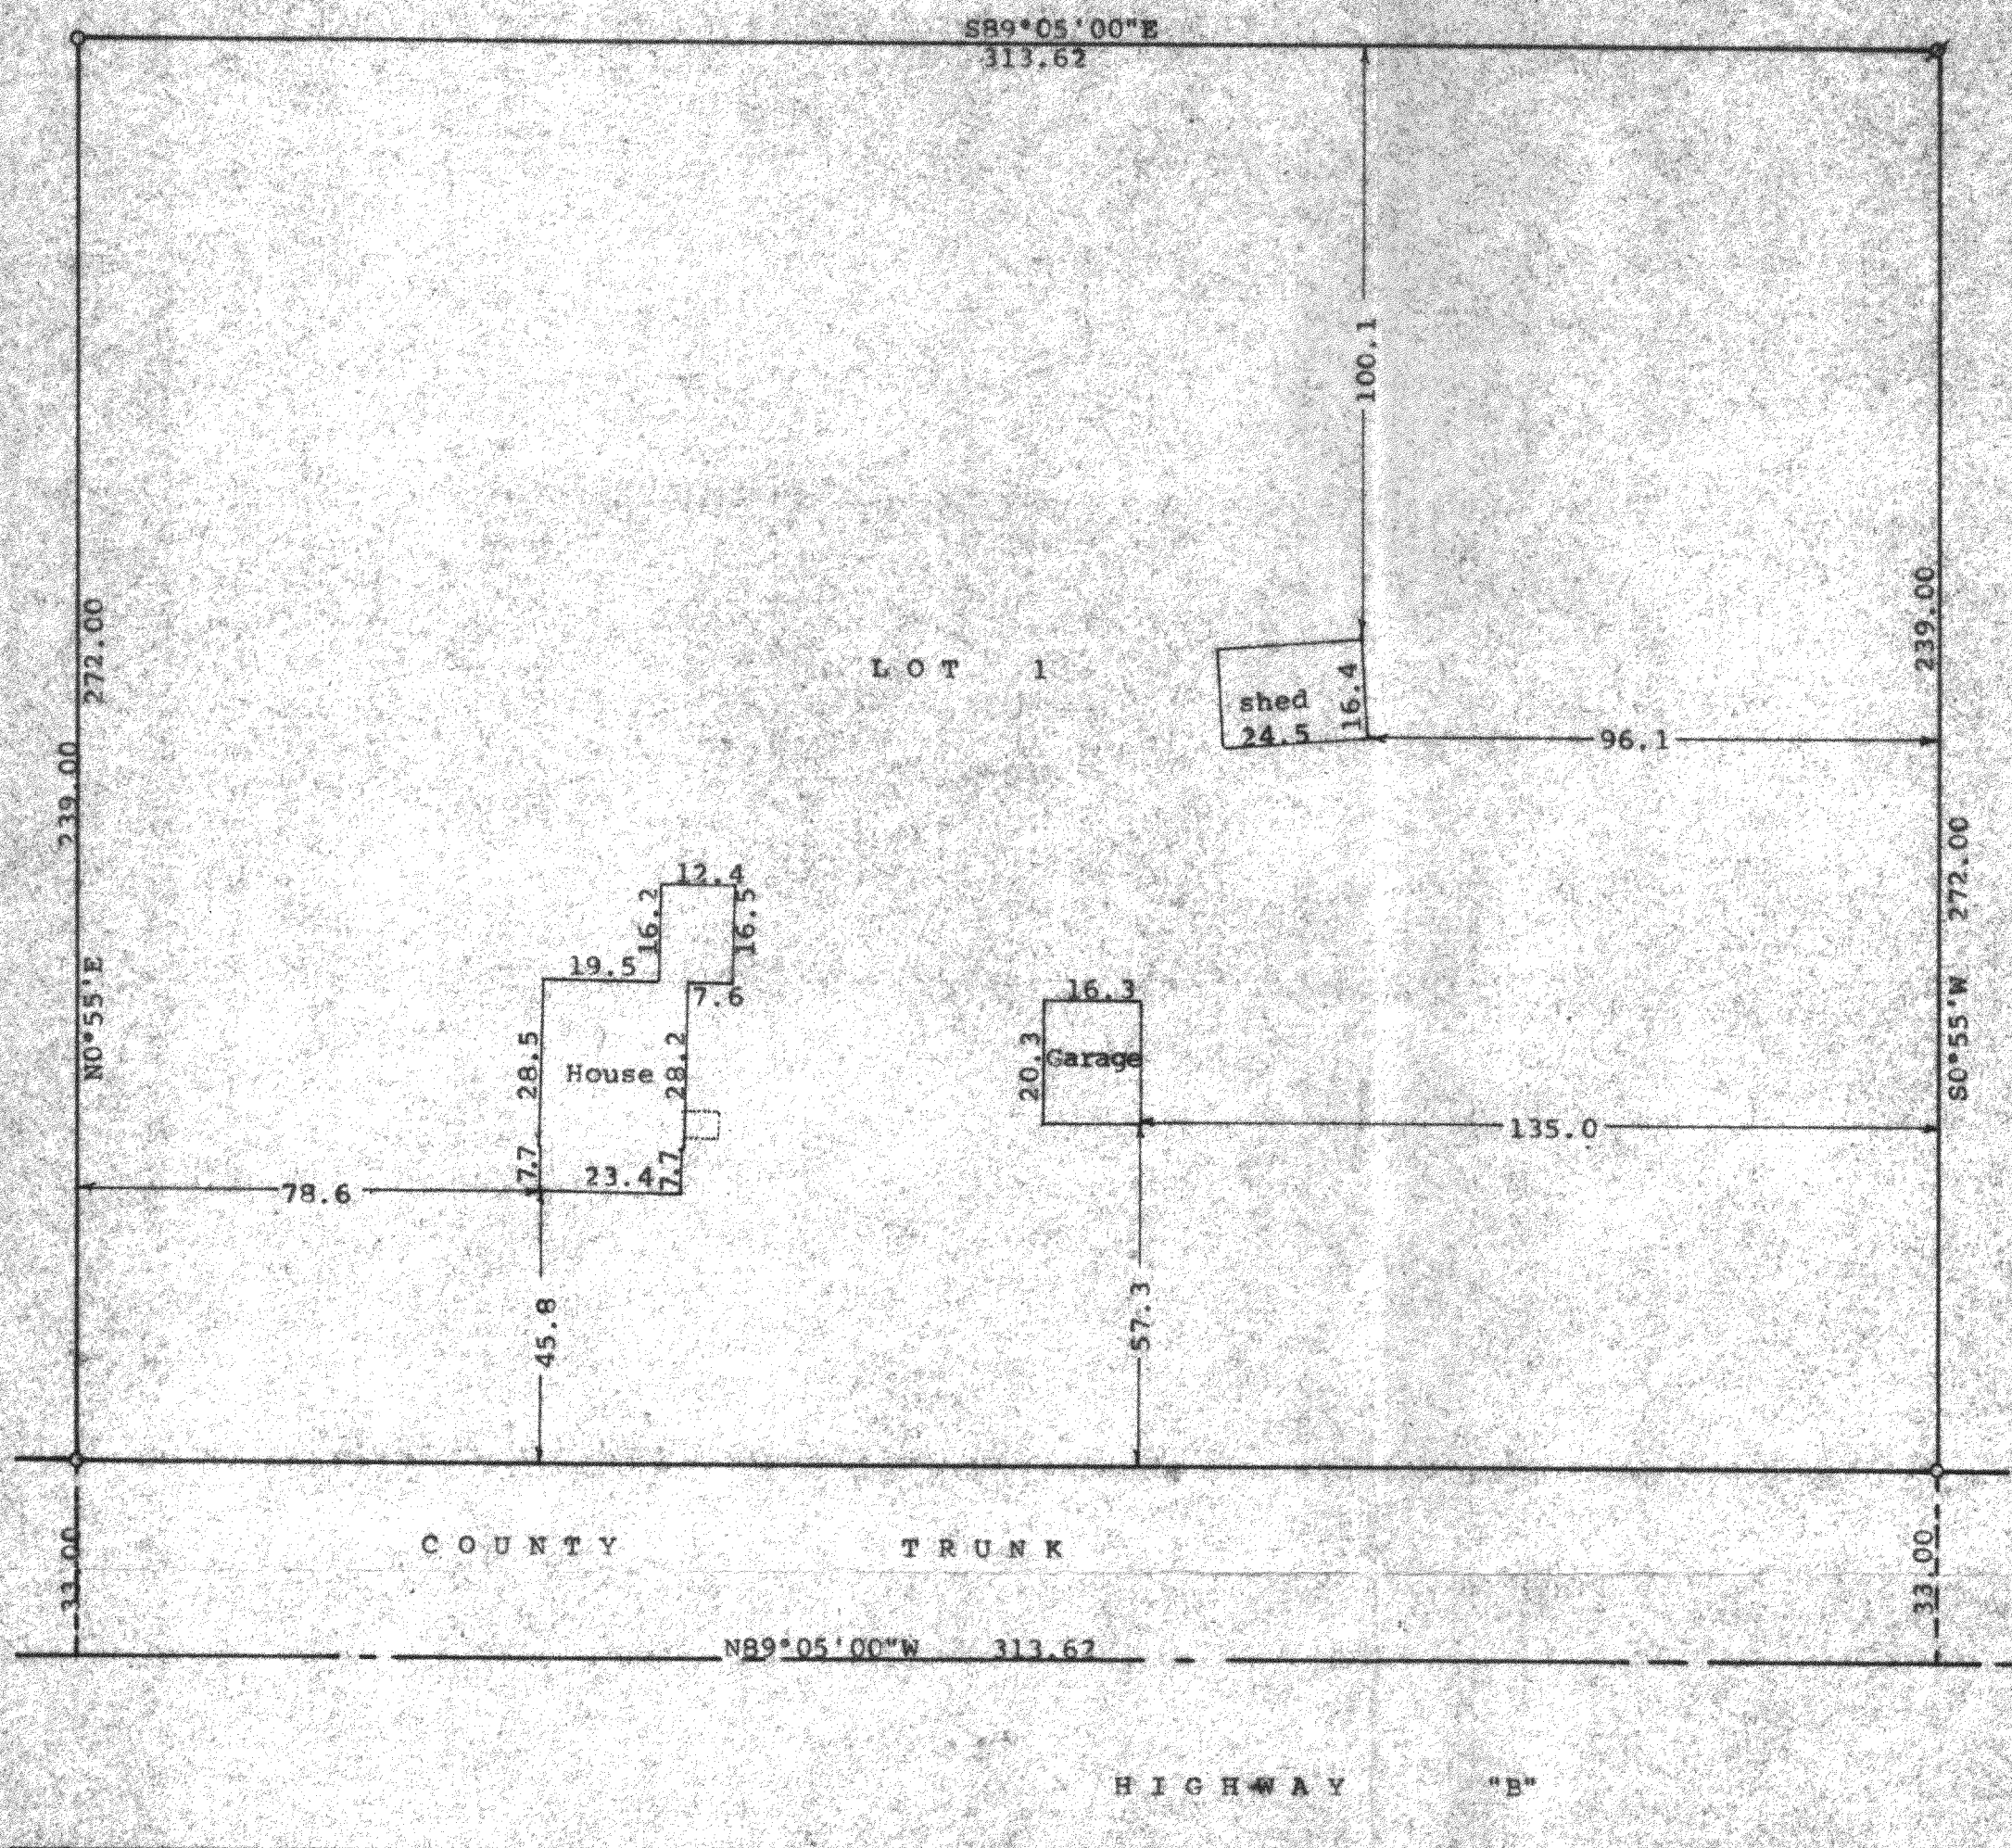

N

Scale - 1" = 30'

o = 1" Iron Pipe Found

Ø = Very crooked Iron Pipe Found.

Pulled and reset

Bearings on survey are those on the recorded plat of GSN No. 983

Survey ordered by:

RE-MAX GENEVA REALTY LTD

101 Broad Street

Lake Geneva, WI 53147

STATE OF WISCONSIN) SS
COUNTY OF WALWORTH)

I, George T. Dunham, Surveyor, certify that I have surveyed the property described as follows:

Lot 1 of Certified Survey No. 983, recorded in Volume 4 of Certified Surveys, on page 249, Document No. 53944, on Nov. 30, 1979, in the Office of the Register of Deeds, Walworth County, Wisconsin, being a parcel of land located in the Northeast 1/4 of Section 30, T 1 N, R 17 E, Walworth County, Wisconsin

and that the plat shown hereon is a correct representation thereof and shows the size and location of the property, its exterior boundaries, the location of all visible structures and dimensions of all principal buildings thereon, boundary fences, apparent easements, roadways and visible encroachments, if any, and that I have surveyed the property hereon described, according to the official records, to the best of my knowledge and belief.

September 3, 1996

George T. Dunham
George T. Dunham, Surveyor

