LAND-MARK SURVEYING
Mark L. Miritz
Wisconsin Registered Land Surveyor S-2582

N9330 Knuteson Drive
Whitewater, WI 53190
Phone:(262)495-3284
FAX : (262) 495-8421
LAND-MARKSURVEYING.COM

LOTS 46 AND 47 OF LAKE GENEVA BEACH SUBDIVISION, LOCATED IN PART OF GOVERNMENT LOT 4 IN SECTION 11, TOWN 1 NORTH, RANGE 17 EAST, LINN TOWNSHIP, WALWORTH COUNTY, WISCONSIN

PLAT OF SURVEY

ORDERED BY:
SCHAUDER BUILDING, INC.
4115 U.S. HIGHWAY 51 NORTH
JANESVILLE, WI 53545-9674

OWNERS: JAMES & MARGARET MARREN

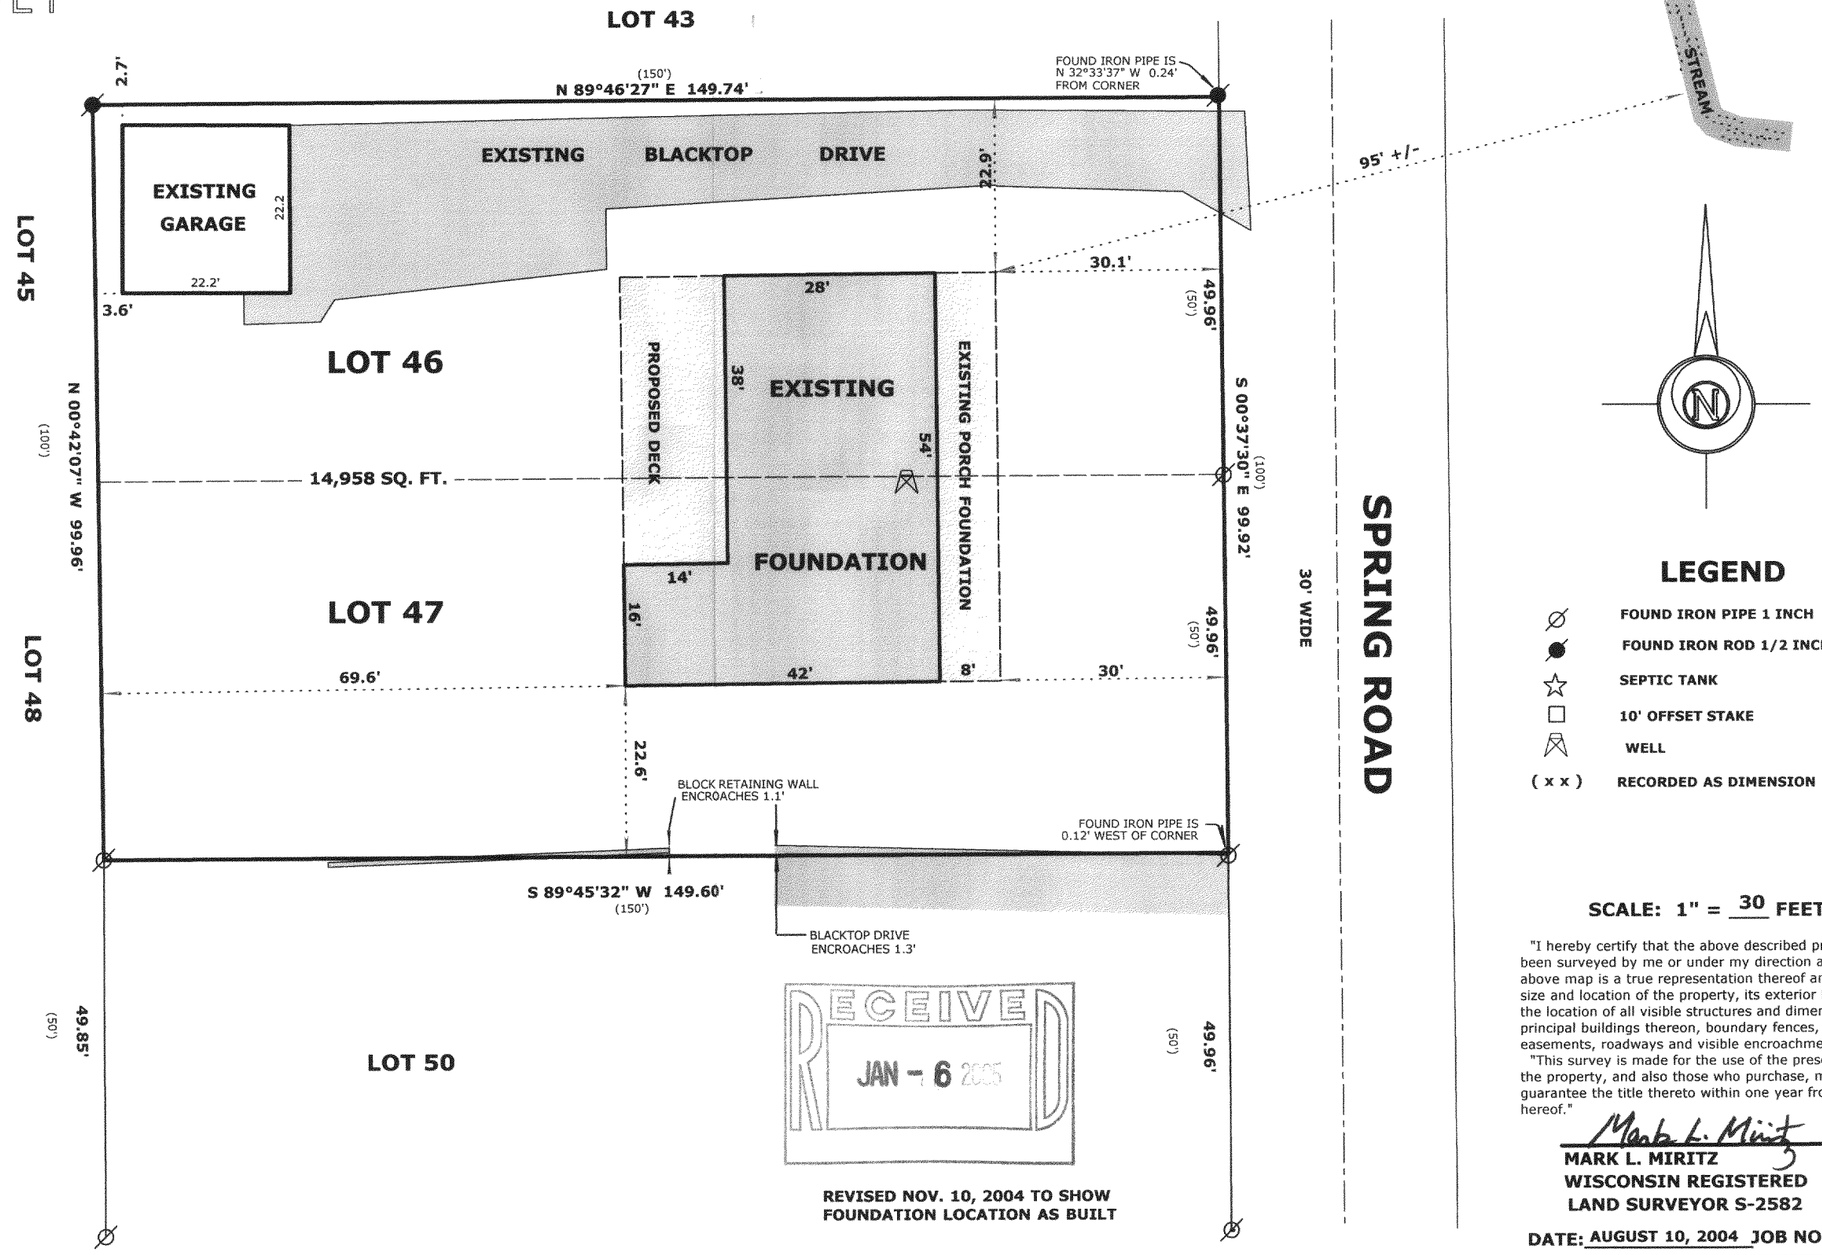

RECEIVED
JAN - 6 2005

REVISED NOV. 10, 2004 TO SHOW FOUNDATION LOCATION AS BUILT

WISCONSIN
MARK L. MIRITZ
S-2582
WHITEWATER, WI
LAND SURVEYOR

LEGEND

- FOUND IRON PIPE 1 INCH
- FOUND IRON ROD 1/2 INCH
- SEPTIC TANK
- 10' OFFSET STAKE
- WELL
- (x x) RECORDED AS DIMENSION

SCALE: 1" = 30 FEET

"I hereby certify that the above described property has been surveyed by me or under my direction and that the above map is a true representation thereof and shows the size and location of the property, its exterior boundaries, the location of all visible structures and dimensions of all principal buildings thereon, boundary fences, apparent easements, roadways and visible encroachments, if any."
"This survey is made for the use of the present owners of the property, and also those who purchase, mortgage, or guarantee the title thereto within one year from date hereof."

Mark L. Miritz

MARK L. MIRITZ
WISCONSIN REGISTERED LAND SURVEYOR S-2582

DATE: AUGUST 10, 2004 JOB NO. 04.804

ILGB-41

117-2501