PLAT OF SURVEY

BUILDING PERMIT PLAT

UNIT 2
SOUTH SHORE CLUB ON LAKE GENEVA
A CONDOMINIUM
REC. IN CAB. A, SLIDE 394, DOC. NO. 500527

LOCATED IN CERTIFIED SURVEY MAP 2631
RECORDED IN VOL. 13 OF CERTIFIED SURVEYS
ON PAGE 171, AS DOCUMENT NUMBER 311927
BEING IN ALL 1/4'S OF NE 1/4 OF
SECTION 18, TOWN 1 NORTH, RANGE 17 EAST
WALWORTH COUNTY, WISCONSIN

LEGEND

XXX = EXISTING CONTOURS
XXX = PROPOSED CONTOURS
= TREE TO BE REMOVED

F.F. = FIRST FLOOR ELEVATION
T.F. = TOP OF FOUNDATION ELEVATION
G.E. = GARAGE ENTRY ELEVATION
BASE = BASEMENT ELEVEMENT

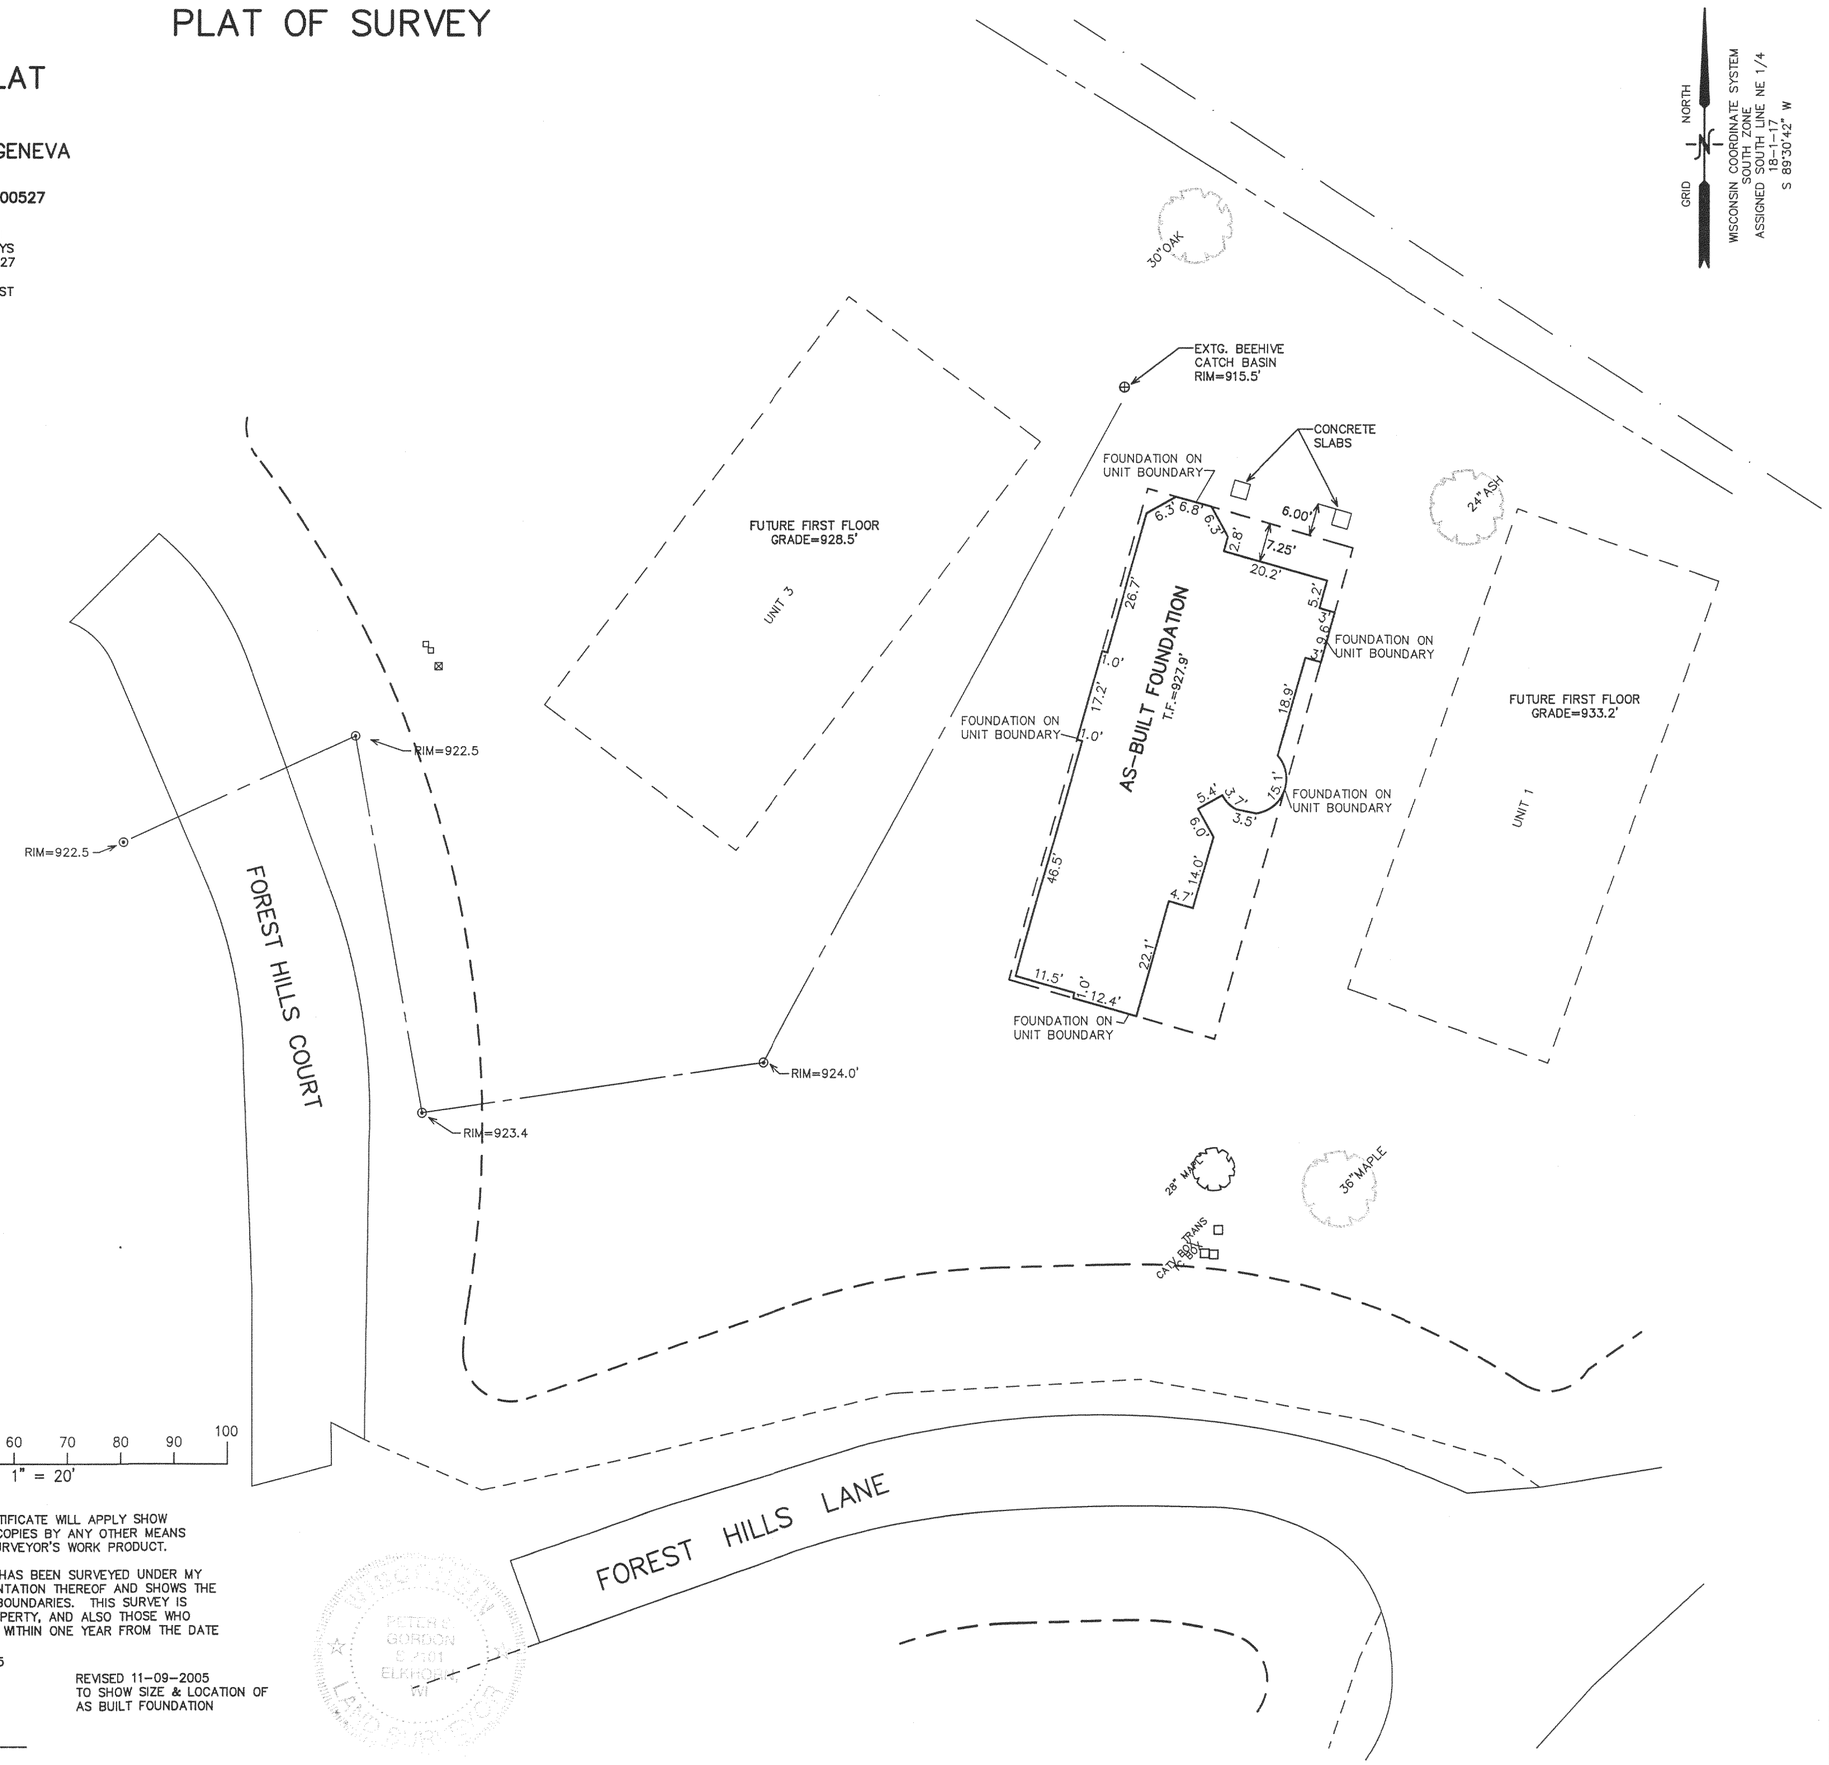

MAP SCALE IN FEET ORIGINAL 1" = 20'

NOTE: COPIES OF THIS MAP TO WHICH THE FOLLOWING CERTIFICATE WILL APPLY SHOW SURVEYOR'S ORIGINAL SEAL AND SIGNATURE IN RED INK. COPIES BY ANY OTHER MEANS MAY HAVE ALTERATIONS WHICH DO NOT REPRESENT THE SURVEYOR'S WORK PRODUCT.

I HEREBY CERTIFY THAT THE ABOVE DESCRIBED PROPERTY HAS BEEN SURVEYED UNDER MY DIRECTION AND THAT THE ABOVE MAP IS A TRUE REPRESENTATION THEREOF AND SHOWS THE SIZE AND LOCATION OF THE PROPERTY AND ITS EXTERIOR BOUNDARIES. THIS SURVEY IS MADE FOR THE USE OF THE PRESENT OWNERS OF THE PROPERTY, AND ALSO THOSE WHO PURCHASE, MORTGAGE, OR GUARANTEE THE TITLE THERETO WITHIN ONE YEAR FROM THE DATE HEREOF.

REVISED 10-03-2005

DATED: AUGUST 10, 2005

REVISED 11-09-2005
TO SHOW SIZE & LOCATION OF
AS BUILT FOUNDATION

PETER S. GORDON R.L.S. 2101

PETER S. GORDON S-2101 ELKHORN, WI LAND SURVEYOR

11/9/2005 X:\Projects\4161\NOV_LOTS\Lot_2\Dcad\AS-BUILT

NOV 09 2005

28

SMF

ISSC-2

117-2618

– WORK ORDERED BY –
TOM COWAN – GENE DARFLER, INC.
506 EAST HIGHLAND AVENUE
NAPERVILLE, IL 60540

FARRIS, HANSEN & ASSOCIATES, INC.
ENGINEERING – ARCHITECTURE – SURVEYING
7 RIDGWAY COURT P.O. BOX 437
ELKHORN, WISCONSIN 53121
OFFICE: (262) 723-2098 FAX: (262) 723-5886

REVISIONS

09/14/2005
SITE, GRADING, DRAINAGE, & EROSION CONTROL PLAN

11/09/2005
TO SHOW SIZE AND LOCATION OF AS-BUILT FOUNDATION

PROJECT NO.	4161.02
DATE:	08/10/05
SHEET NO.	1 OF 1