


PLAT OF SURVEY

-OF-

KROTT SURVEYING INC.
N3705 WILLOW BEND LANE
LAKE GENEVA WI. 53147
PHONE # (262)248-3697
FAX # (262)249-0639

A PARCEL OF LAND BY METES AND BOUNDS KNOWN AS "PARCEL C" LOCATED IN THE NORTHWEST 1/4 OF SECTION 2, TOWN 1 NORTH, RANGE 17 EAST, WALWORTH COUNTY, WISCONSIN BEING PARTS OF LOTS 10, 11 AND 12 BLOCK 1 AND WALDES RUHE, FOREST REST SUBDIVISION AND DESCRIBED AS FOLLOWS, TO WIT: COMMENCING AT THE NORTHEAST CORNER OF SAID LOT 10, THENCE S42°17' E 158 FEET ALONG THE WESTERLY LINE OF SHADY LANE TO THE PLACE OF BEGINNING THENCE CONTINUE S42°17' E 13.00 FEET TO THE NORTHERLY LINE OF WALDES RUHE, THENCE S37°05' E 66.43 FEET TO THE SOUTHERLY LINE OF WALDES RUHE, THENCE S46°24' W 344.00 FEET ALONG SAID SOUTHERLY LINE, THENCE S55°02' W 29.44 FEET; THENCE N 87°10' W 44.00 FEET; THENCE N 40°00' W 45.06 FEET TO THE SOUTHWEST CORNER OF LOT 12; THENCE N13°12' W 23.62 FEET; THENCE N13°12' W 23.62 FEET; THENCE N 48°51' E 400.45 FEET TO THE PLACE OF BEGINNING.

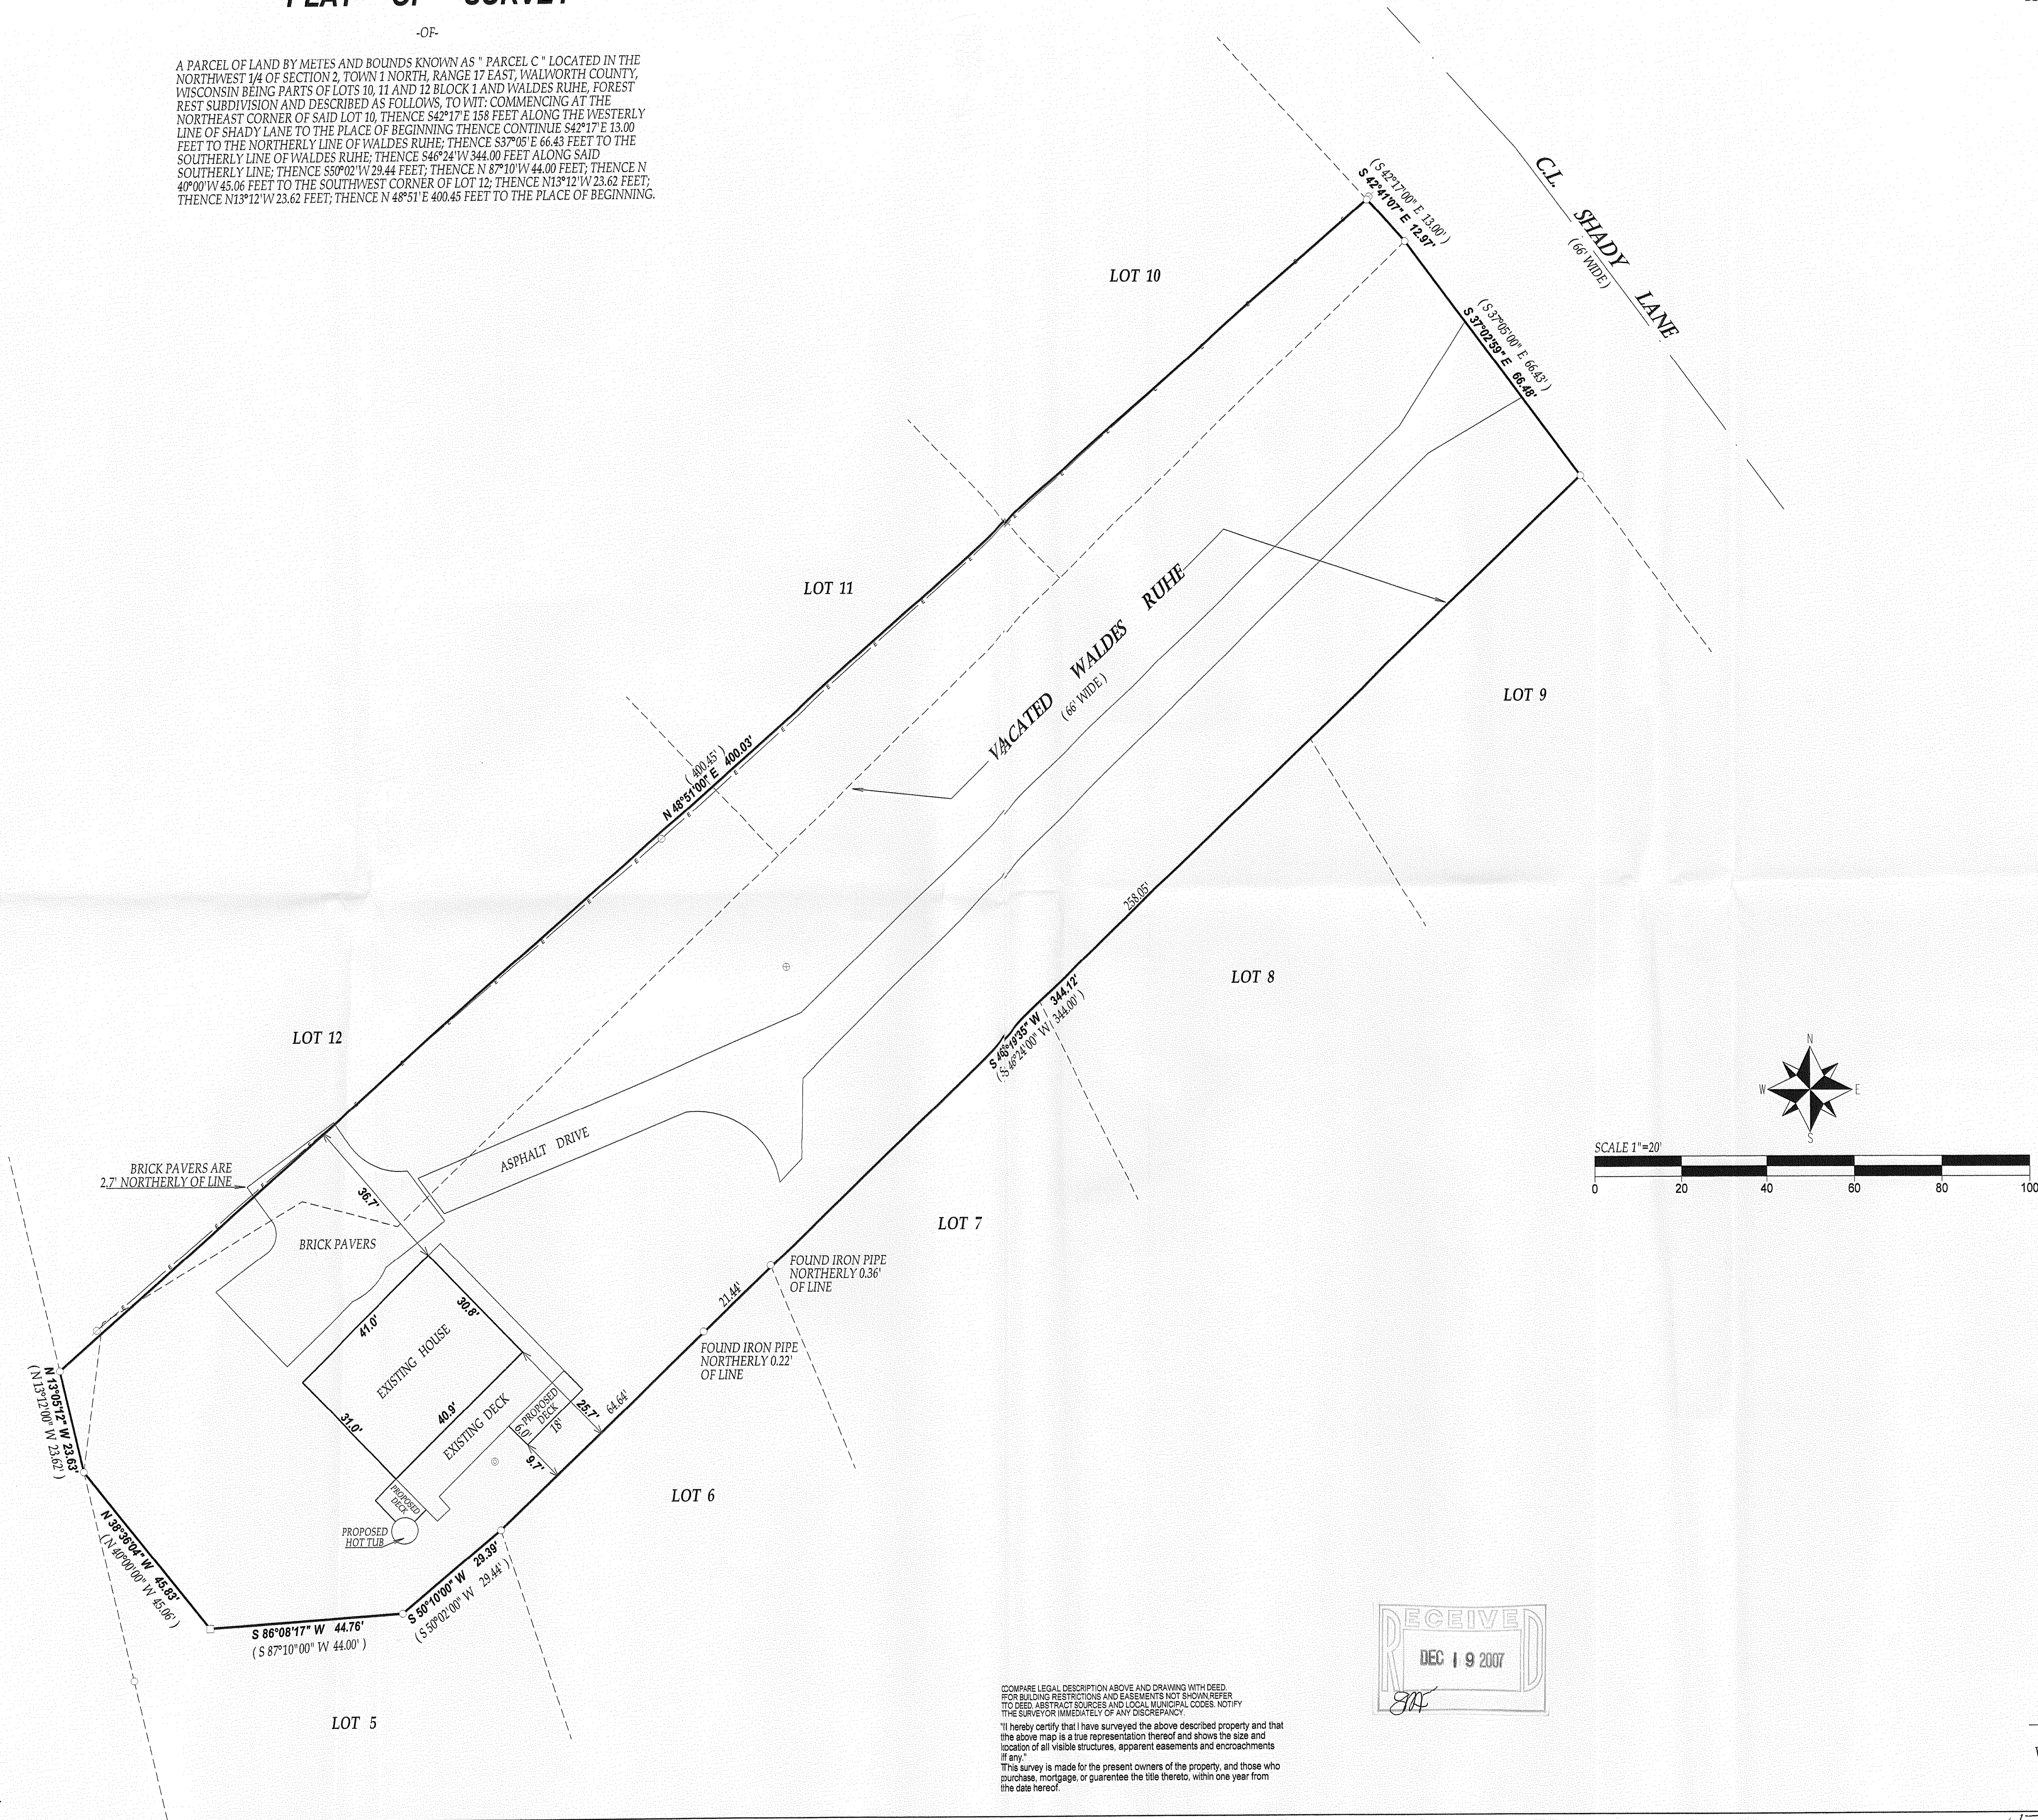

COMPARE LEGAL DESCRIPTION ABOVE AND DRAWING WITH DEED FOR BUILDING RESTRICTIONS AND EASEMENTS NOT SHOWN REFER TO DEED, ABSTRACT SOURCES AND LOCAL MUNICIPAL CODES. NOTIFY THE SURVEYOR IMMEDIATELY OF ANY DISCREPANCY.
I hereby certify that I have surveyed the above described property and that the above map is a true representation thereof and shows the size and location of all visible structures, apparent easements and encroachments if any.
This survey is made for the present owners of the property, and those who purchase, mortgage, or guarantee the title thereto, within one year from the date hereof.

117-2881