


of

a subdivision located in Government Lot 1 in the Southeast 1/4 of Section 8, Town 1 North, Range 17 East, Town of Linn, Walworth County, Wisconsin.

416 Bauer Parkway
Delavan, Wisconsin. 53115

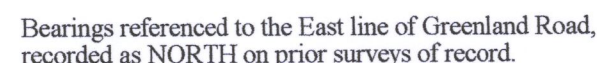

Survey Date: September 11, 2018.
Revisions: No. 1 - Elevations

Scale in Feet
1" = 10'

445 South Wisconsin Street | P.O. Box 322
Elkhorn, Wisconsin. 53121
Telephone: (262) 723-3434
Facsimile: (262) 723-8044
Email: doug@olsonsurveying.com
Website: www.olsonsurveying.com


OLSON
LAND SURVEYING, LLC
Rural | Residential | Commercial

Legend of Symbols & Abbreviations			
Ø	Found Iron Pipe	N	North
●	Found Iron Rod	S	South
○	Set Iron Pipe, 1" dia.	W	West
()	Recorded Information	In	In Bearings
⊗	Utility Pole	Deg	Degrees
⊙	Utility Pole	"	" Degrees
⊖	Concrete Cover	In	In Distances
⊕	Concrete Cover	Feet	Feet
Asphalt Surface			
Concrete Surface			
Brick Pavers			

Sheet 1 of 1 Sheets

Job Reference Number

2018.124

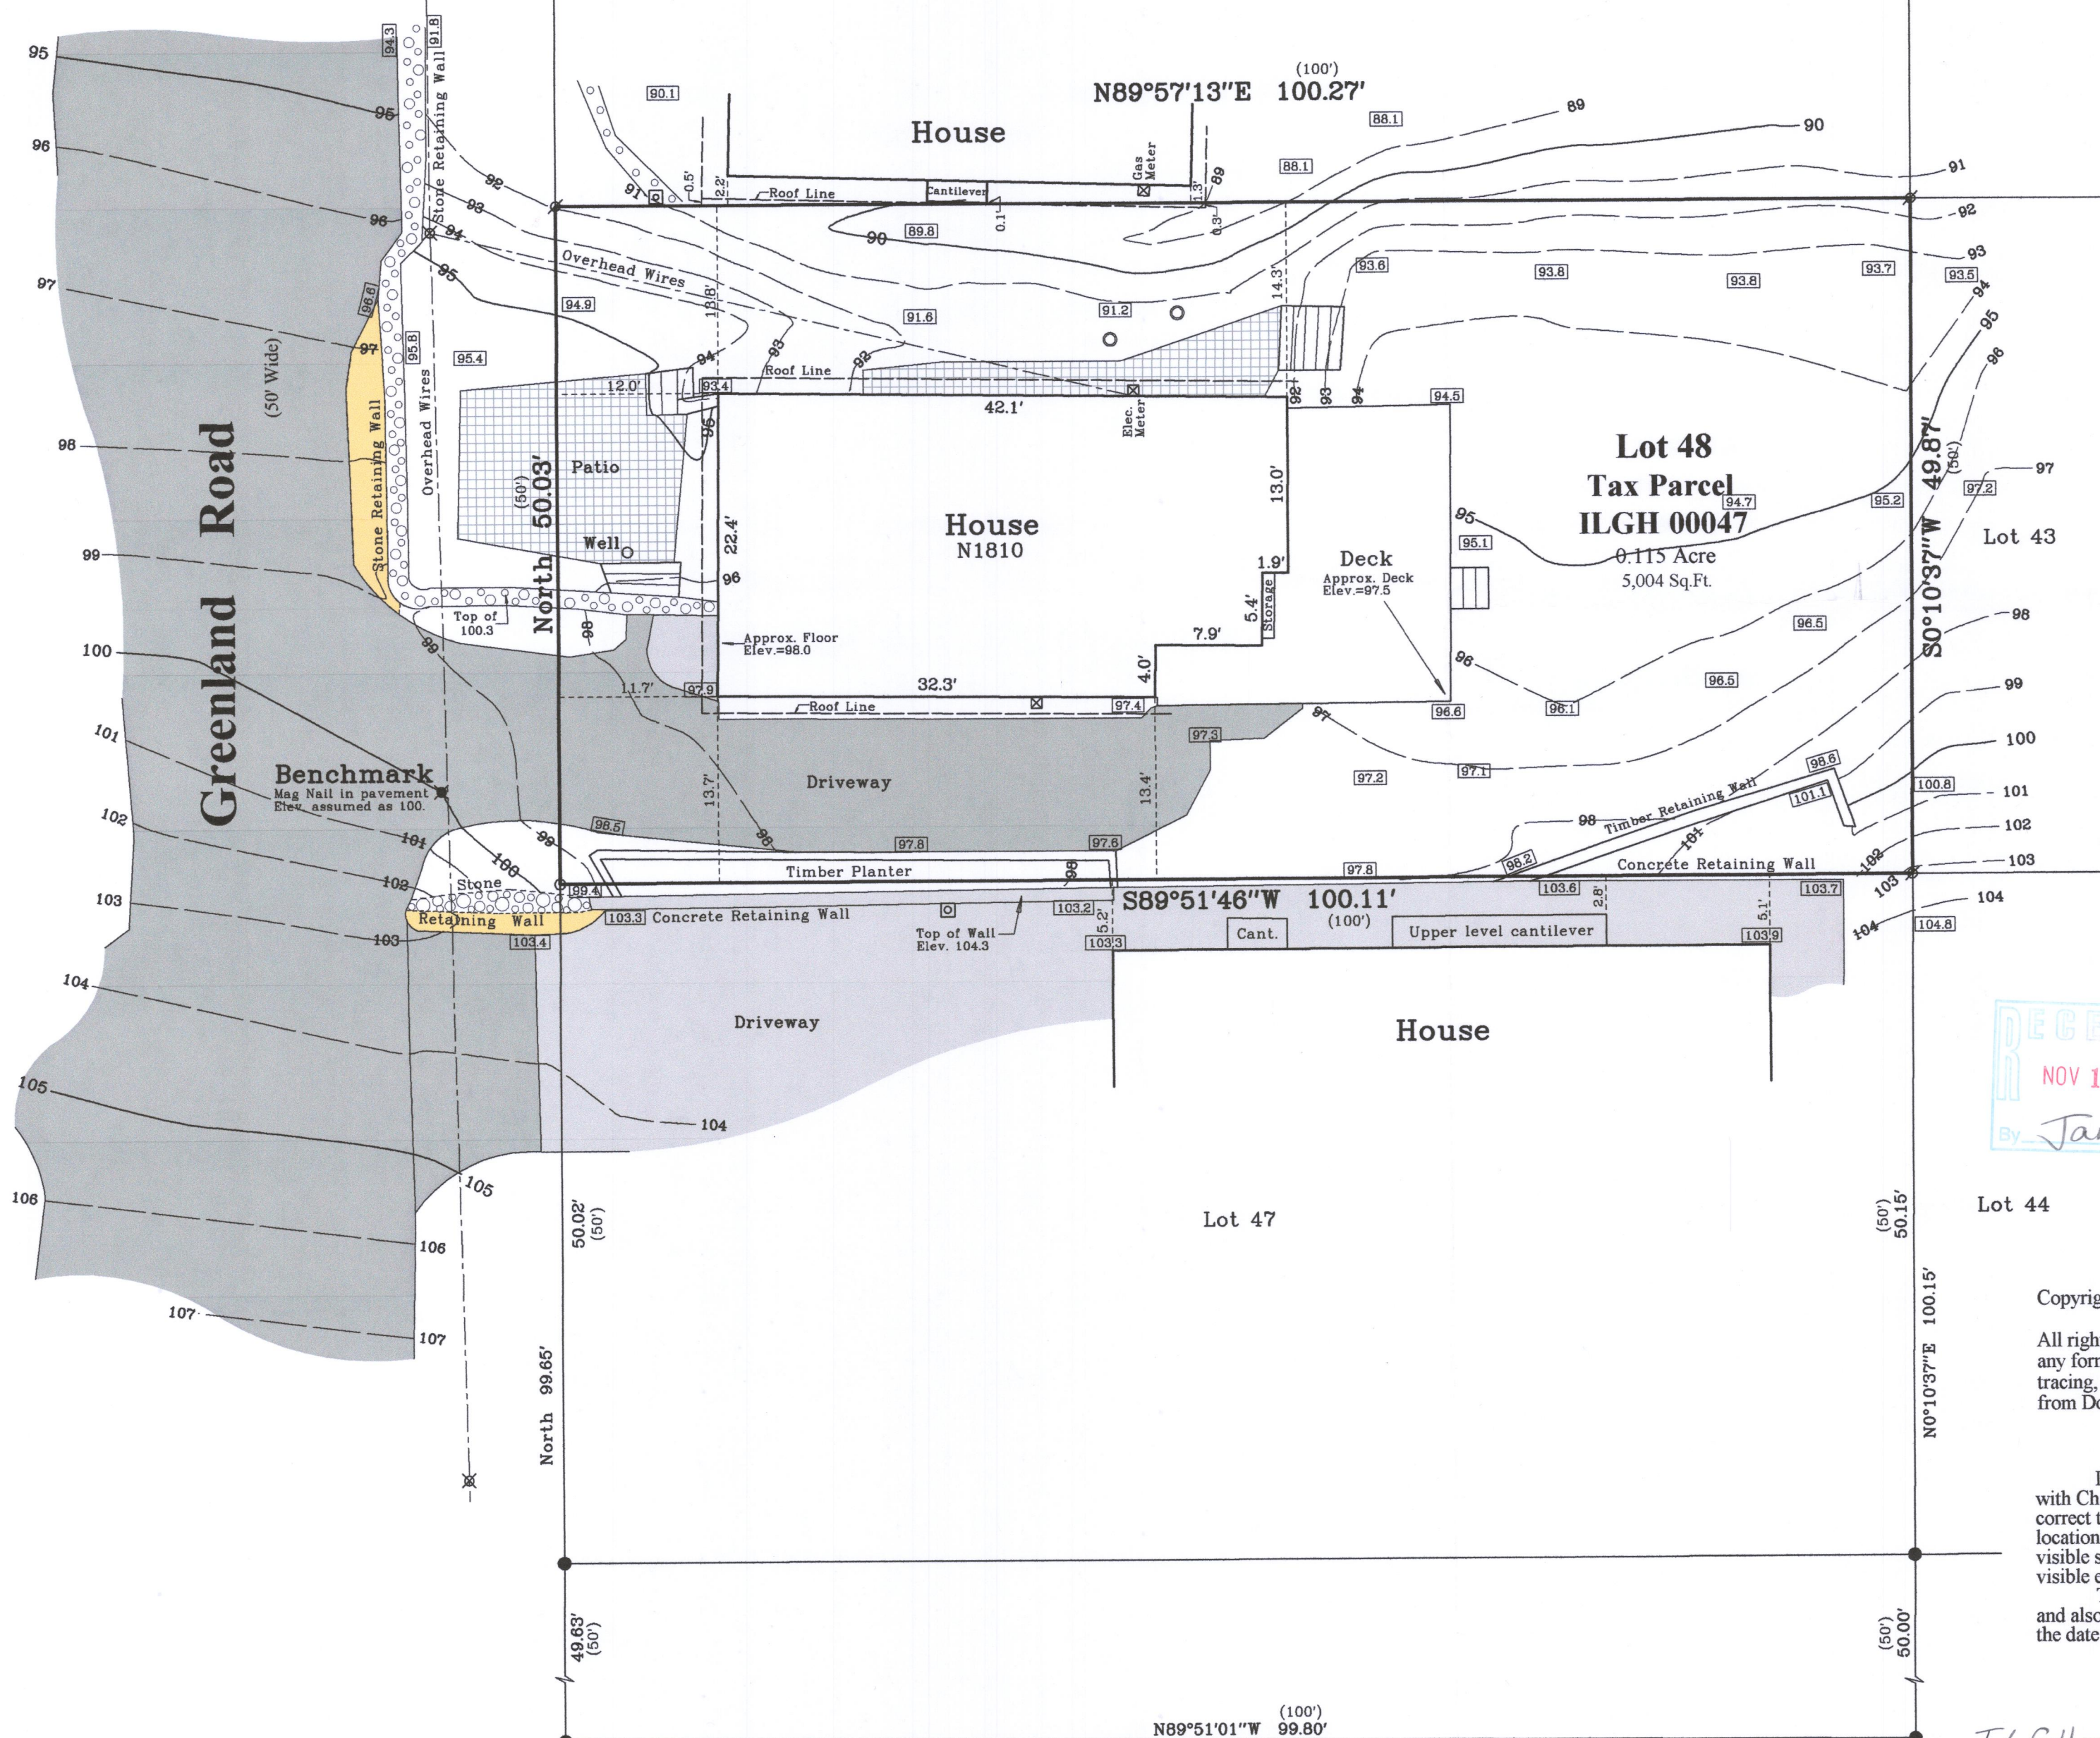

Notes:

- 1) This Plat of Survey is not certified unless signed and sealed in red ink.
- 2) This survey is subject to Wisconsin lien laws. This Plat of Survey is the notice of intent to file lien. Lien waiver required.
- 3) The Survey Date shown on this Plat of Survey is the completion date of the field work.

Copyright ©2018 by Olson Land Surveying, LLC.

All rights reserved. No part of this survey plat may be reproduced or transmitted in any form by any means - graphic, electronic, or mechanical, including photocopying, tracing, or information storage and retrieval systems - without permission in writing from Douglas G. Olson. Olson Land Surveying, LLC.

I hereby certify that I have surveyed the above described property in compliance with Chapter A-E 7 of the Wisconsin Administrative Code and that the map hereon is correct to the best of my professional knowledge and belief and shows the size and location of the property, its exterior boundaries, the location and dimensions of all visible structures thereon, boundary fences, apparent easements and roadways and visible encroachments, if any.

This survey is made for the exclusive use of the present owners of the property, and also those who purchase, mortgage or guarantee title thereto, within one year from the date hereof.

Douglas G. Olson
Wisconsin Professional Land Surveyor - 2093

ILGH-47 117-4187