LAND-MARK SURVEYING
Mark L. Miritz
Wisconsin Professional Land Surveyor S-2582

N9330 Knuteson Drive
Whitewater, WI 53190
Phone:(262)949-1239
MARKMIRITZ@
LAND-MARKSURVEYING.COM

PLAT OF SURVEY

LOTS 5, 6, 7 AND 8 IN BLOCK 9 IN SUNSET HILLS SUBDIVISION, LOCATED IN THE NORTHWEST 1/4 OF SECTION 4, TOWN 1 NORTH, RANGE 17 EAST, LINN TOWNSHIP, WALWORTH COUNTY, WISCONSIN.

OWNERS:
DAVID A. OATES
KATHLEEN A. OATES
931 CREEKVIEW LANE
LAKE IN THE HILLS, IL 60156

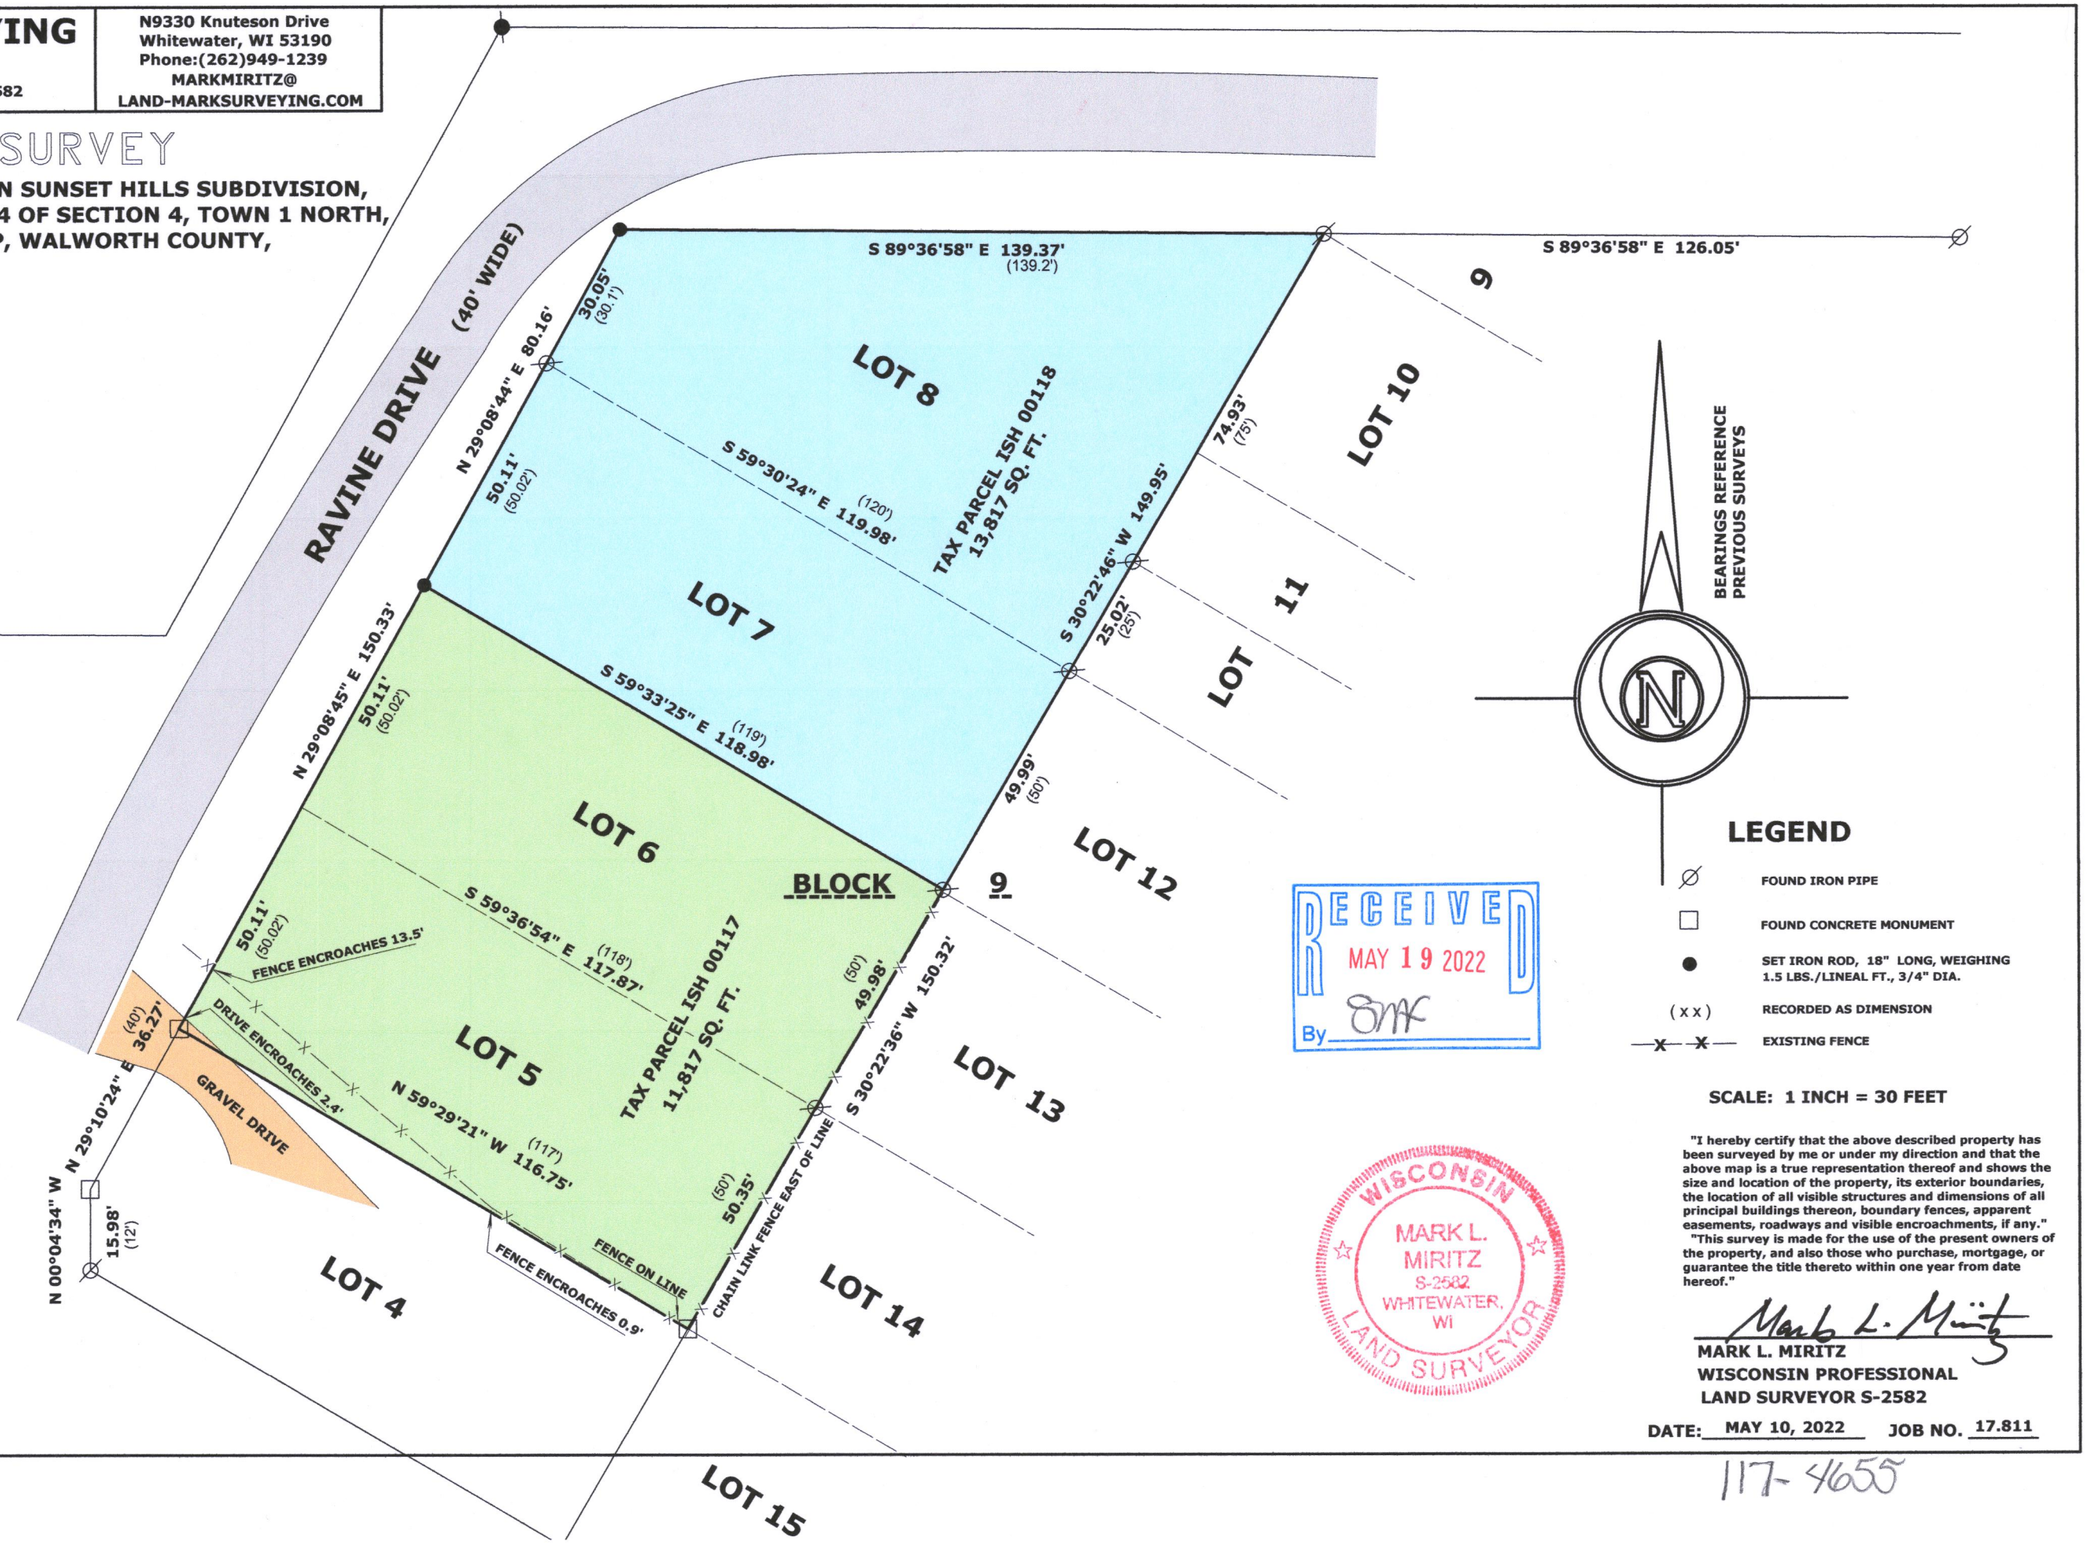

RECEIVED
MAY 19 2022
By SMK

LEGEND

⌀	FOUND IRON PIPE
□	FOUND CONCRETE MONUMENT
●	SET IRON ROD, 18" LONG, WEIGHING 1.5 LBS./LINEAL FT., 3/4" DIA.
(xx)	RECORDED AS DIMENSION
—x—x—	EXISTING FENCE

SCALE: 1 INCH = 30 FEET

WISCONSIN
MARK L. MIRITZ
S-2582
WHITEWATER, WI
LAND SURVEYOR

"I hereby certify that the above described property has been surveyed by me or under my direction and that the above map is a true representation thereof and shows the size and location of the property, its exterior boundaries, the location of all visible structures and dimensions of all principal buildings thereon, boundary fences, apparent easements, roadways and visible encroachments, if any."
"This survey is made for the use of the present owners of the property, and also those who purchase, mortgage, or guarantee the title thereto within one year from date hereof."

Mark L. Miritz
MARK L. MIRITZ
WISCONSIN PROFESSIONAL
LAND SURVEYOR S-2582

DATE: MAY 10, 2022 JOB NO. 17.811

ISH-117 ISH-118

117-4655