


DUNHAM SURVEYING, S.C.
SURVEYING & SUBDIVIDING
DELAVAN, WISCONSIN 53115

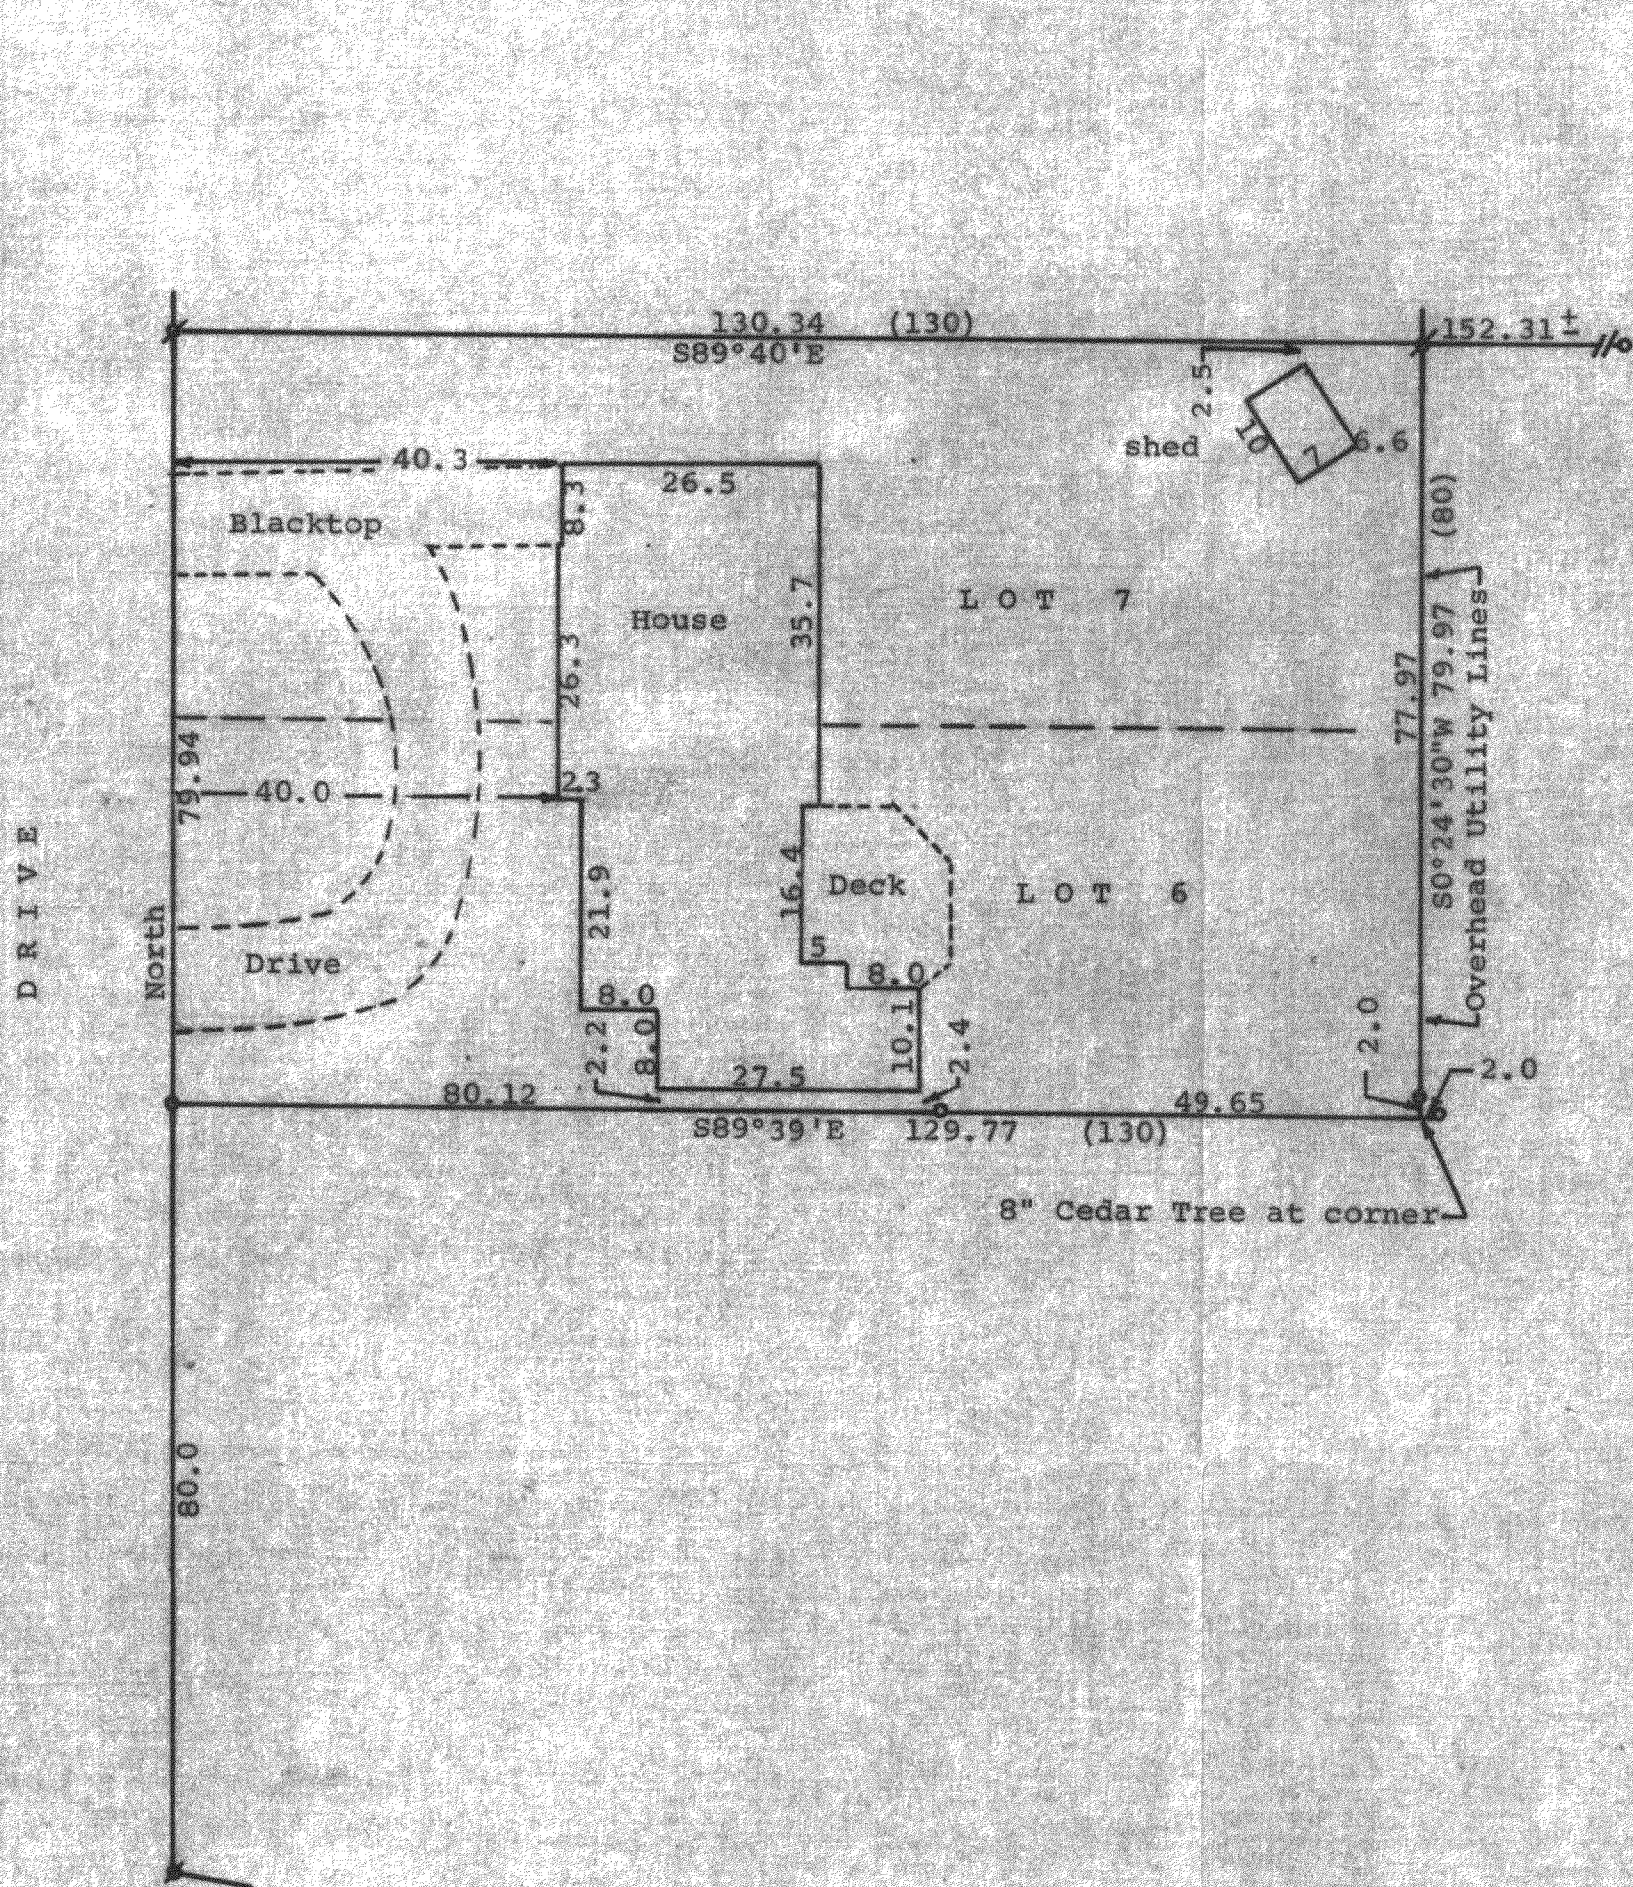


Scale - 1" = 20'
 * = 1" Iron Pipe Found
 o = 1/4" Iron Pipe Found
 (0.00) = recorded distance
 Bearings referenced to the assumed bearing of North
 along the east line of Greenleaf Drive
 Survey ordered by: Anchor Savings & Loan
 Delavan, WI. 53115

STATE OF WISCONSIN)
 COUNTY OF WALWORTH)

I, George T. Dunham, Surveyor, certify that I have surveyed the property described as follows:

Lots 6 and 7 in Block "J" of Cisco Beach, a subdivision located in Section 5, T 1 N, R 17 E, Walworth County, Wisconsin and that the map shown above is a true representation thereof and shows the size and location of the property, its exterior boundaries, the location of all visible structures and dimensions of all principal buildings thereon, boundary fences, apparent easements, roadways and visible encroachments, if any, and that I have surveyed the property hereon described according to the official records to the best of my knowledge and belief
 December 6, 1983

George T. Dunham
 George T. Dunham, Surveyor

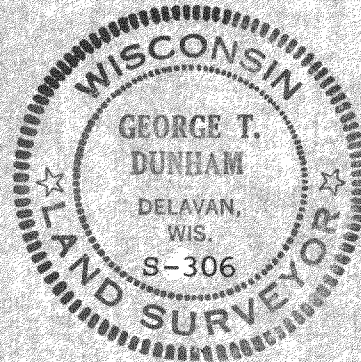

117-663-D