DUNHAM SURVEYING, S. C.
SURVEYING & SUBDIVIDING
DELAVAN, WISCONSIN 53115

RECEIVED
AUG 19 1986

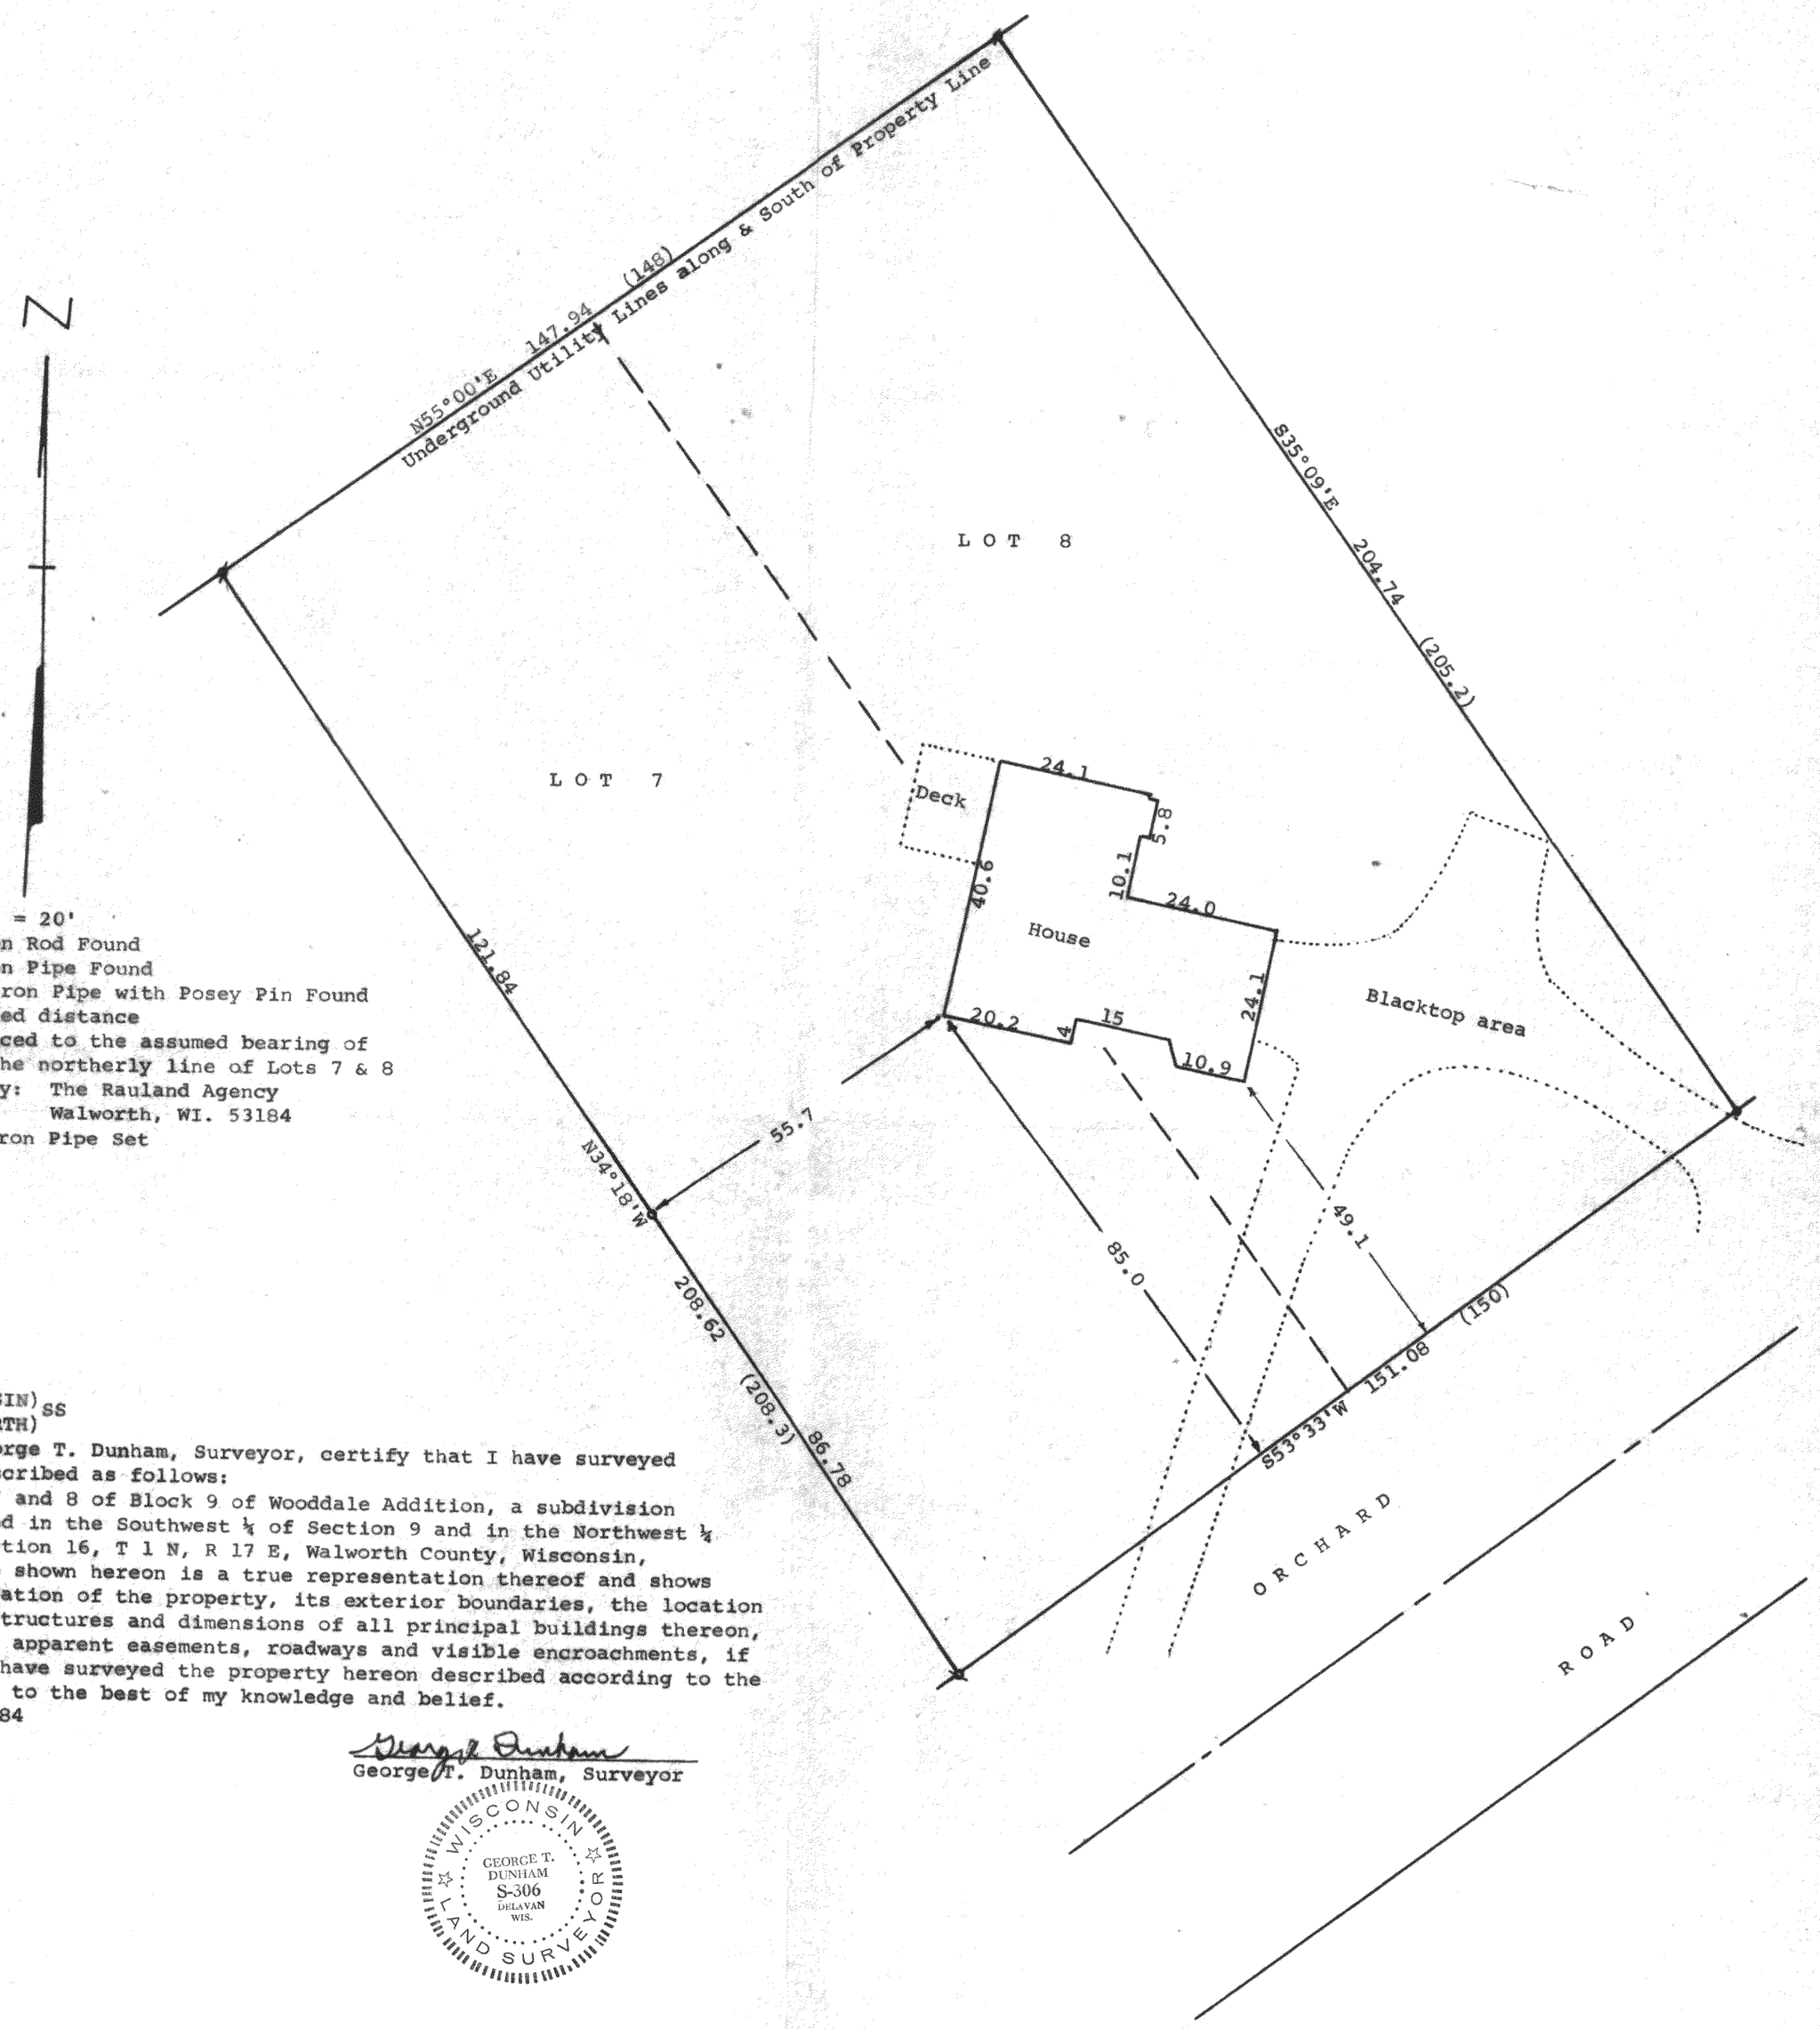

Scale - 1" = 20'
● = ½" Iron Rod Found
ø = 1" Iron Pipe Found
= 3/4" Iron Pipe with Posey Pin Found
(0.00) = recorded distance
Bearings referenced to the assumed bearing of N55°00'E along the northerly line of Lots 7 & 8
Survey ordered by: The Rauland Agency
Walworth, WI. 53184
o = 3/4" Iron Pipe Set

STATE OF WISCONSIN) SS
COUNTY OF WALWORTH)

I, George T. Dunham, Surveyor, certify that I have surveyed the property described as follows:

Lots 7 and 8 of Block 9 of Wooddale Addition, a subdivision located in the Southwest ¼ of Section 9 and in the Northwest ¼ of Section 16, T 1 N, R 17 E, Walworth County, Wisconsin,

and that the map shown hereon is a true representation thereof and shows the size and location of the property, its exterior boundaries, the location of all visible structures and dimensions of all principal buildings thereon, boundary fences, apparent easements, roadways and visible encroachments, if any, and that I have surveyed the property hereon described according to the official records to the best of my knowledge and belief.

September 19, 1984

George T. Dunham
George T. Dunham, Surveyor

WISCONSIN LAND SURVEYOR
GEORGE T. DUNHAM
S-306
DELAVAN WIS.

K & E 10-9155

1W-58F