PLAT OF SURVEY OF
LOT 4 OF BLACK POINT FARM
A SUBDIVISION LOCATED IN SEC 8 & 9
T1N., R17E., WALWORTH COUNTY, WI

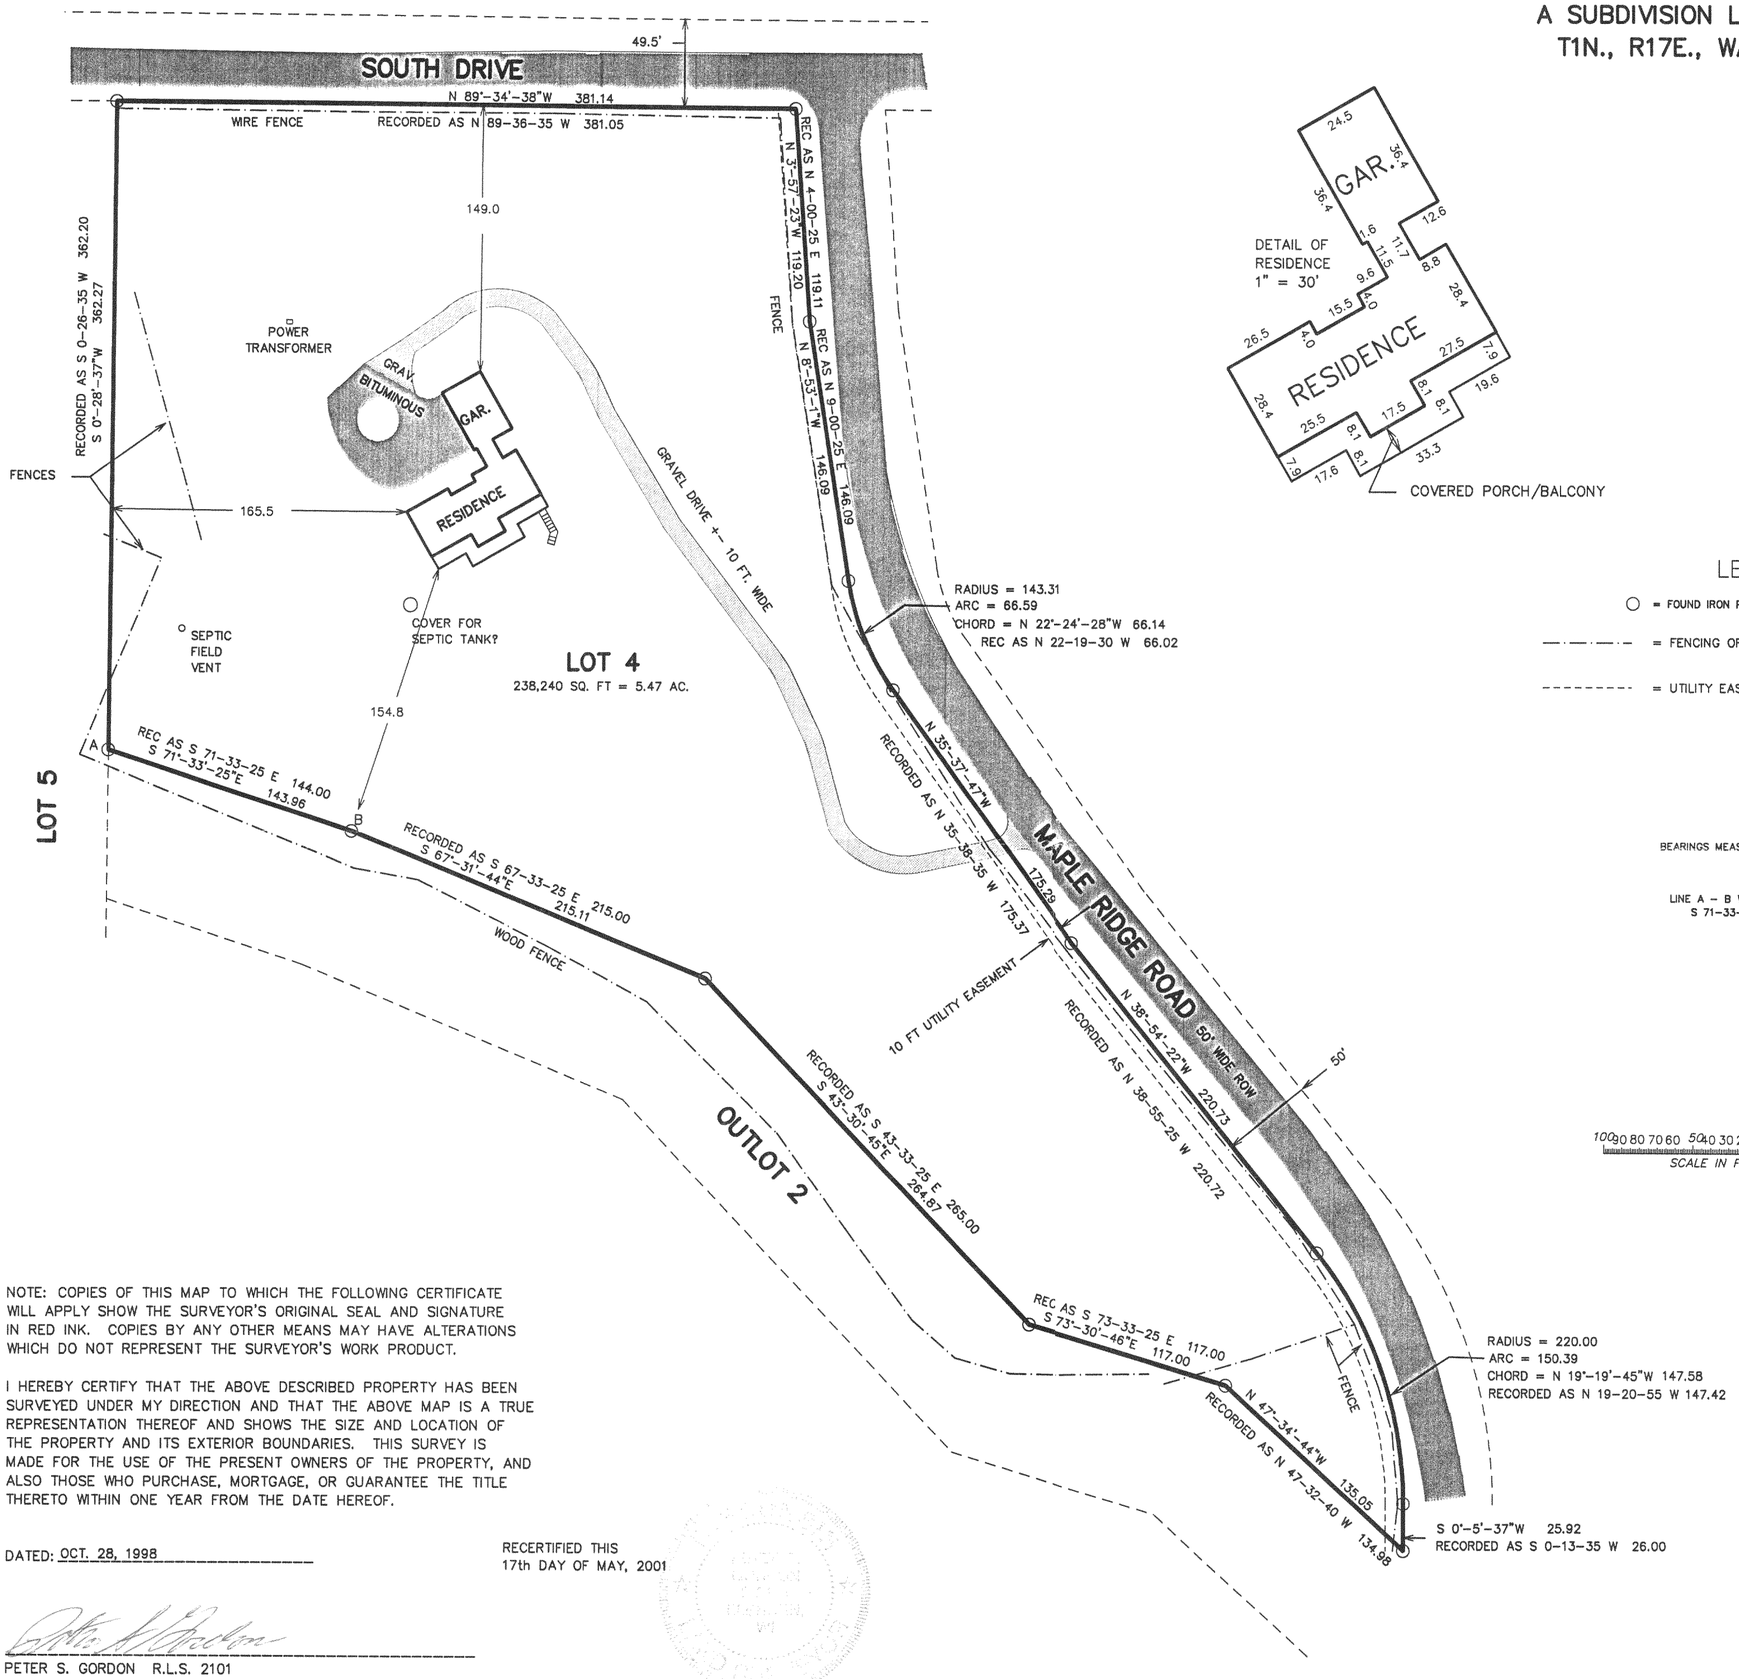

LEGEND

- ○ = FOUND IRON PIPE SURVEY STAKE +- 1.75 DIA.
- —·—·— = FENCING OF VARIOUS TYPES
- - - - - - - - = UTILITY EASEMENT SHOWN ON SUB. PLAT

BEARINGS MEASURED RELATIVE TO
N
LINE A – B WHICH WAS ASSIGNED
S 71-33-25 E AS RECORDED

100 90 80 70 60 50 40 30 20 10 0 100
SCALE IN FEET ORIGINAL SCALE 1" = 60'

NOTE: COPIES OF THIS MAP TO WHICH THE FOLLOWING CERTIFICATE WILL APPLY SHOW THE SURVEYOR'S ORIGINAL SEAL AND SIGNATURE IN RED INK. COPIES BY ANY OTHER MEANS MAY HAVE ALTERATIONS WHICH DO NOT REPRESENT THE SURVEYOR'S WORK PRODUCT.

I HEREBY CERTIFY THAT THE ABOVE DESCRIBED PROPERTY HAS BEEN SURVEYED UNDER MY DIRECTION AND THAT THE ABOVE MAP IS A TRUE REPRESENTATION THEREOF AND SHOWS THE SIZE AND LOCATION OF THE PROPERTY AND ITS EXTERIOR BOUNDARIES. THIS SURVEY IS MADE FOR THE USE OF THE PRESENT OWNERS OF THE PROPERTY, AND ALSO THOSE WHO PURCHASE, MORTGAGE, OR GUARANTEE THE TITLE THERETO WITHIN ONE YEAR FROM THE DATE HEREOF.

DATED: OCT. 28, 1998

RECERTIFIED THIS
17th DAY OF MAY, 2001

PETER S. GORDON R.L.S. 2101

RECEIVED
JUN _ 7 2001

PLAT OF SURVEY OF
LOT 4 OF BLACK POINT FARM
A SUBDIVISION LOCATED IN SEC 8 & 9
T1N., R17E., WALWORTH COUNTY, WI

WORK ORDERED BY:
RAULAND AGENCY
118 KENOSHA ST.
WALWORTH, WI

FARRIS, HANSEN & ASSOCIATES, INC.
Engineering, Architecture, Surveying
7 Ridgway Court P.O. Box 437
ELKHORN, WISCONSIN 53121
Office: (414) 723-2098
Fax: (414) 723-5886

REVISIONS

PROJECT NO. 5144
DATE: 10/26/98
SHEET NO. 1 OF 1

MAY 15 2001

117-2007

IBL-4