


A PART OF LOT ONE OF BONNINE BRAE SUBDIVISION
LOCATED IN SECTIONS 3 & 4, TOWN 1 NORTH, RANGE 17 EAST
WALWORTH COUNTY, WISCONSIN

ASSIGNED SW LINE LANDS SURVEYED
N 00°31'25" W

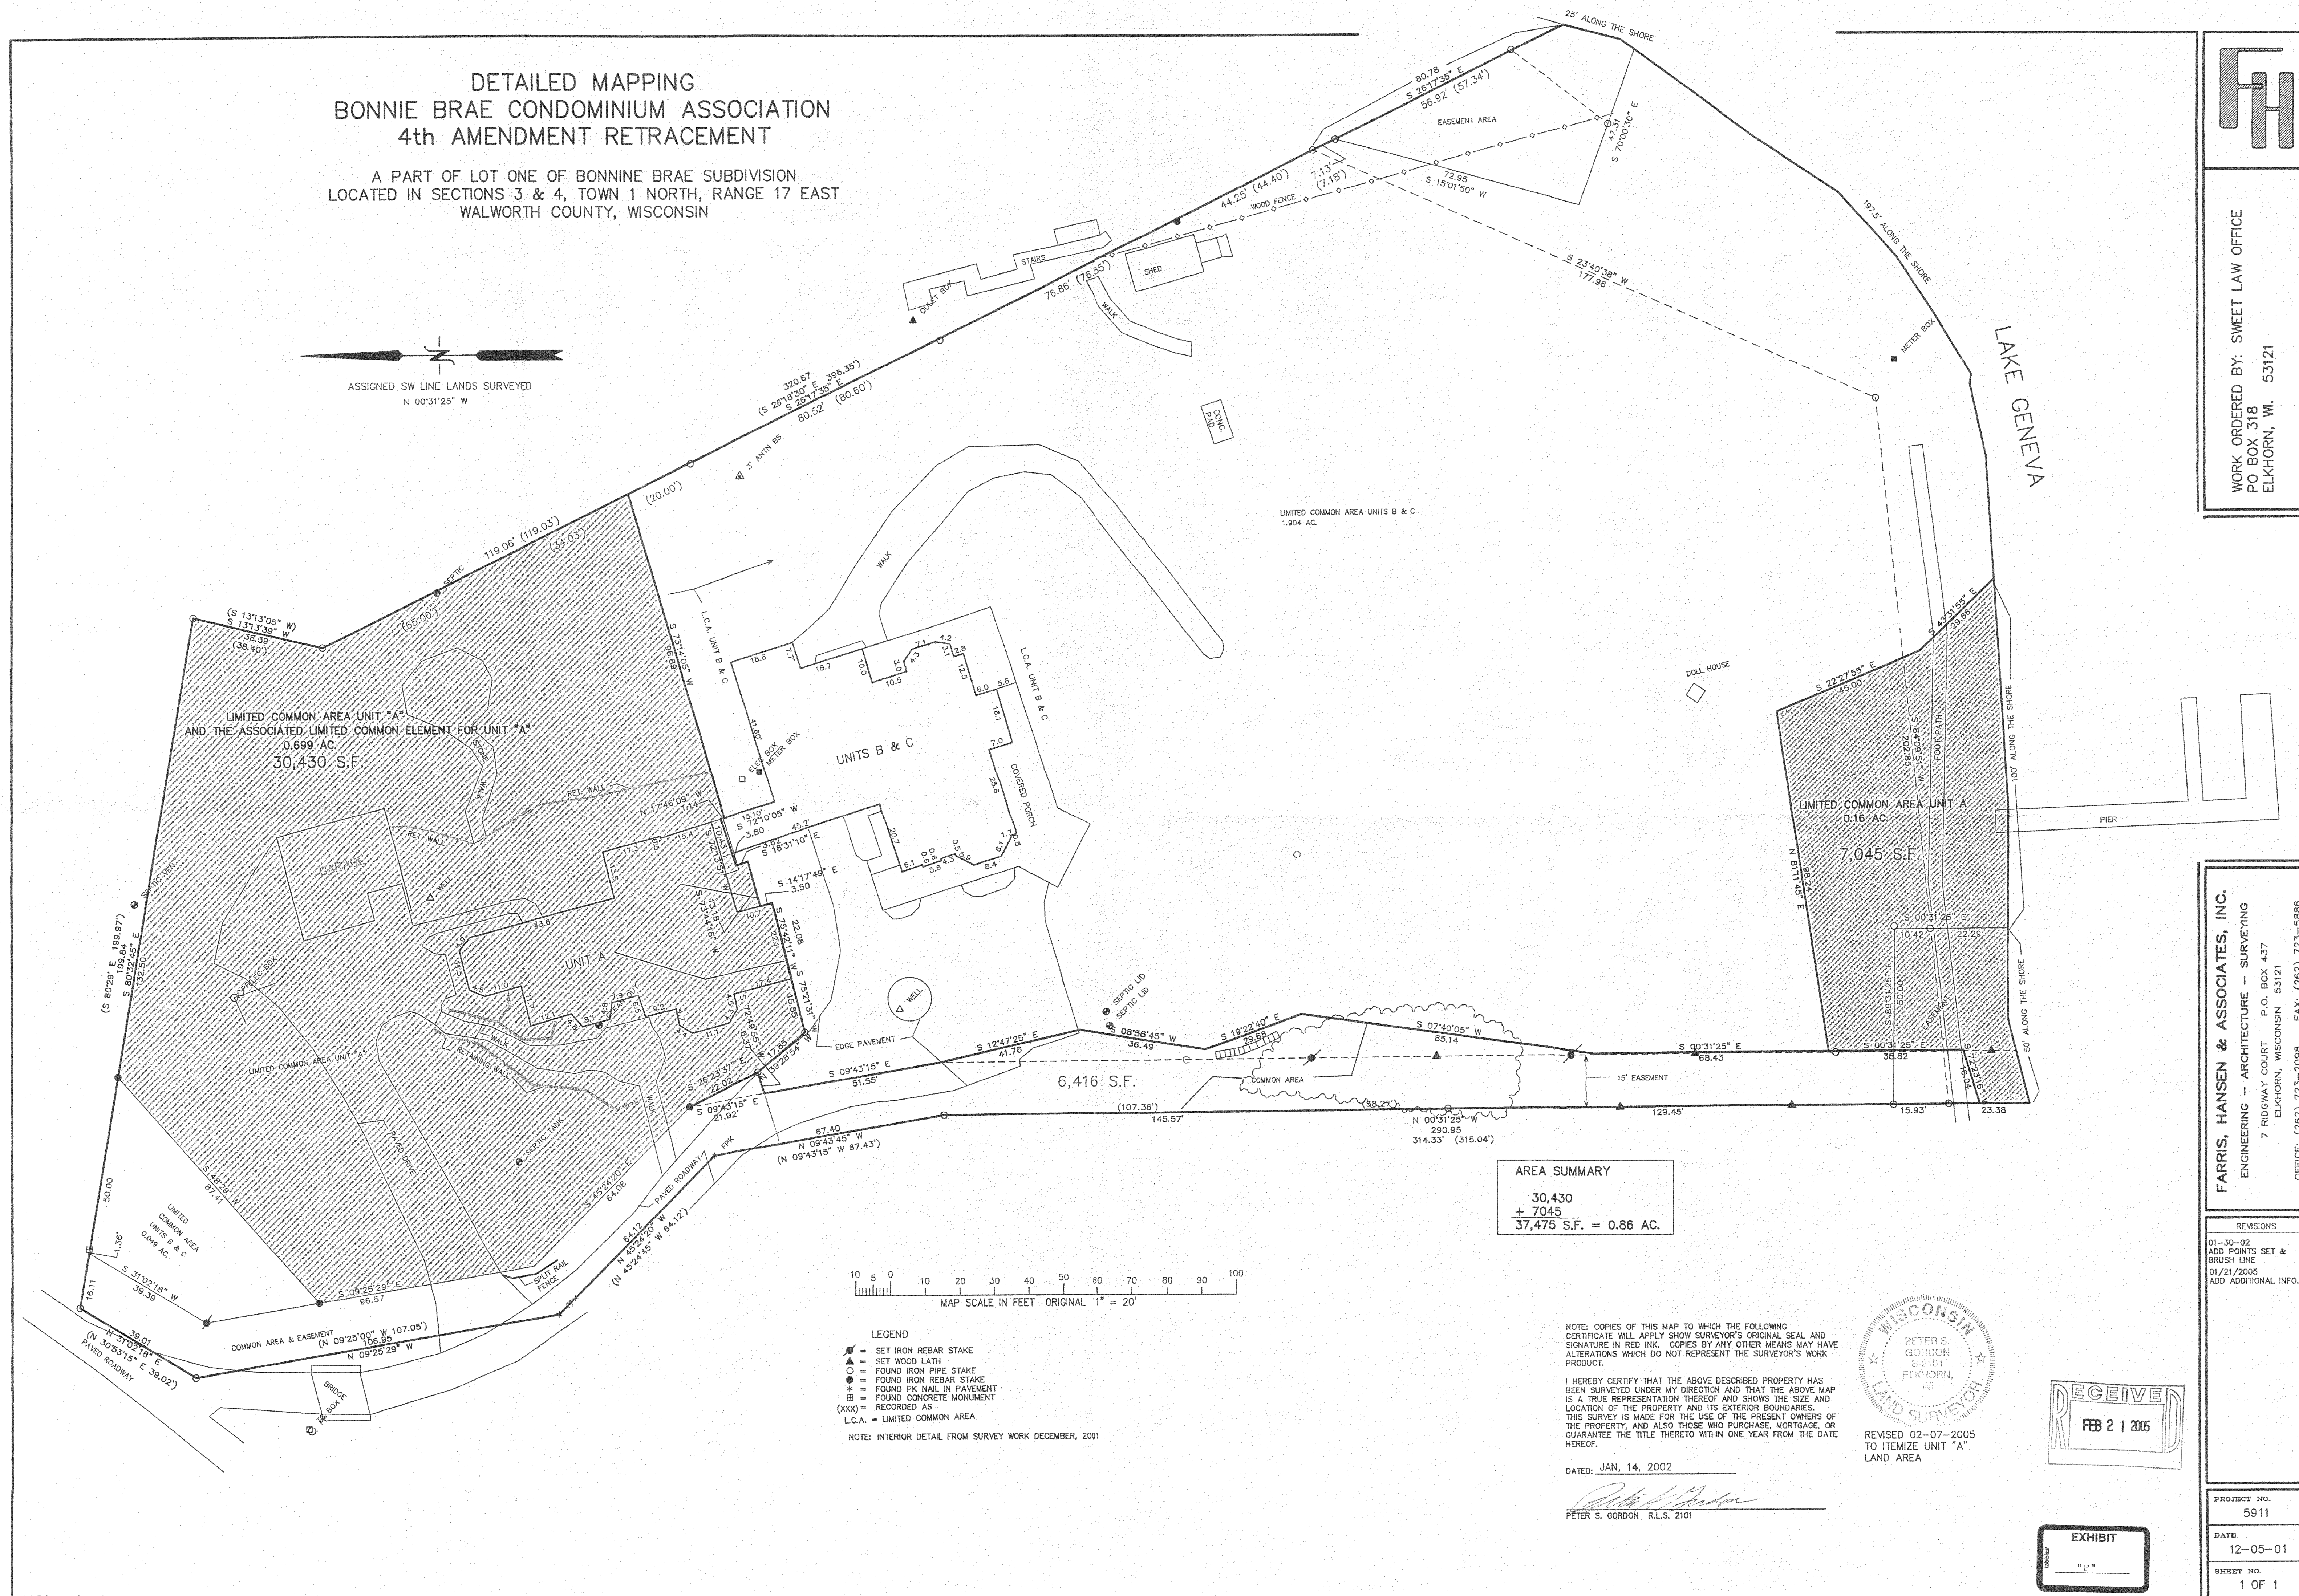

WORK ORDERED BY: SWEET LAW OFFICE
PO BOX 318
ELKHORN, WI. 53121

FARRIS, HANSEN & ASSOCIATES, INC.
ENGINEERING — ARCHITECTURE — SURVEYING
7 RIDGWAY COURT P.O. BOX 437
ELKHORN, WISCONSIN 53121
OFFICE: (262) 723-2098 FAX: (262) 723-5886

REVISIONS
-30-02 D POINTS SET & USH LINE /21/2005 D ADDITIONAL INFO.

PROJECT NO.	5911
DATE	12-05-01
SHEET NO.	1 OF 1

REVISED 02-07-2005
TO ITEMIZE UNIT "A"
LAND AREA

RECEIVED
FEB 21 2005

EXHIBIT

"F"

5002 2 0 838