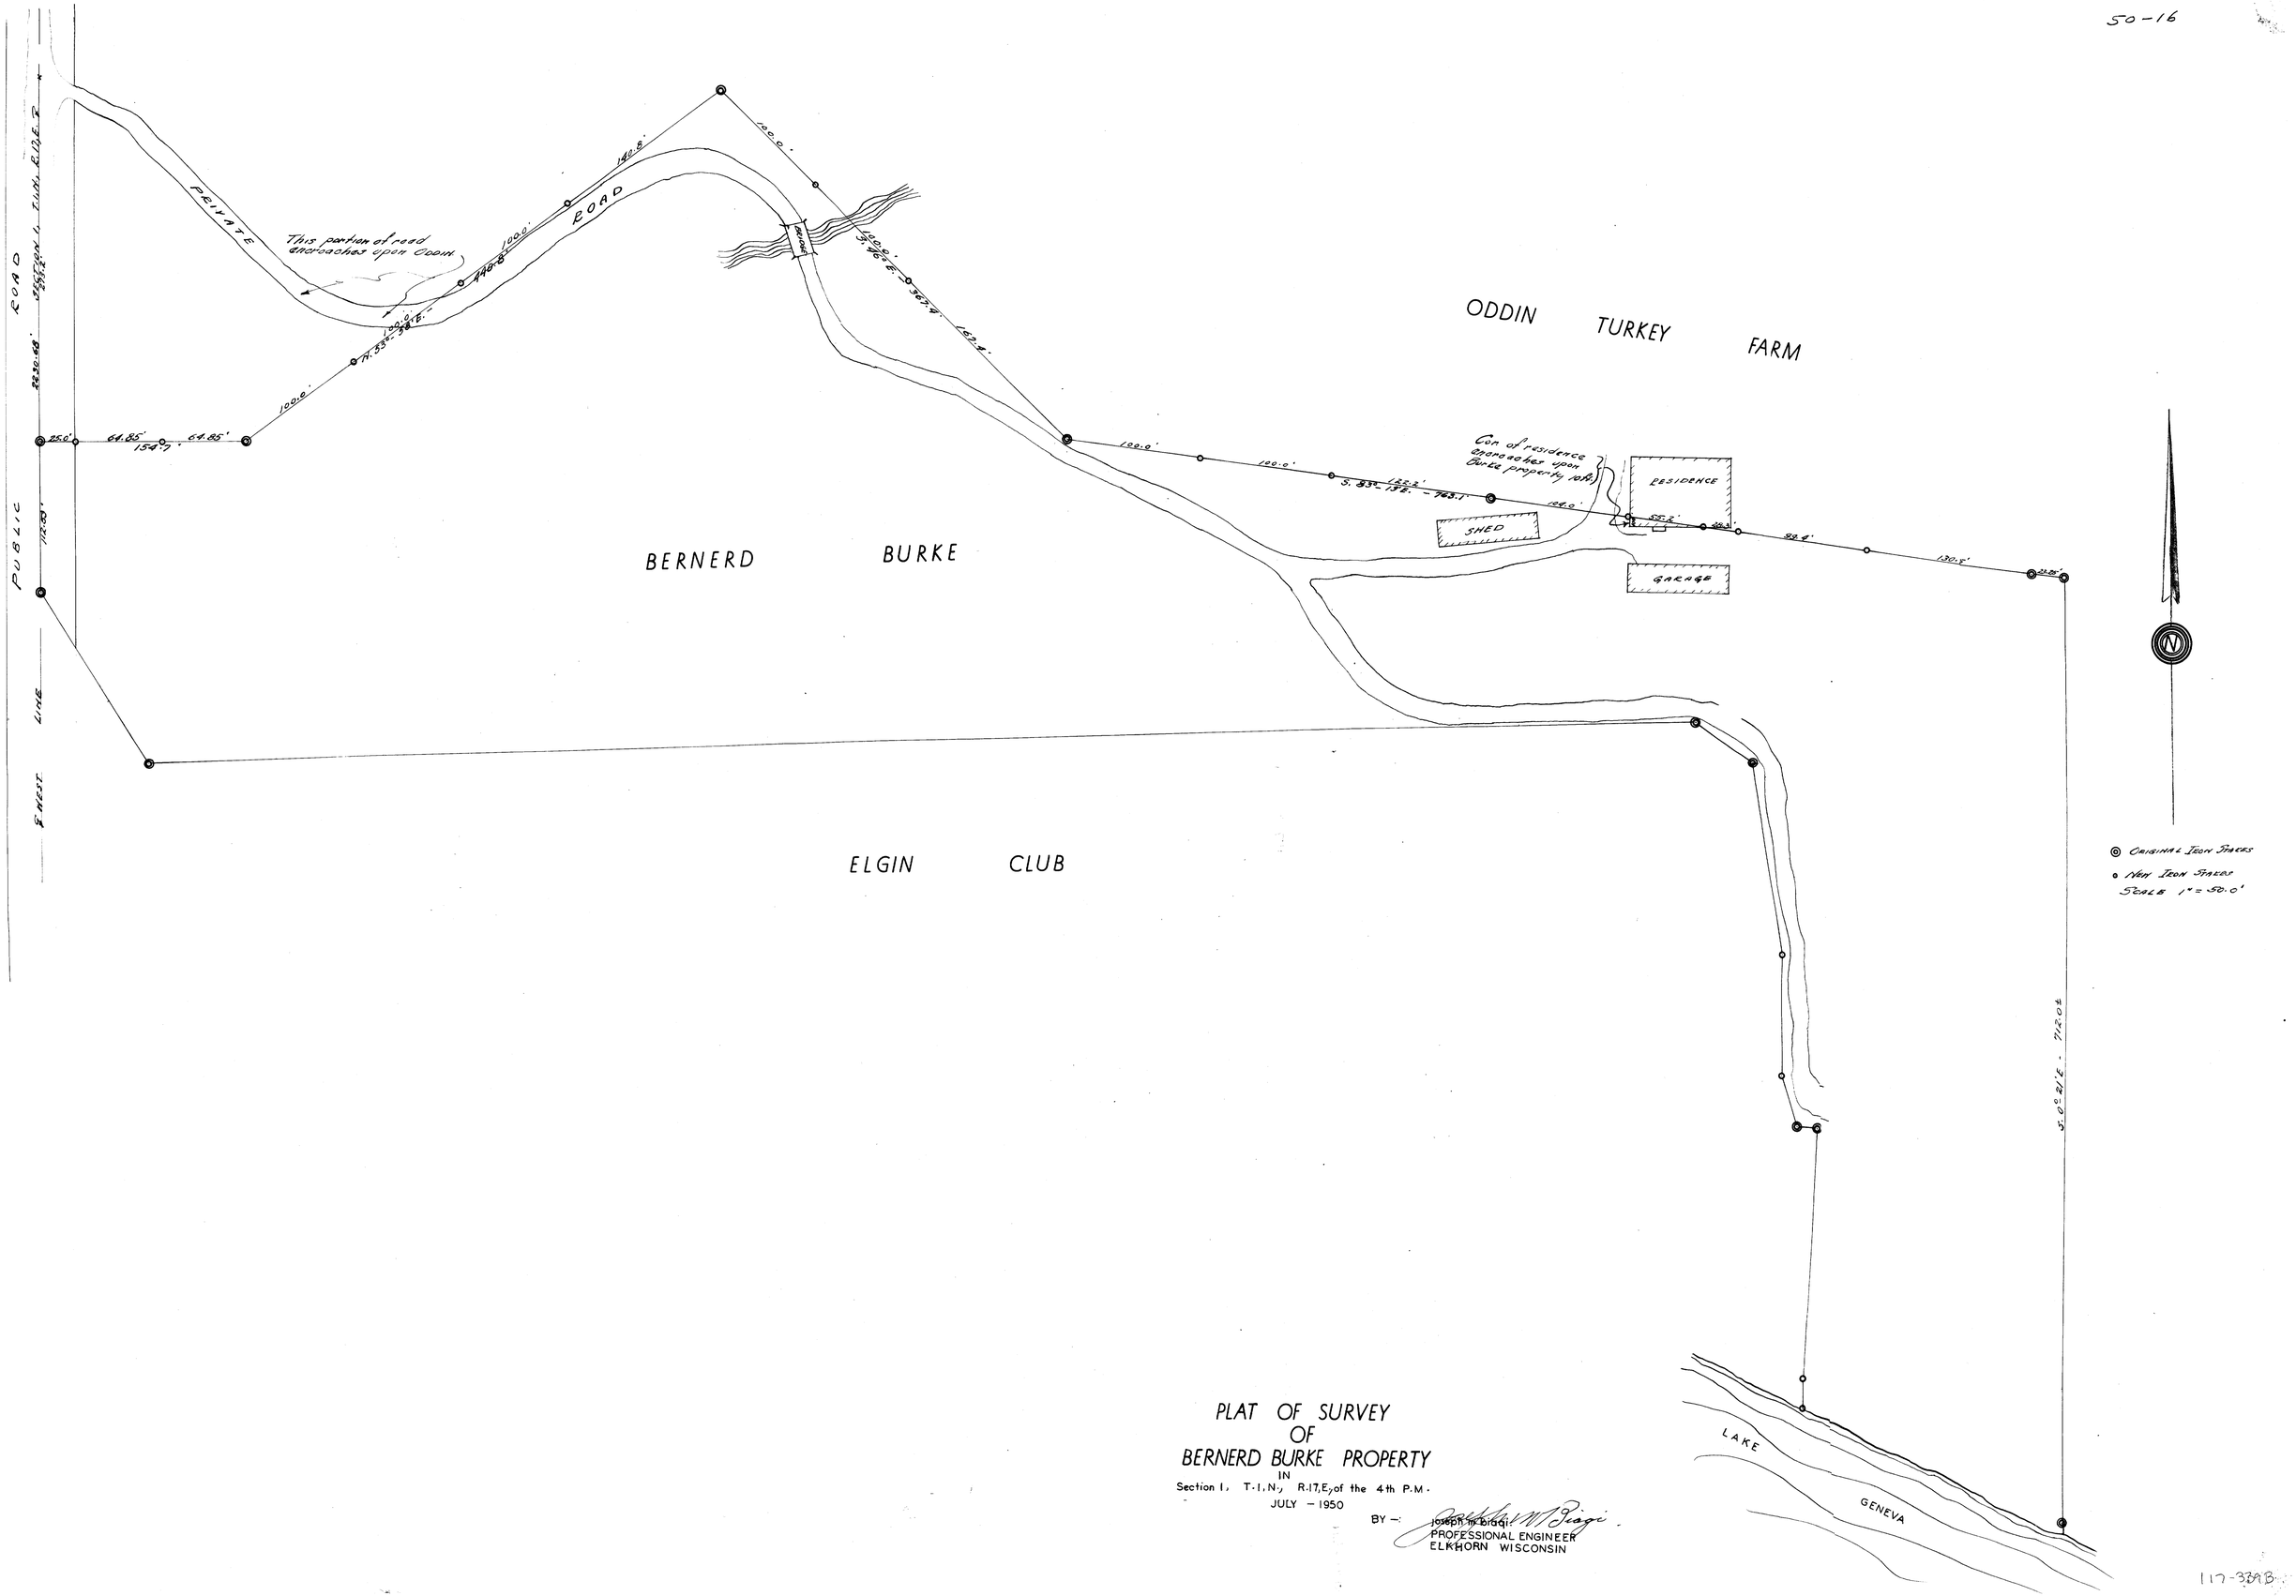

PLAT OF SURVEY
OF
BERNERD BURKE PROPERTY
IN
Section 1, T.1.N., R.17,E., of the 4th P.M.
JULY – 1950

BY –: Joseph M. Biagi
PROFESSIONAL ENGINEER
ELKHORN WISCONSIN

117-339B