HAROLD H. KOLB

REGISTERED PROFESSIONAL LAND SURVEYOR
LAKE GENEVA, WISCONSIN

PLAT OF SURVEY OF

A parcel of land located in the Southeast 1/4 of Section 11, T 1 N, R 17 E, Walworth County, Wisconsin and described as follows; towit:
Commencing at the North 1/16 corner of the Southeast 1/4 of said Section 11; thence South 1197.30 feet; thence S 80°00' W 101.54 feet; thence North 408.83 feet to the place of beginning; thence West 10.00 feet; thence North 52.00 feet; thence East 10.00 feet; thence South 52.00 feet to the place of beginning.

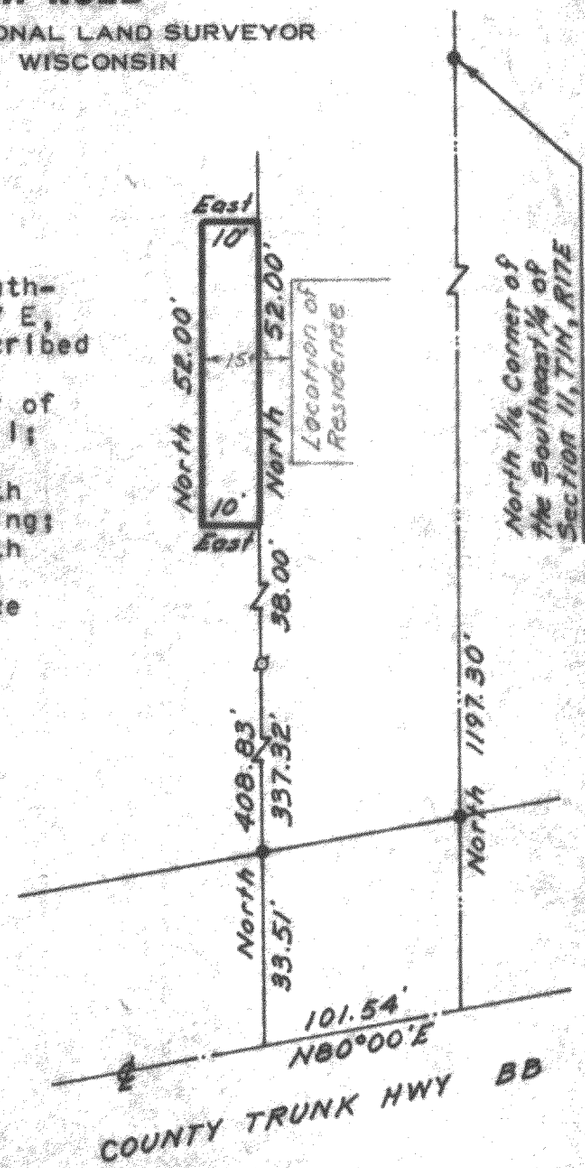

N

SCALE 1"=30'

LEGEND

Ø — IRON PIPE FOUND
O — IRON PIPE PLACED
● — CONCRETE MONUMENT
X — SPIKE

I, HAROLD H. KOLB, DO HEREBY CERTIFY THAT I HAVE SURVEYED THE PROPERTY HEREON DESCRIBED ACCORDING TO THE OFFICIAL RECORDS, AND THAT THE PLAT HEREON IS A CORRECT REPRESENTATION OF THE LOT LINES.

Harold H. Kolb
HAROLD H. KOLB
WISCONSIN REGISTERED LAND SURVEYOR, S—187
DATE September 17, 1965

L-11-12-part of
P.C.S. 1506

117-170