DUNHAM SURVEYING, S.C.

SURVEYING & SUBDIVIDING
DELAVAN, WISCONSIN 53115

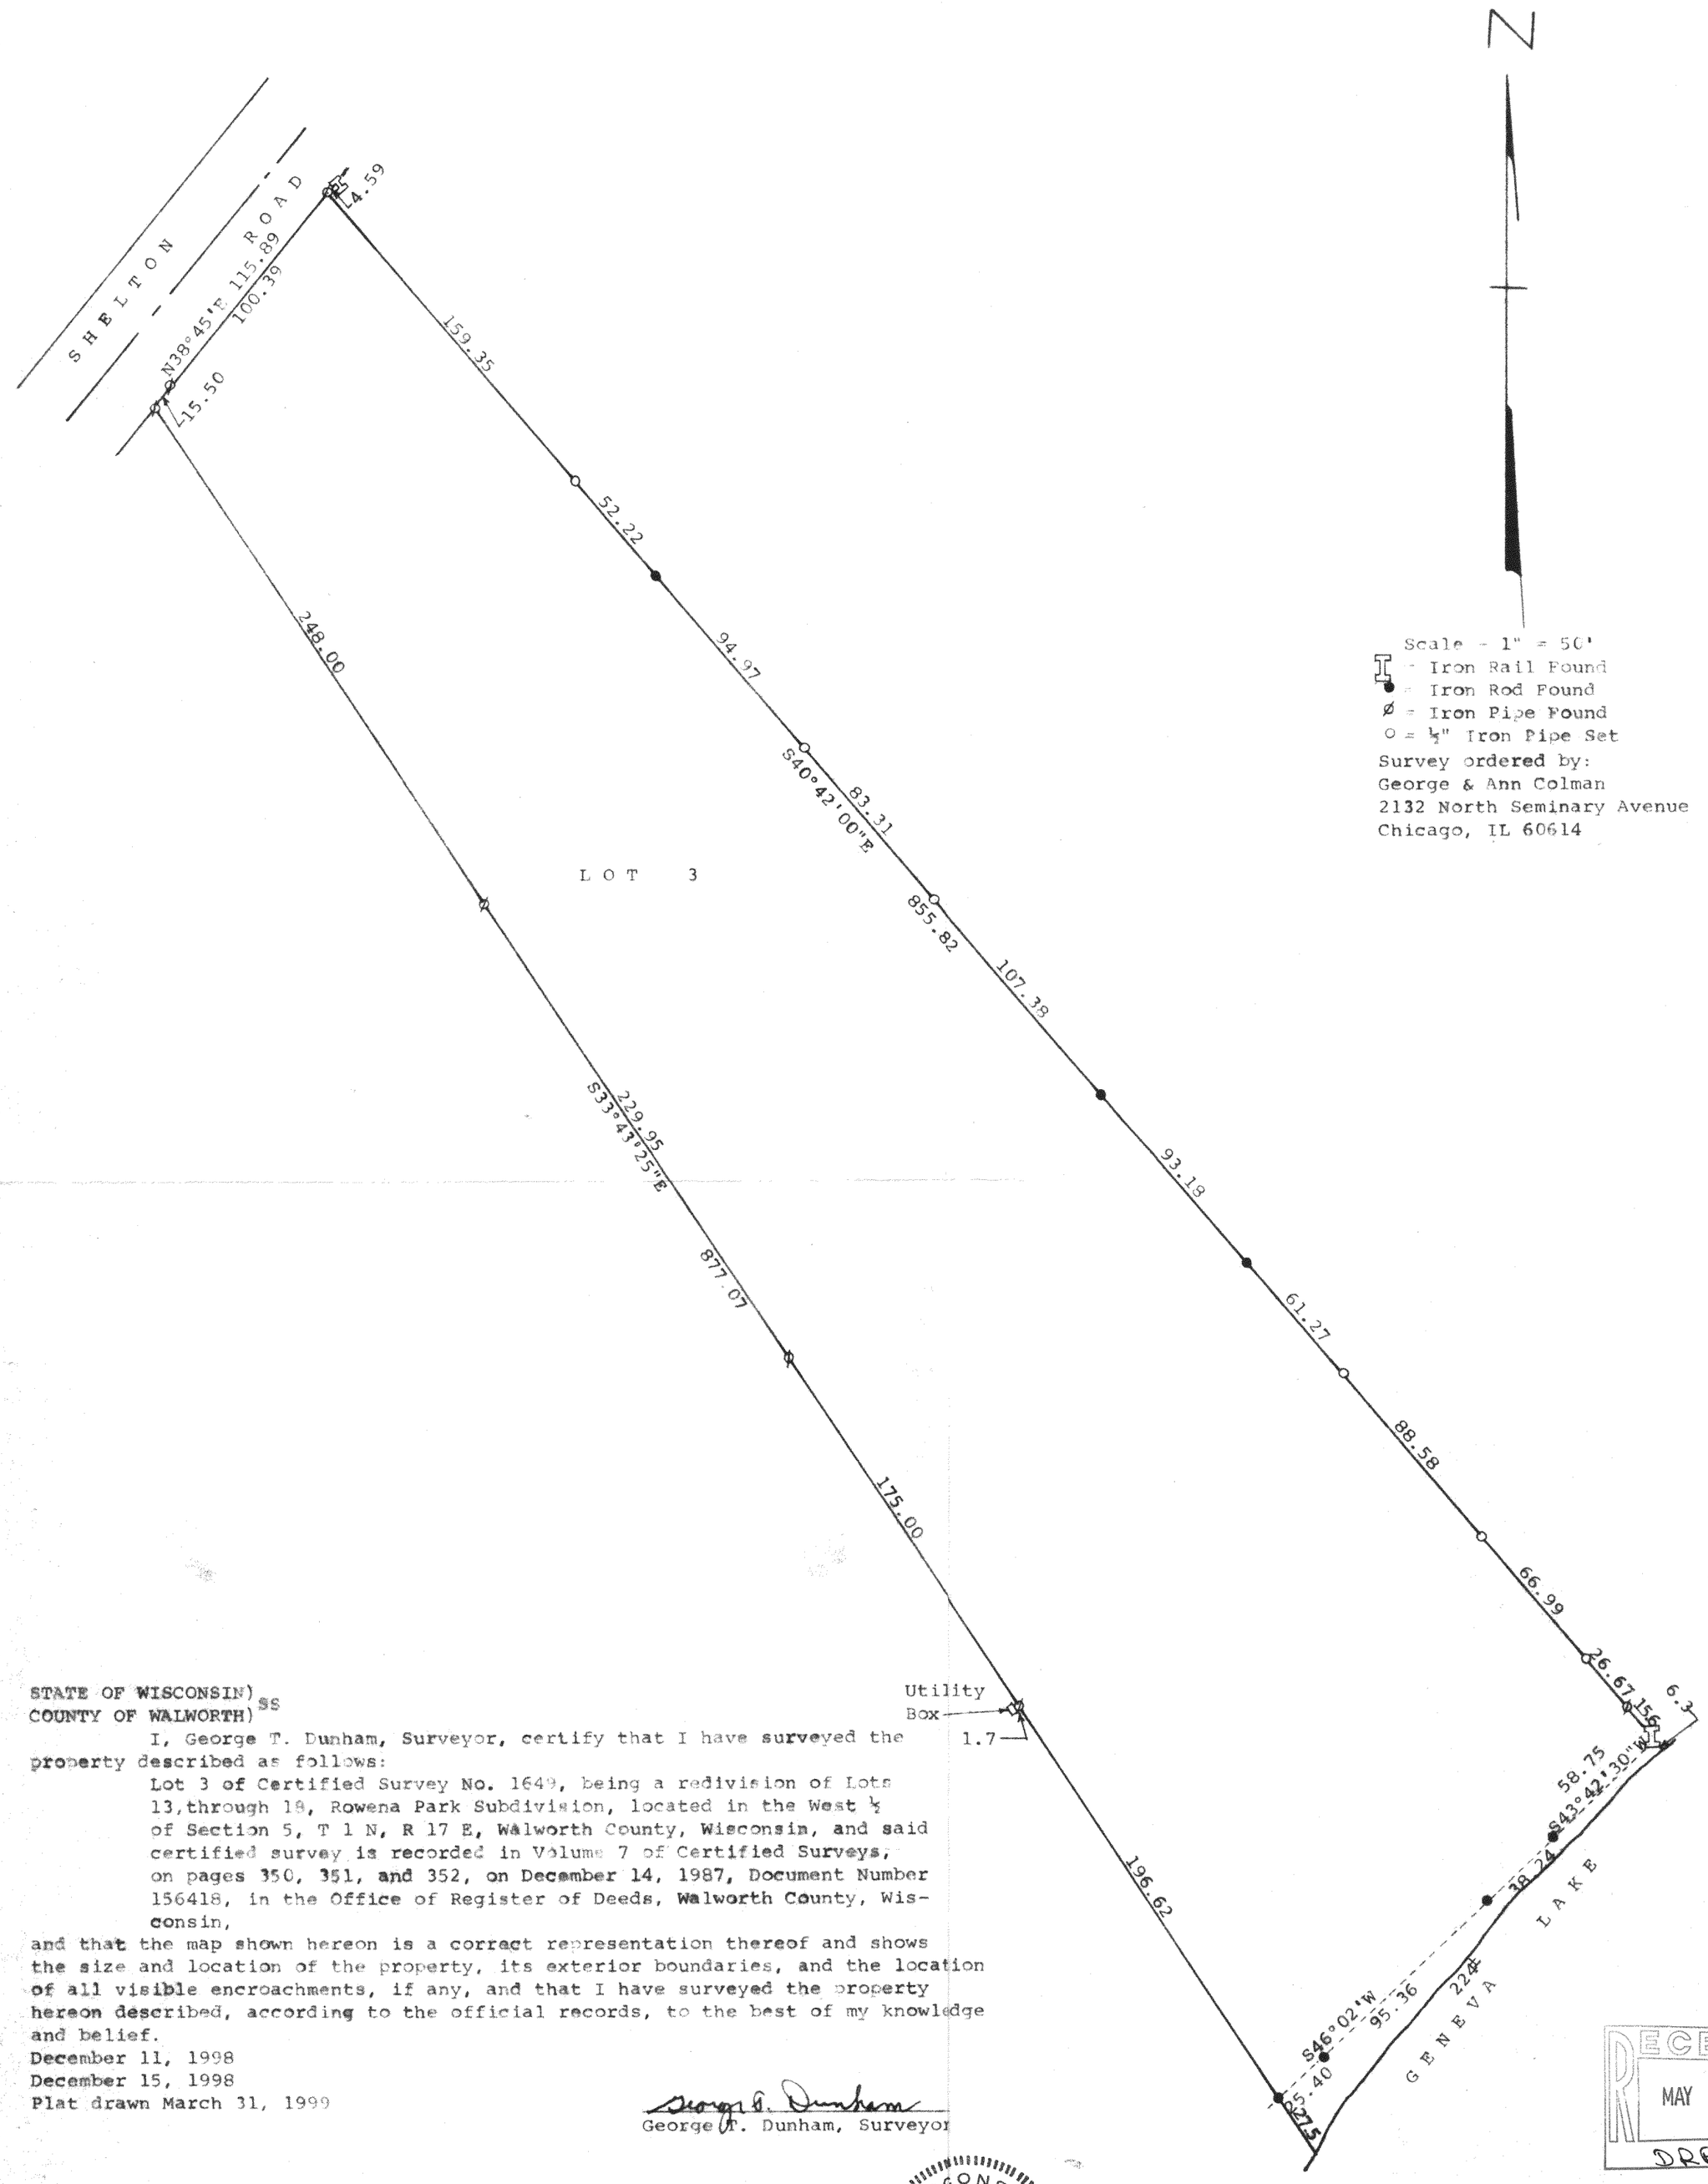

STATE OF WISCONSIN)
COUNTY OF WALWORTH) SS

I, George T. Dunham, Surveyor, certify that I have surveyed the property described as follows:

Lot 3 of Certified Survey No. 1649, being a redivision of Lots 13, through 18, Rowena Park Subdivision, located in the West ½ of Section 5, T 1 N, R 17 E, Walworth County, Wisconsin, and said certified survey is recorded in Volume 7 of Certified Surveys, on pages 350, 351, and 352, on December 14, 1987, Document Number 156418, in the Office of Register of Deeds, Walworth County, Wisconsin,

and that the map shown hereon is a correct representation thereof and shows the size and location of the property, its exterior boundaries, and the location of all visible encroachments, if any, and that I have surveyed the property hereon described, according to the official records, to the best of my knowledge and belief.

December 11, 1998
December 15, 1998
Plat drawn March 31, 1999

George T. Dunham, Surveyor

WISCONSIN LAND SURVEYOR
GEORGE T. DUNHAM
S-306
DELAVAN WIS.

RECEIVED
MAY 9 2003
DRP

GMB 1020

IA1649-3

117-2287