PLAT OF SURVEY
-- OF--

LOT 46 IN BLOCK "J" OF CISCO BEACH SUBDIVISION, ACCORDING TO THE RECORDED PLAT THEREOF, TOWNSHIP OF LINN, WALWORTH COUNTY, WISCONSIN.

SURVEY FOR: ROSSELAND REALTY
SURVEY ADDRESS: 2443 CISCO ROAD

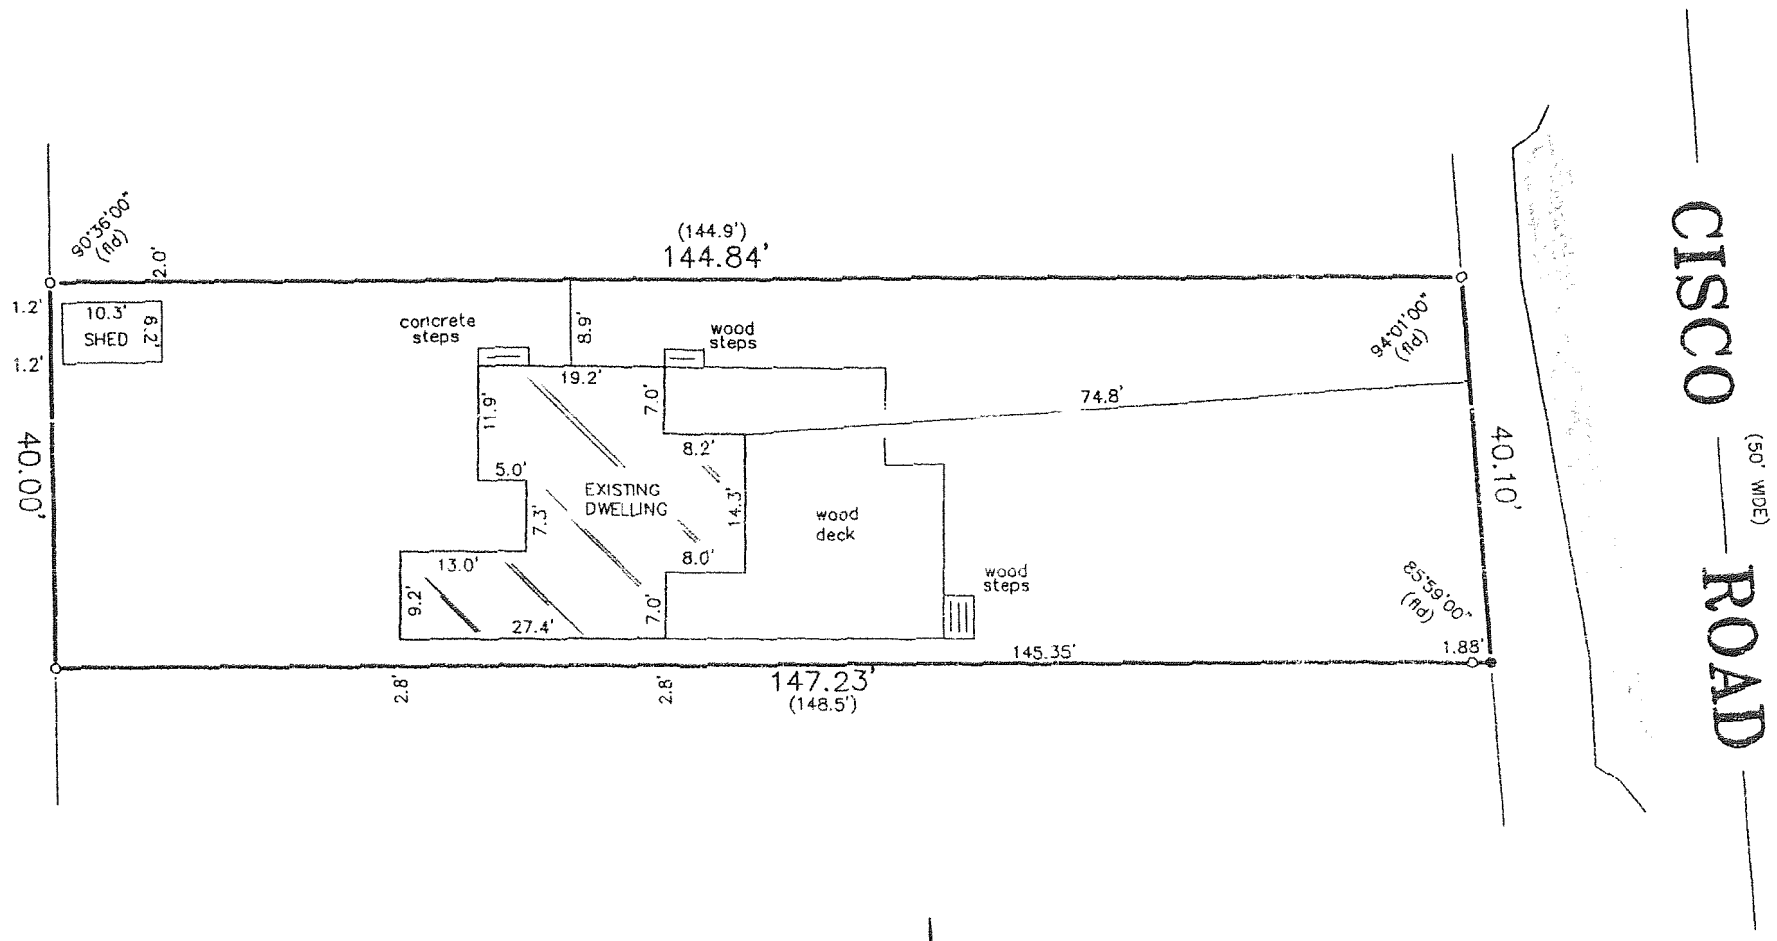

SCALE: 1" = 20'

LEGEND

- o FOUND IRON PIPE
- • SET IRON PIPE
- ( ) PLAT DISTANCE

"I hereby certify that I have surveyed the above described property and that the above map is a correct representation thereof and shows the size and location of the property, its exterior boundaries, the location of all visible structures and dimensions of all principal buildings thereon, boundary fences, apparent easements, roadways and encroachments, if any."

"This survey is made for the use of the present owners of the property, and those who purchase, mortgage, or guarantee the title thereto within one year from date hereof."

RECEIVED
JUL 10 2006
SMF

WISCONSIN
ROBERT J. WETZEL
S-1778
BURLINGTON WIS.
LAND SURVEYOR

THIS IS NOT AN ORIGINAL PRINT UNLESS THIS SEAL IS RED.

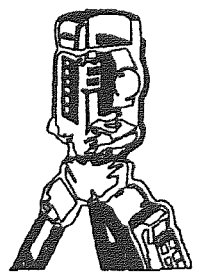

B.W. SURVEYING, INC.
LAND SURVEYS
MAPPING AND PLANNING
412 N. PINE STREET
BURLINGTON, WI 53105
(262)-767-0225

Robert J. Wetzel
ROBERT J. WETZEL S-1778

MARCH 21, 2006
DATE

7215
JOB NUMBER

1C1 - 243A

117-2700