PREPARED FOR
PATTY BUNGERT
580 S. OAK KNOLL DR.
LAKE FOREST IL. 60045

PLAT OF SURVEY

-OF-

LOT 1 CERTIFIED SURVEY MAP NO. 1194 LOCATED IN THE NORTHEAST 1/4 OF SECTION 11 AND THE NORTHWEST 1/4 OF SECTION 12, TOWN 1 NORTH, RANGE 17 EAST, WALWORTH COUNTY, WISCONSIN.

KROTT SURVEYING INC.
N3705 WILLOW BEND LANE
LAKE GENEVA WI. 53147
PHONE # (262)248-3697
FAX # (262)249-0639

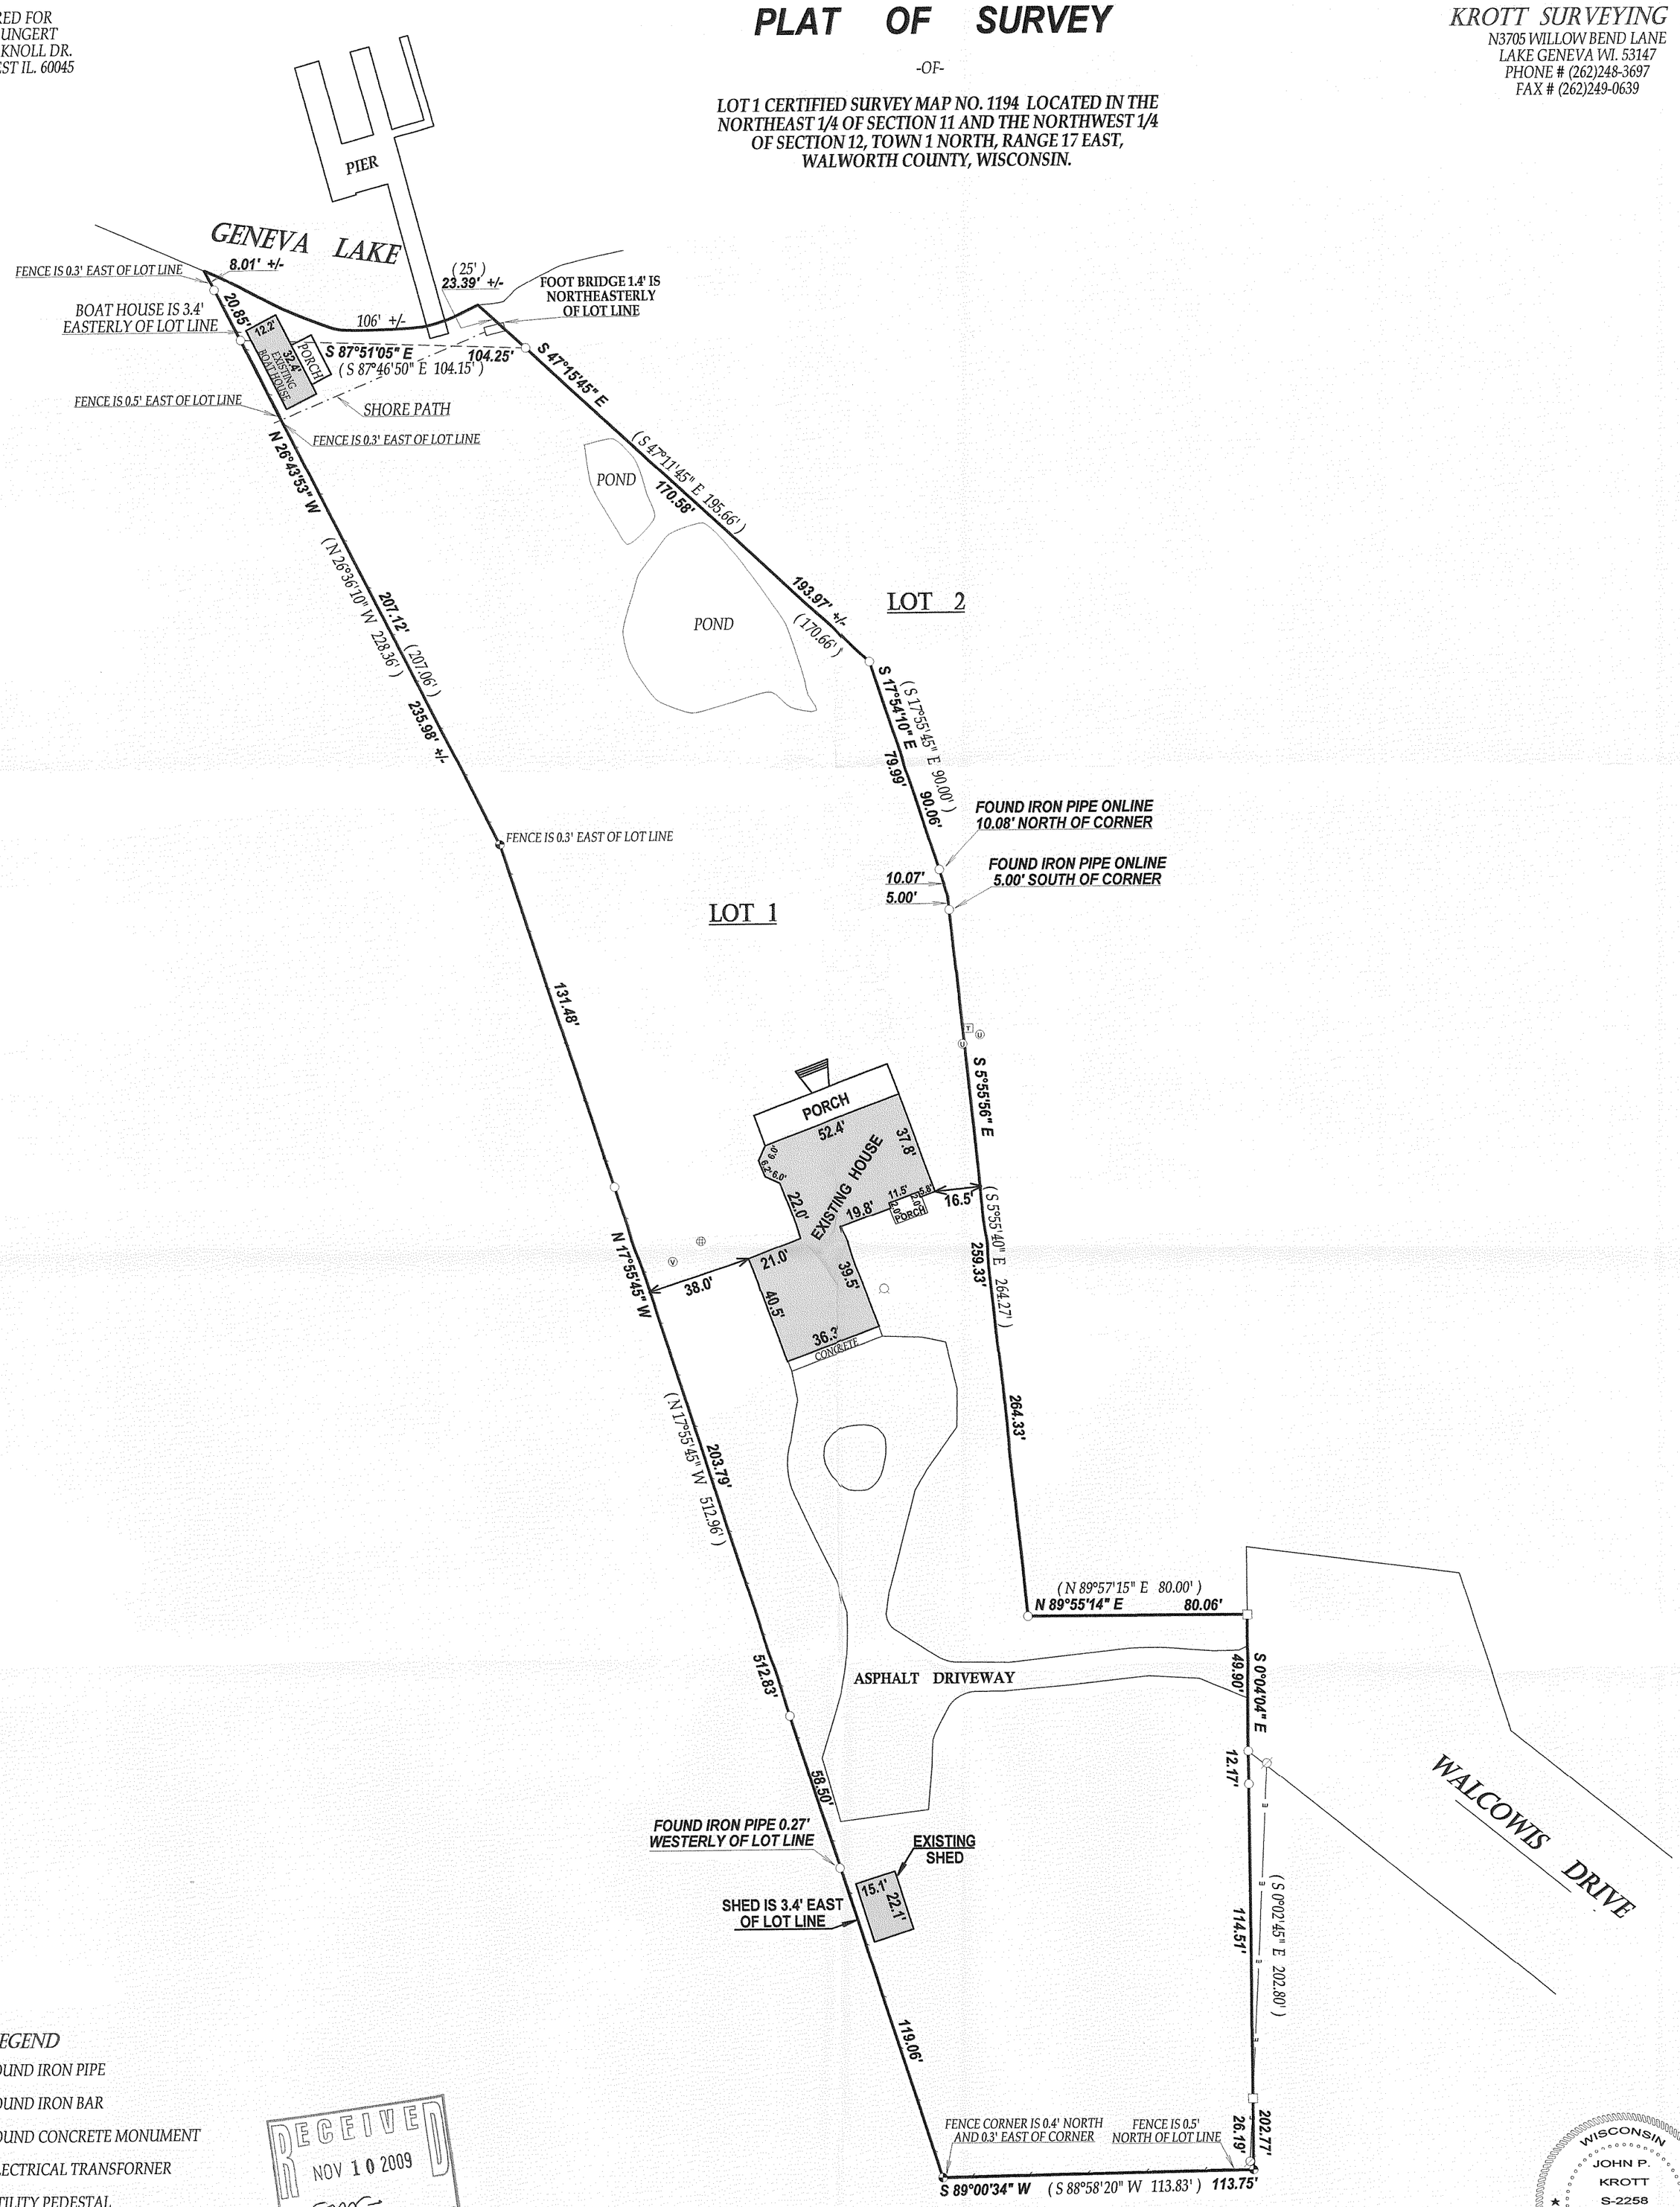

LEGEND

- ○ FOUND IRON PIPE
- □ FOUND IRON BAR
- FOUND CONCRETE MONUMENT
- ELECTRICAL TRANSFORMER
- UTILITY PEDESTAL
- WELL
- CONCRETE LID
- UTILITY POLE
- OVERHEAD WIRES
- VENT
- (XX) RECORDED AS

TAX ID # IA119400001
JOB # 09-153

RECEIVED
NOV 10 2009
By

N
W E
S

SCALE 1" = 40'
0 40 80 120 160 200

I have surveyed the above-described property and the above map is a true representation thereof and shows the size and location of the property, its exterior boundaries, the location and dimensions of all structures thereon, fences apparent easements and roadways and visible encroachments. if any.

This survey is made for the exclusive use of the present owners of the property, and also those who puchase, mortgage,or insure the title therto within one (1) year from date hereof; and as to them I warrant the accuracy of said survey map.

NOTE : BEARINGS REFRENCED TO C.S.M. # 1194.

WISCONSIN
JOHN P.
KROTT
S-2258
LAKE GENEVA
WIS.
LAND SURVEYOR

JOHN KROTT S - 2258
Wisconsin Registered Land Surveyor
(original if signed in red)

DATED THIS 27th DAY OF OCTOBER 2009.

117-3102