


PREPARED FOR  
BRENT CIRCLE  
3250 SEDGE PL.  
NAPLES FL. 34105

RIPARIAN RIGHTS SURVEY

-OF-

PART OF LOT 12 SYLVAN TRAIL ESTATES AND THE  
PATH AS SHOWN ON SYLVAN TRAIL ESTATES,  
LOCATED IN SECTION 2, TOWN 1 NORTH, RANGE  
17 EAST, WALWORTH COUNTY, WISCONSIN.

KROTT SURVEYING INC.  
N3705 WILLOW BEND LANE  
LAKE GENEVA WI. 53147  
PHONE # (262)248-3697  
FAX # (262)249-0639


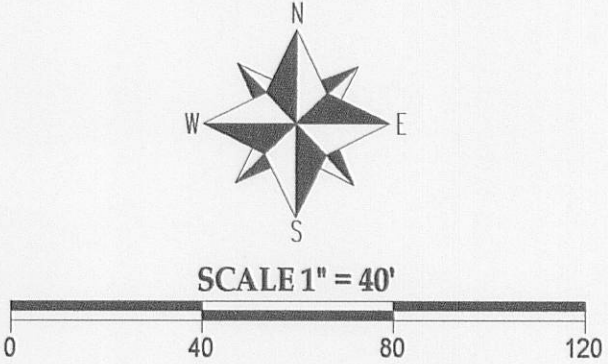


- LEGEND
- FOUND IRON PIPE
  - FOUND IRON BAR
  - FOUND IRON PIPE IN CONCRETE

(xx) RECORDED AS  
TAX ID # IST00004A

JOB # 11-046 RIPUD

NOTE: BEARINGS ARE REFERENCED TO THE EAST LINE OF  
SYLVAN TRAIL ESTATES AND WAS ASSUMED TO BEAR NORTH-SOUTH

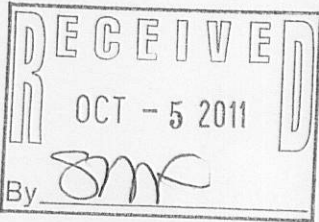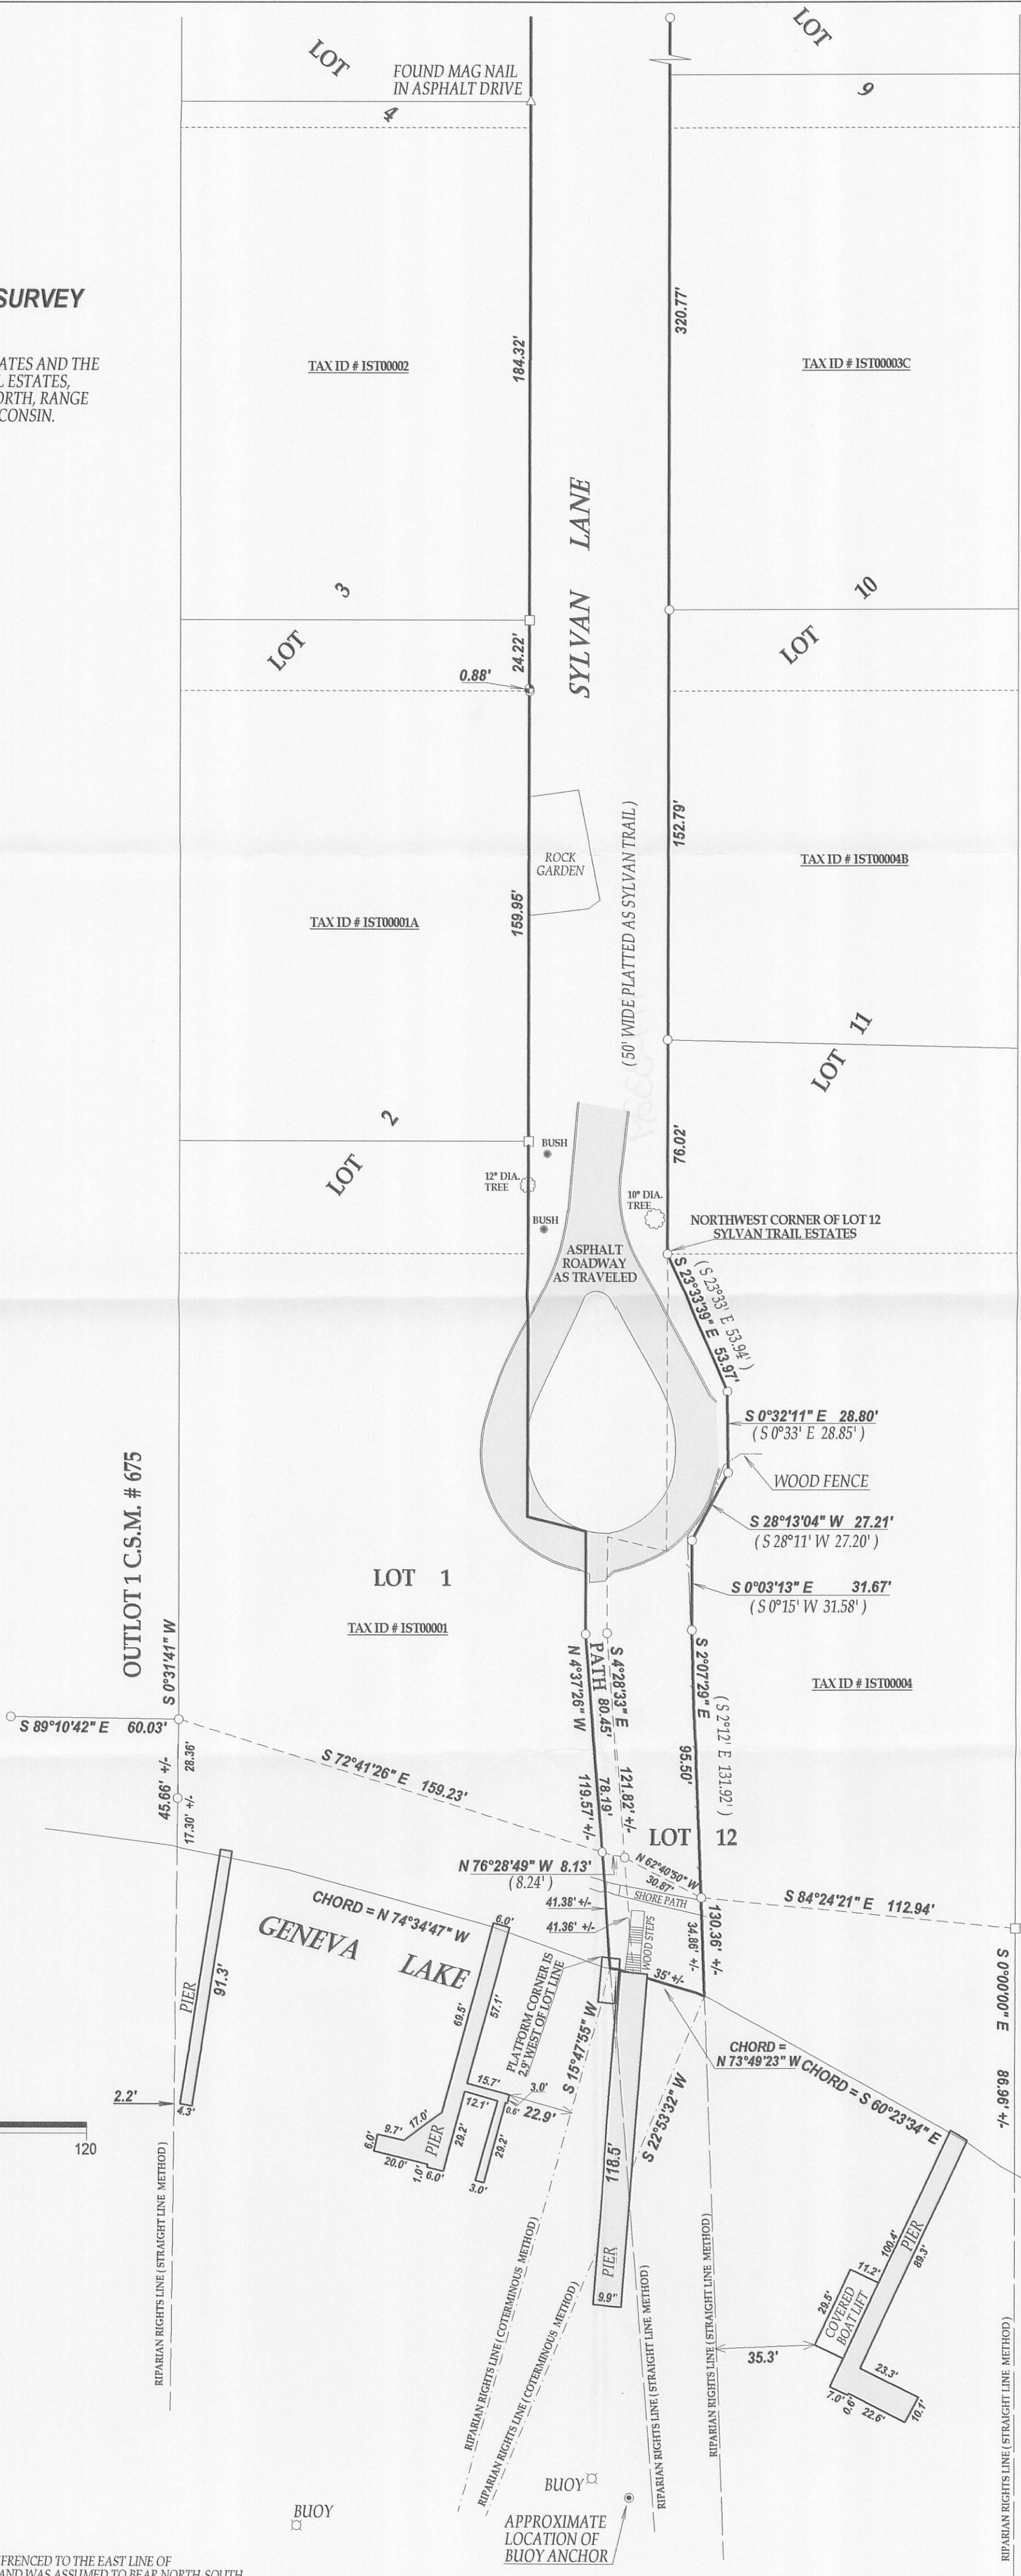

DATED THIS 5th DAY OF APRIL 2011.  
DATE OF LAST REVISION 9/21/2011.

JOHN KROTT S - 2258  
Wisconsin Registered Land Surveyor  
(original if signed in red)

117-3339