


of


a subdivision located in Government Lot 3 in the Northwest 1/4 of Section 18, Town 1 North, Range 17 East, Town of Linn, Walworth County, Wisconsin.

Surveyed for:

N1508 Oak Shore Lane
Fontana, Wisconsin. 53125

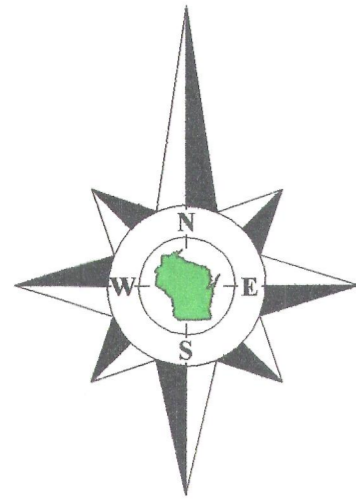

Bearings referenced to the East line of Oak Shore Lane recorded as North on the plat of Oak Shores.

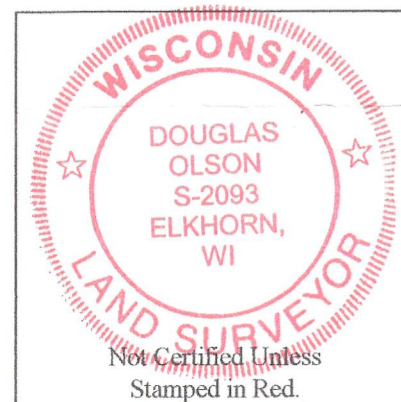

Notes:

- 1) This survey plat is not certified unless signed and sealed in red ink.
- 2) This survey is subject to Wisconsin lien laws. This Plat of Survey is the notice of intent to file lien. Lien waiver required.

Copyright 2011 by Jensen & Olson Land Surveying, LLC.


All rights reserved. No part of this survey plat may be reproduced or transmitted in any form by any means - graphic, electronic, or mechanical, including photocopying, tracing, or information storage and retrieval systems - without permission in writing from Douglas G. Olson, Jensen & Olson Land Surveying, LLC.

West 1/4 Corner
Section 18-1-17.
(N. 202,305.74)
(E. 2,393,315.73)

I hereby certify that I have surveyed the above described property and the map hereon is correct to the best of my professional knowledge and belief and shows the size and location of the property, its exterior boundaries, the location and dimensions of all visible structures thereon, boundary fences, apparent easements and roadways and visible encroachments, if any.

This survey is made for the exclusive use of the present owners of the property, and also those who purchase, mortgage or guarantee title thereto, within one year from the date hereof.

Douglas G. Olson
Wisconsin Registered Land Surveyor - 2093

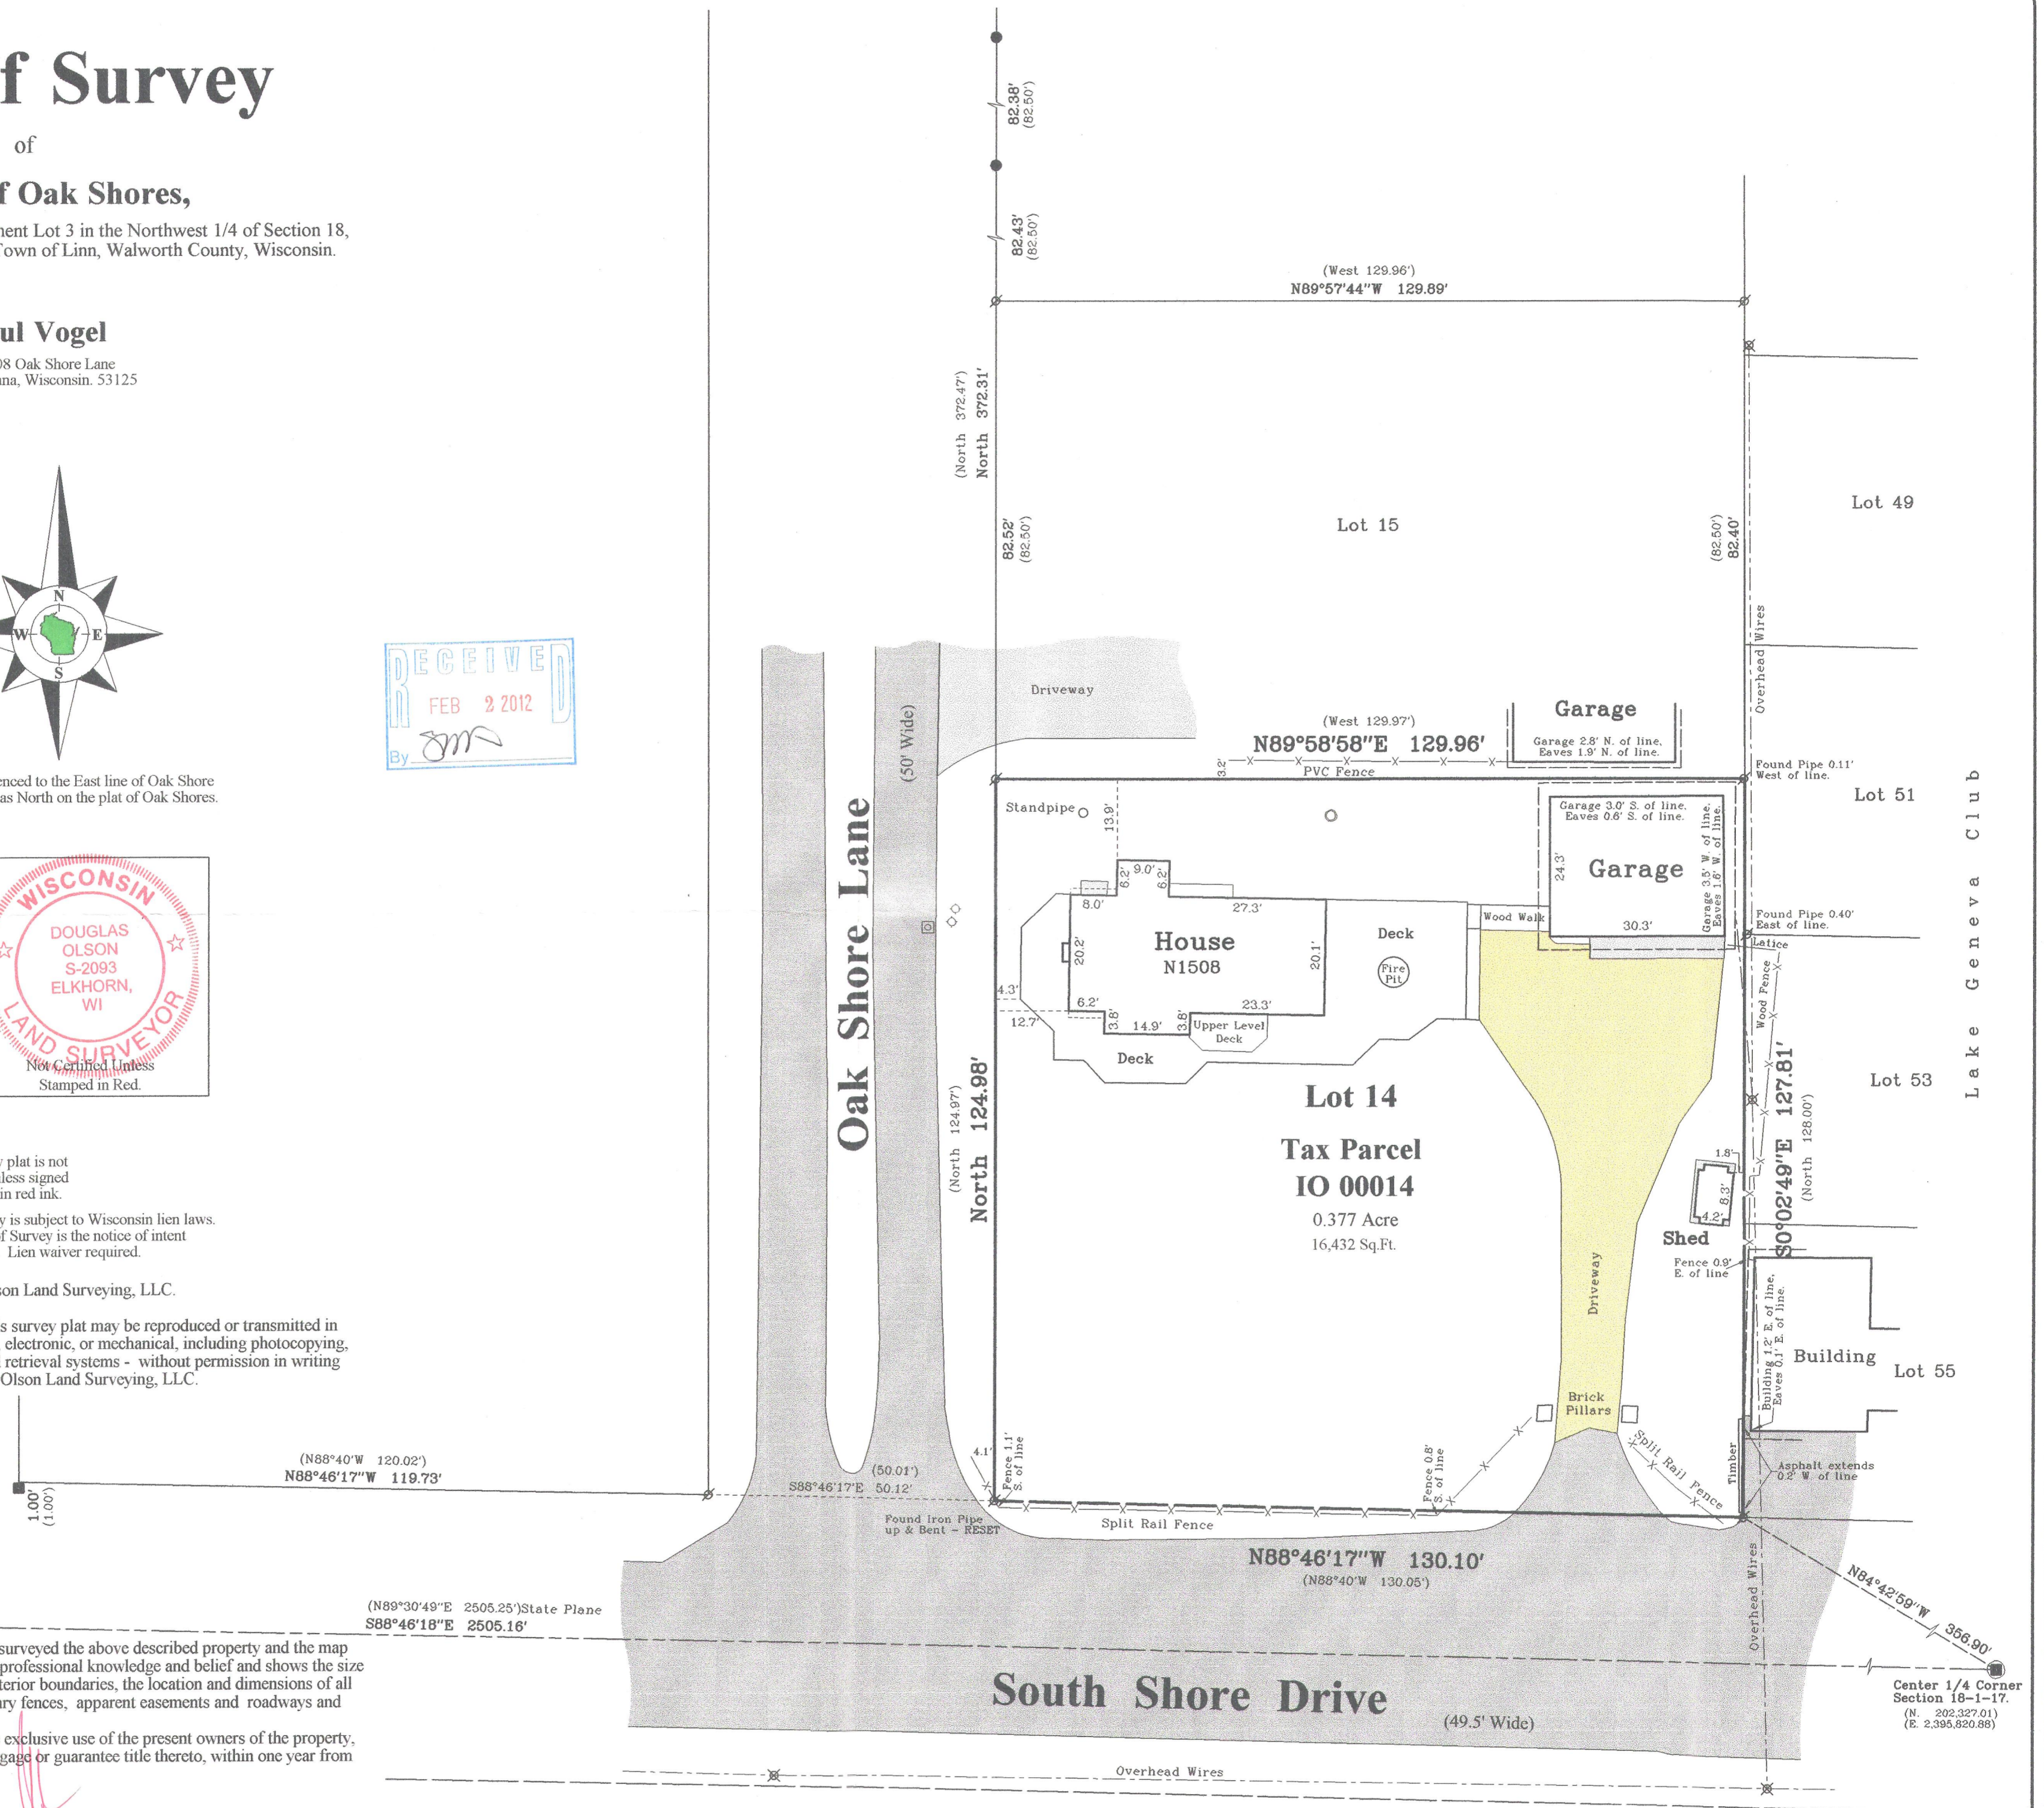

Survey Date: May 12, 2011.
Revisions:

Scale in Feet
1" = 20'

0' 10' 20' 40'

Jensen & Olson Land Surveying, LLC

Wisconsin Street * P.O. Box 322 * Elkhorn, Wisconsin. 53121
Telephone: (262) 723-3434 * Facsimile: (262) 723-8044
Email: jensen.olson@elknet.net

Legend

	Found County Section Corner		Utility Pole
	Found Concrete Monument		Water Valve
	Found Iron Pipe		Catch Basin
	Found Iron Rod		Asphalt Surface
	Recorded Information		Concrete Surface
	Concrete Cover		Gravel

Sheet 1 of 1 Sheets

Job Reference Number
2011.033

Drawing Name: thlr17e-2011033-2011033Plat.scj

2011.033