PREPARED FOR
BORDER CARPENTRY
N2623 SCHOFIELD RD.
LAKE GENEVA WI. 53147

# PLAT OF SURVEY

-OF-

LOTS 20, 21 AND 43 OF THE BIRCHES SECOND ADDITION,
TOWN 1 NORTH, RANGE 17 EAST, WALWORTH COUNTY, WISCONSIN.

KROTT SURVEYING INC.
N3705 WILLOW BEND LANE
LAKE GENEVA WI. 53147
PHONE # (262)248-3697
FAX # (262)249-0639

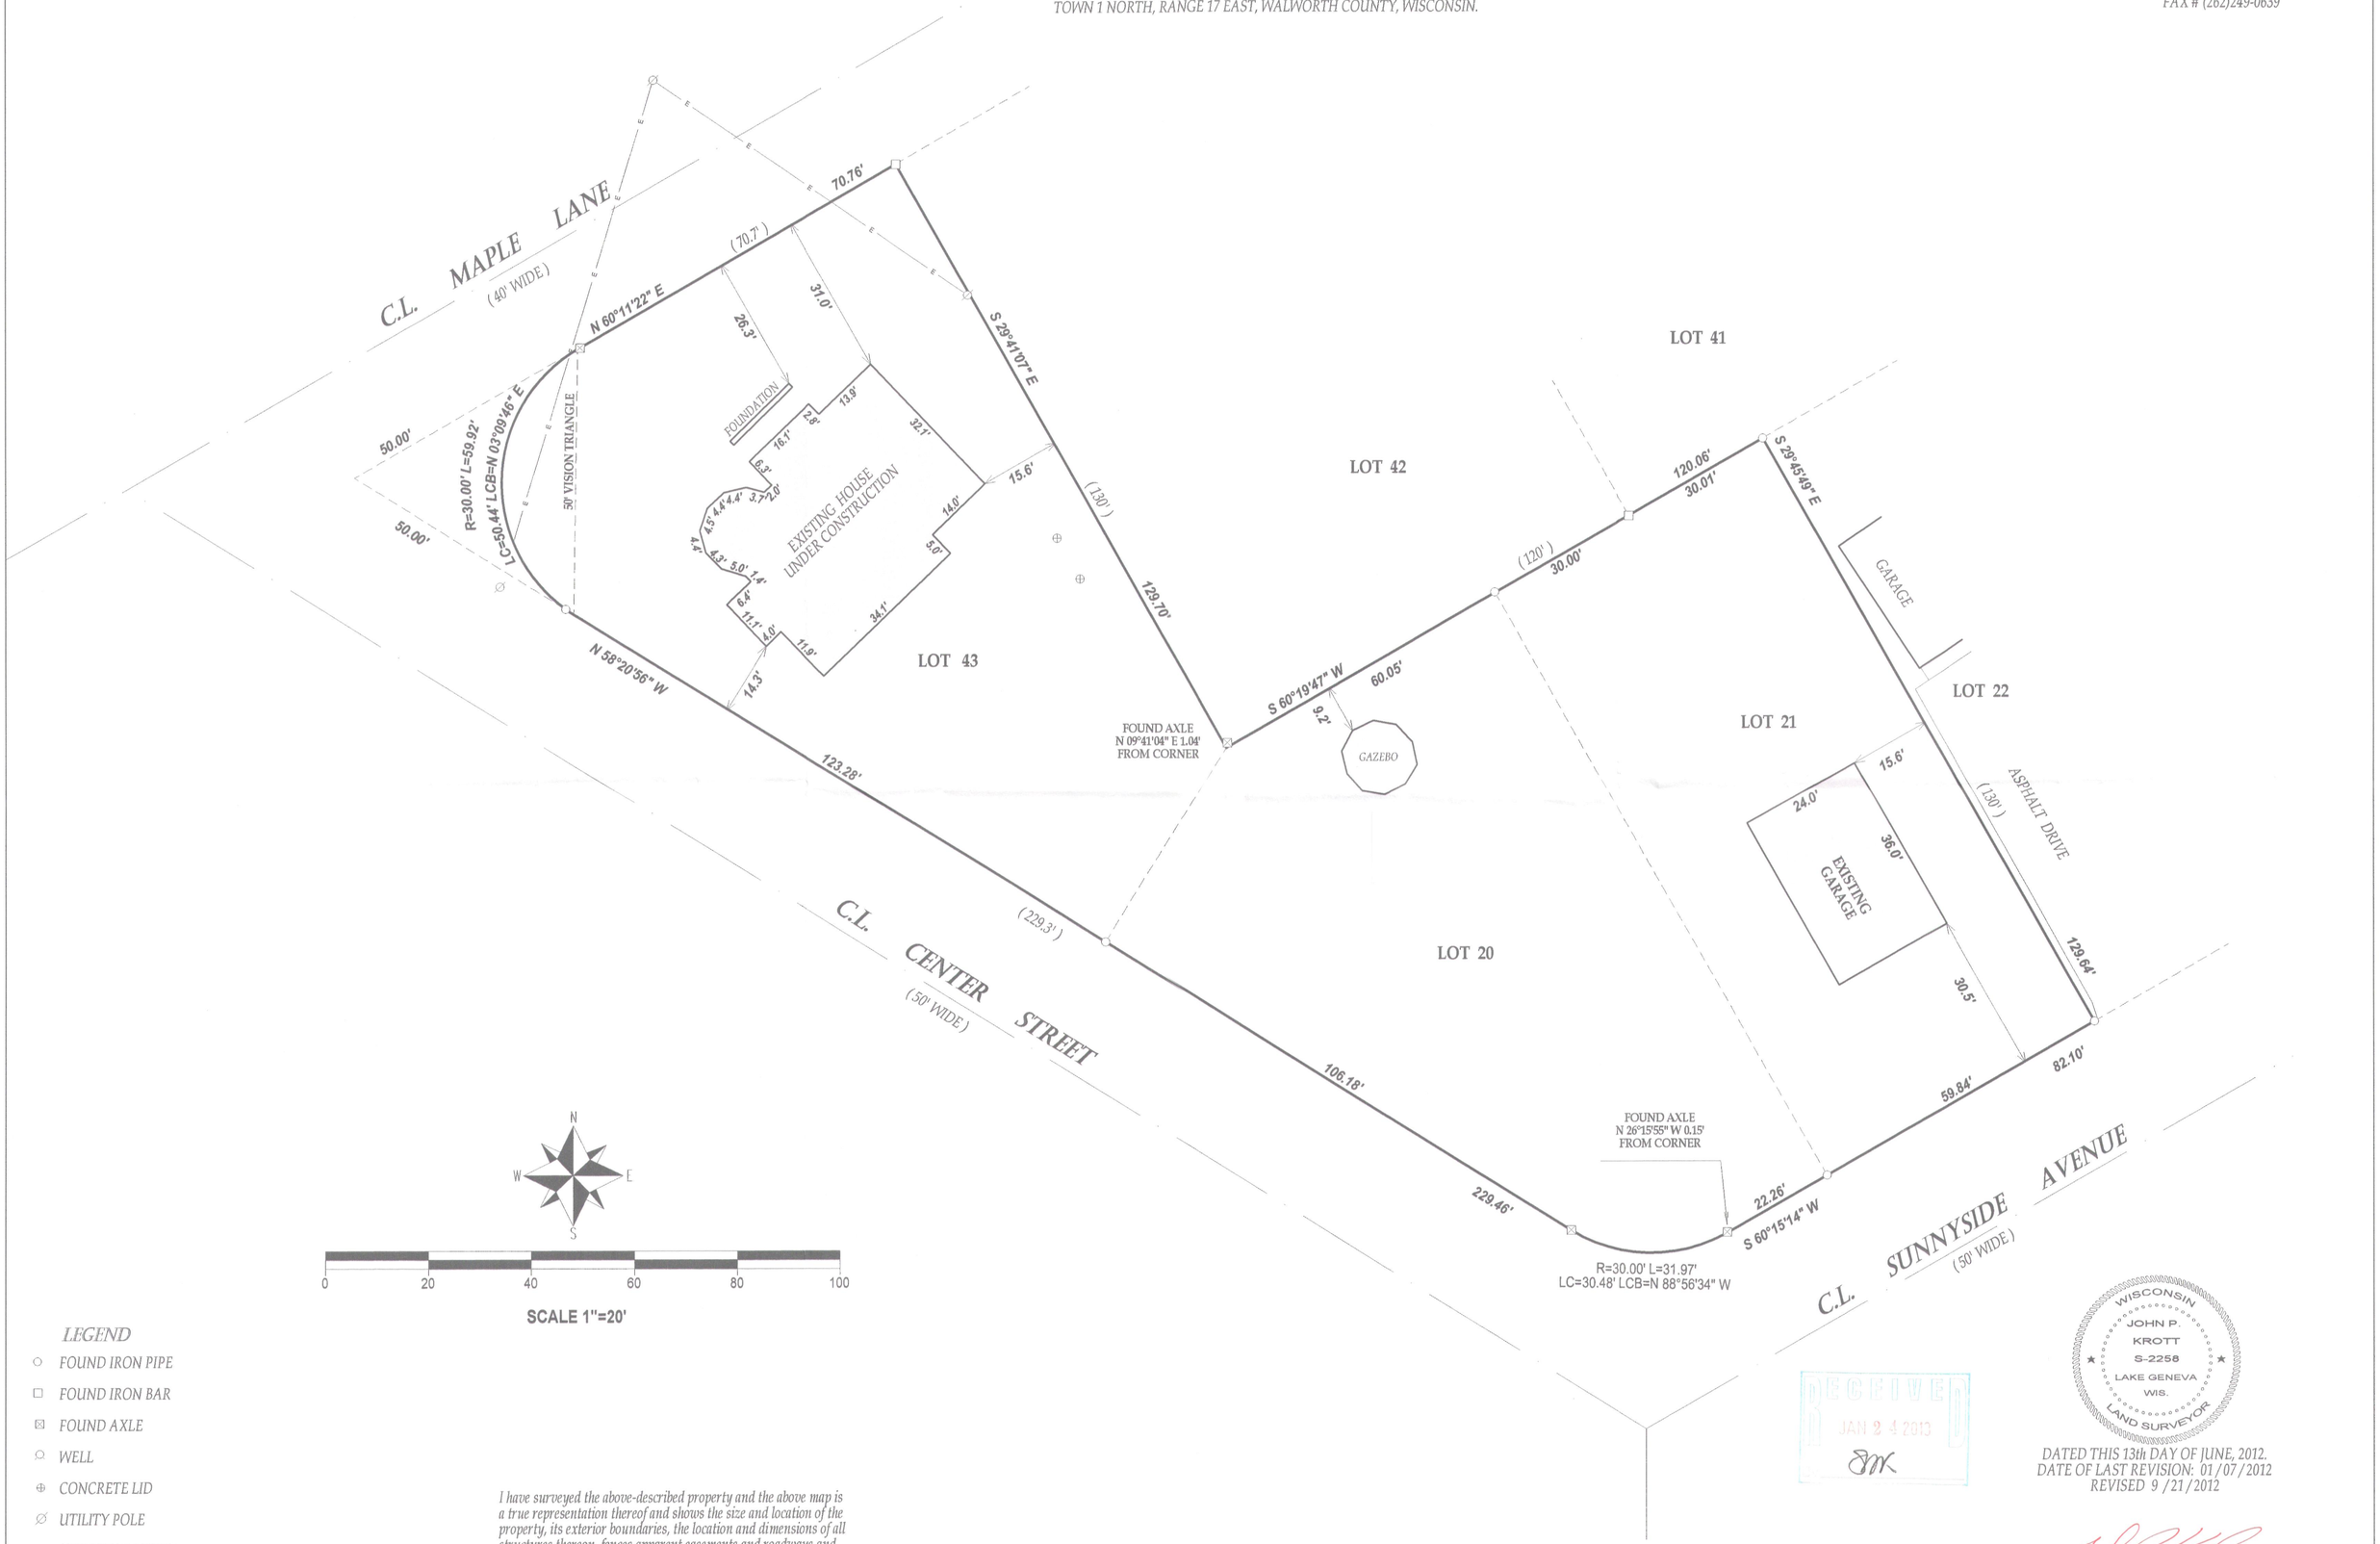


LEGEND

- ○ FOUND IRON PIPE
- □ FOUND IRON BAR
- ⊠ FOUND AXLE
- WELL
- ⊕ CONCRETE LID
- UTILITY POLE
- OVERHEAD WIRES
- (XX) RECORDED AS

TAX ID # IBA200007

JOB # 12-060PH

I have surveyed the above-described property and the above map is a true representation thereof and shows the size and location of the property, its exterior boundaries, the location and dimensions of all structures thereon, fences apparent easements and roadways and visible encroachments. if any.

This survey is made for the exclusive use of the present owners of the property, and also those who puchase, mortgage,or insure the title therto within one (1) year from date hereof, and as to them I warrant the accuracy of said survey map.

RECEIVED
JAN 2 4 2013

WISCONSIN
JOHN P. KROTT
S-2258
LAKE GENEVA WIS.
LAND SURVEYOR

DATED THIS 13th DAY OF JUNE, 2012.
DATE OF LAST REVISION: 01/07/2012
REVISED 9 /21/2012

JOHN KROTT S - 2258
Wisconsin Registered Land Surveyor
( original if signed in red )

117-3500