PLAT OF SURVEY
-OF-

LOTS 49, 50, AND 51, BLOCK 2, LAKEVIEW PARK, TOWN OF LINN, WALWORTH COUNTY, WISCONSIN.

SURVEY FOR: DEBBIE MCNICHOLS

SURVEY ADDRESS: W3833 LAKEVIEW PARK DR.

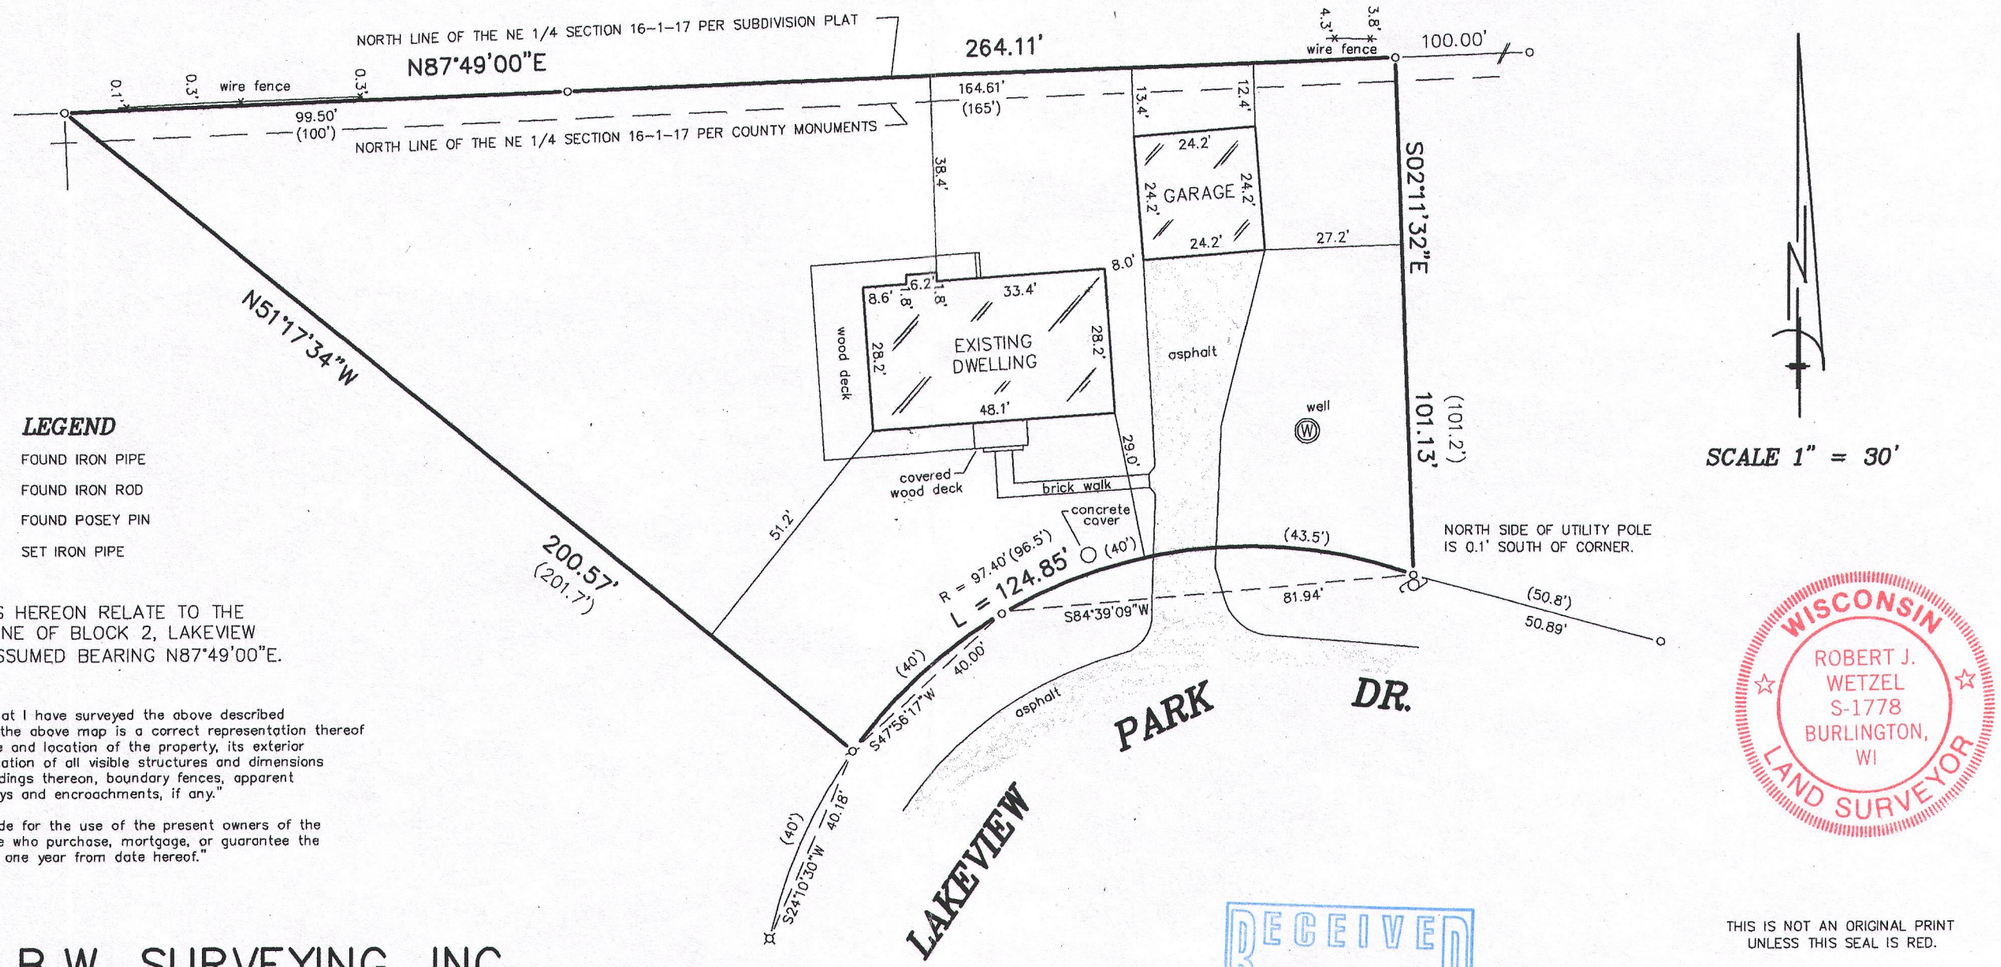

SCALE 1" = 30'

LEGEND

- o FOUND IRON PIPE
- ⌀ FOUND IRON ROD
- ⌘ FOUND POSEY PIN
- • SET IRON PIPE

BEARINGS HEREON RELATE TO THE NORTH LINE OF BLOCK 2, LAKEVIEW PARK. ASSUMED BEARING N87°49'00"E.

"I hereby certify that I have surveyed the above described property and that the above map is a correct representation thereof and shows the size and location of the property, its exterior boundaries, the location of all visible structures and dimensions of all principal buildings thereon, boundary fences, apparent easements, roadways and encroachments, if any."

"This survey is made for the use of the present owners of the property, and those who purchase, mortgage, or guarantee the title thereto within one year from date hereof."

WISCONSIN
ROBERT J. WETZEL
S-1778
BURLINGTON, WI
LAND SURVEYOR

RECEIVED
APR 27 2015
By

THIS IS NOT AN ORIGINAL PRINT UNLESS THIS SEAL IS RED.

B.W. SURVEYING, INC.
LAND SURVEYS
MAPPING AND PLANNING
412 N. PINE STREET
BURLINGTON, WI 53105
(262)-767-0225

Robert J. Wetzel
ROBERT J. WETZEL S-1778

MARCH 23, 2015
DATE

8886
JOB NUMBER

ILVP-8C 117-3763