

Plat of Survey



of
Lots 2, 3, 4 & 5 in Block 14
of Wooddale Addition,

a subdivision located in the Northwest 1/4 of Section 16,
Town 1 North, Range 17 East, Town of Linn, Walworth
County, Wisconsin.


Surveyed for:

RE/MAX Geneva Realty, Ltd.

101 Broad Street * Suite 102
Lake Geneva, Wisconsin. 53147

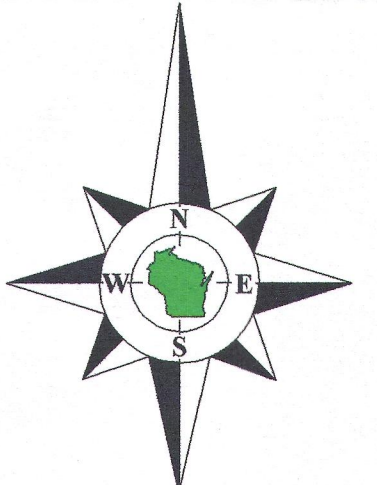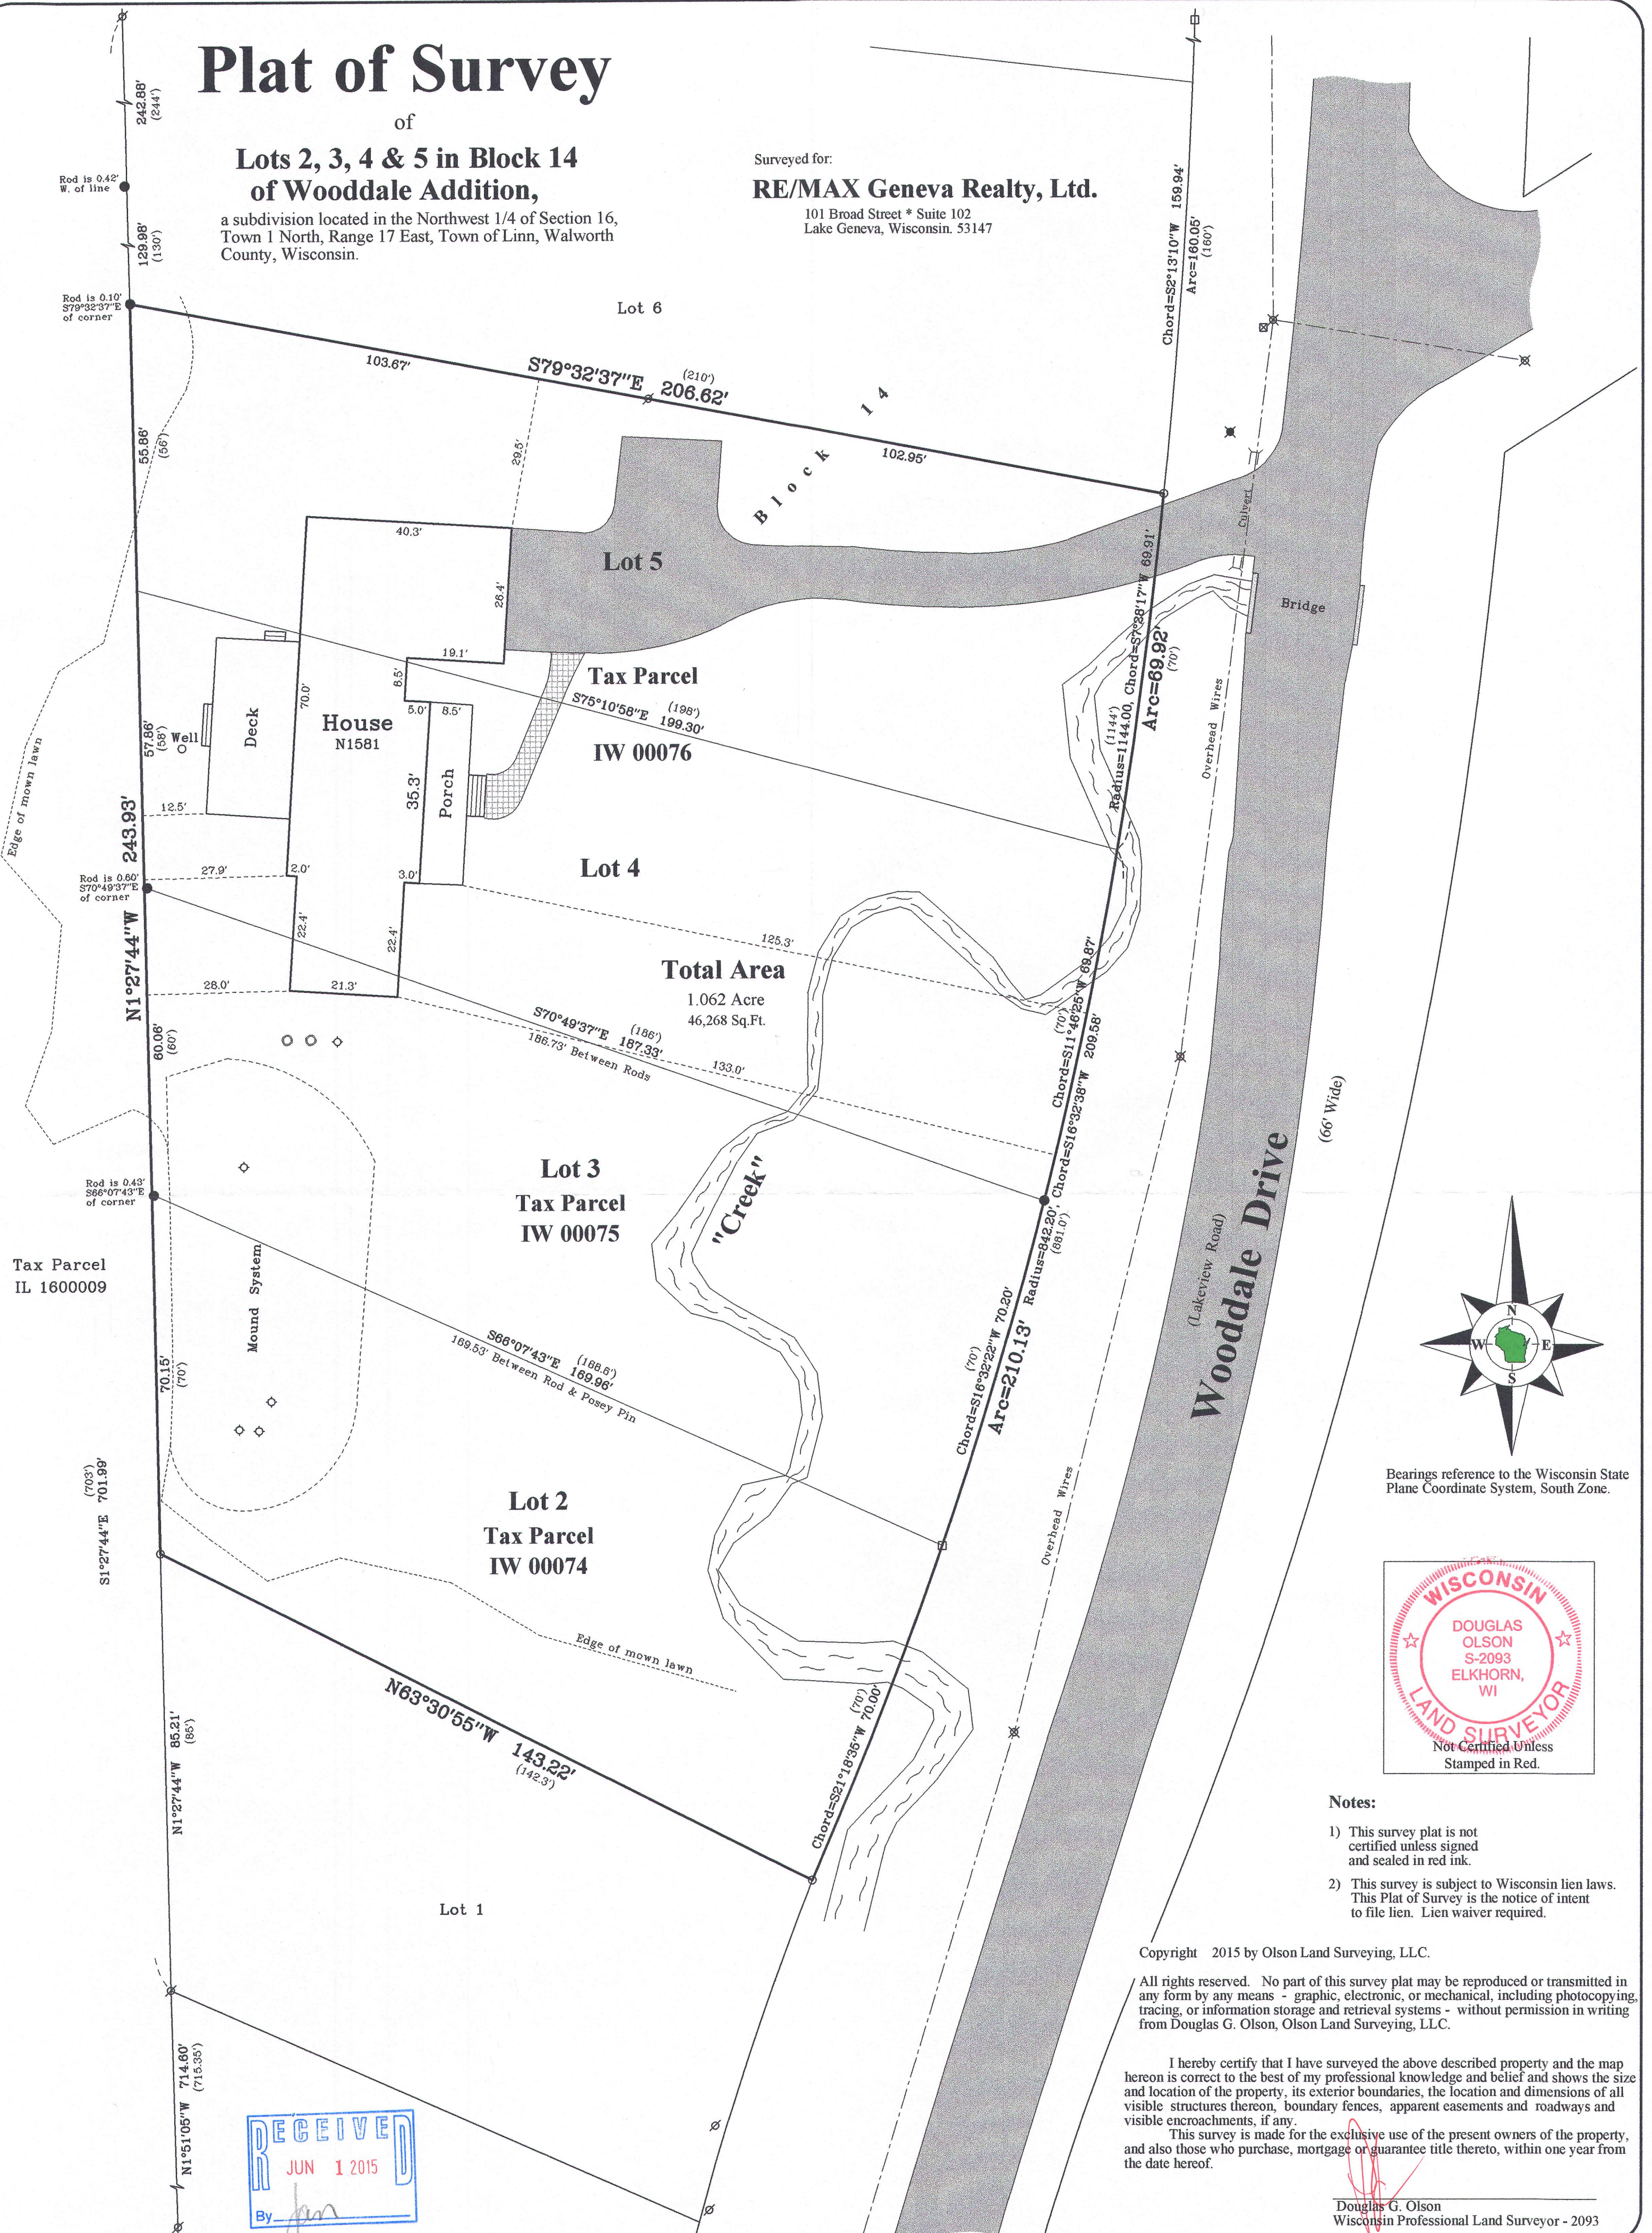

Bearings reference to the Wisconsin State
Plane Coordinate System, South Zone.

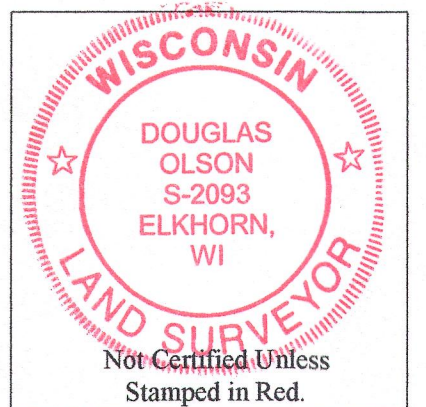

Notes:

- This survey plat is not certified unless signed and sealed in red ink.
- This survey is subject to Wisconsin lien laws. This Plat of Survey is the notice of intent to file lien. Lien waiver required.

Copyright 2015 by Olson Land Surveying, LLC.

All rights reserved. No part of this survey plat may be reproduced or transmitted in any form by any means - graphic, electronic, or mechanical, including photocopying, tracing, or information storage and retrieval systems - without permission in writing from Douglas G. Olson, Olson Land Surveying, LLC.

I hereby certify that I have surveyed the above described property and the map hereon is correct to the best of my professional knowledge and belief and shows the size and location of the property, its exterior boundaries, the location and dimensions of all visible structures thereon, boundary fences, apparent easements and roadways and visible encroachments, if any.

This survey is made for the exclusive use of the present owners of the property, and also those who purchase, mortgage or guarantee title thereto, within one year from the date hereof.

Douglas G. Olson
Wisconsin Professional Land Surveyor - 2093

2015.032

Sheet 1 of 1 Sheets

Drawing Name:

Job Reference Number

2015.032

Legend

- Found Iron Pipe
- Found Iron Rod
- Found Posey Pin
- Set Iron Pipe, 1" dia.
- Recorded Information
- Utility Pole
- Concrete Cover
- Septic Vent
- Asphalt Surface
- Brick Pavers
- Pedestal



Olson Land Surveying, LLC


45 South Wisconsin Street * P.O. Box 322 * Elkhorn, Wisconsin. 53121

Telephone: (262) 723-3434 * Facsimile: (262) 723-8044

Email: doug@olsonsurveying.com

Scale in Feet

1" = 20'

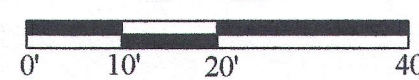

Survey Date: May 19, 2015.

Revisions:

IW-74

IW-75 117-3789

IW-76