PREPARED FOR
ROGER ODALEN

ORDERED BY
LEGENDARY REAL
ESTATE SERVICES

PLAT OF SURVEY

Lot 6 and South 1/2 of Lot 5, Odden Park Subdivision, in the Northwest 1/4 of the Northwest 1/4 of Section 4, Township 1 North, Range 17 East of the Fourth Principal Meridian, in the Town of Linn, Walworth County, Wisconsin.

PATHFINDER SURVEYING
(a NMB Company)
1458 HORIZON BLVD. STE. 200
RACINE, WI. 53406
WWW.PATHFINDERSURVEYING.NET
262-248-8303

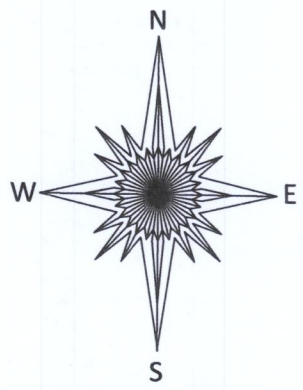

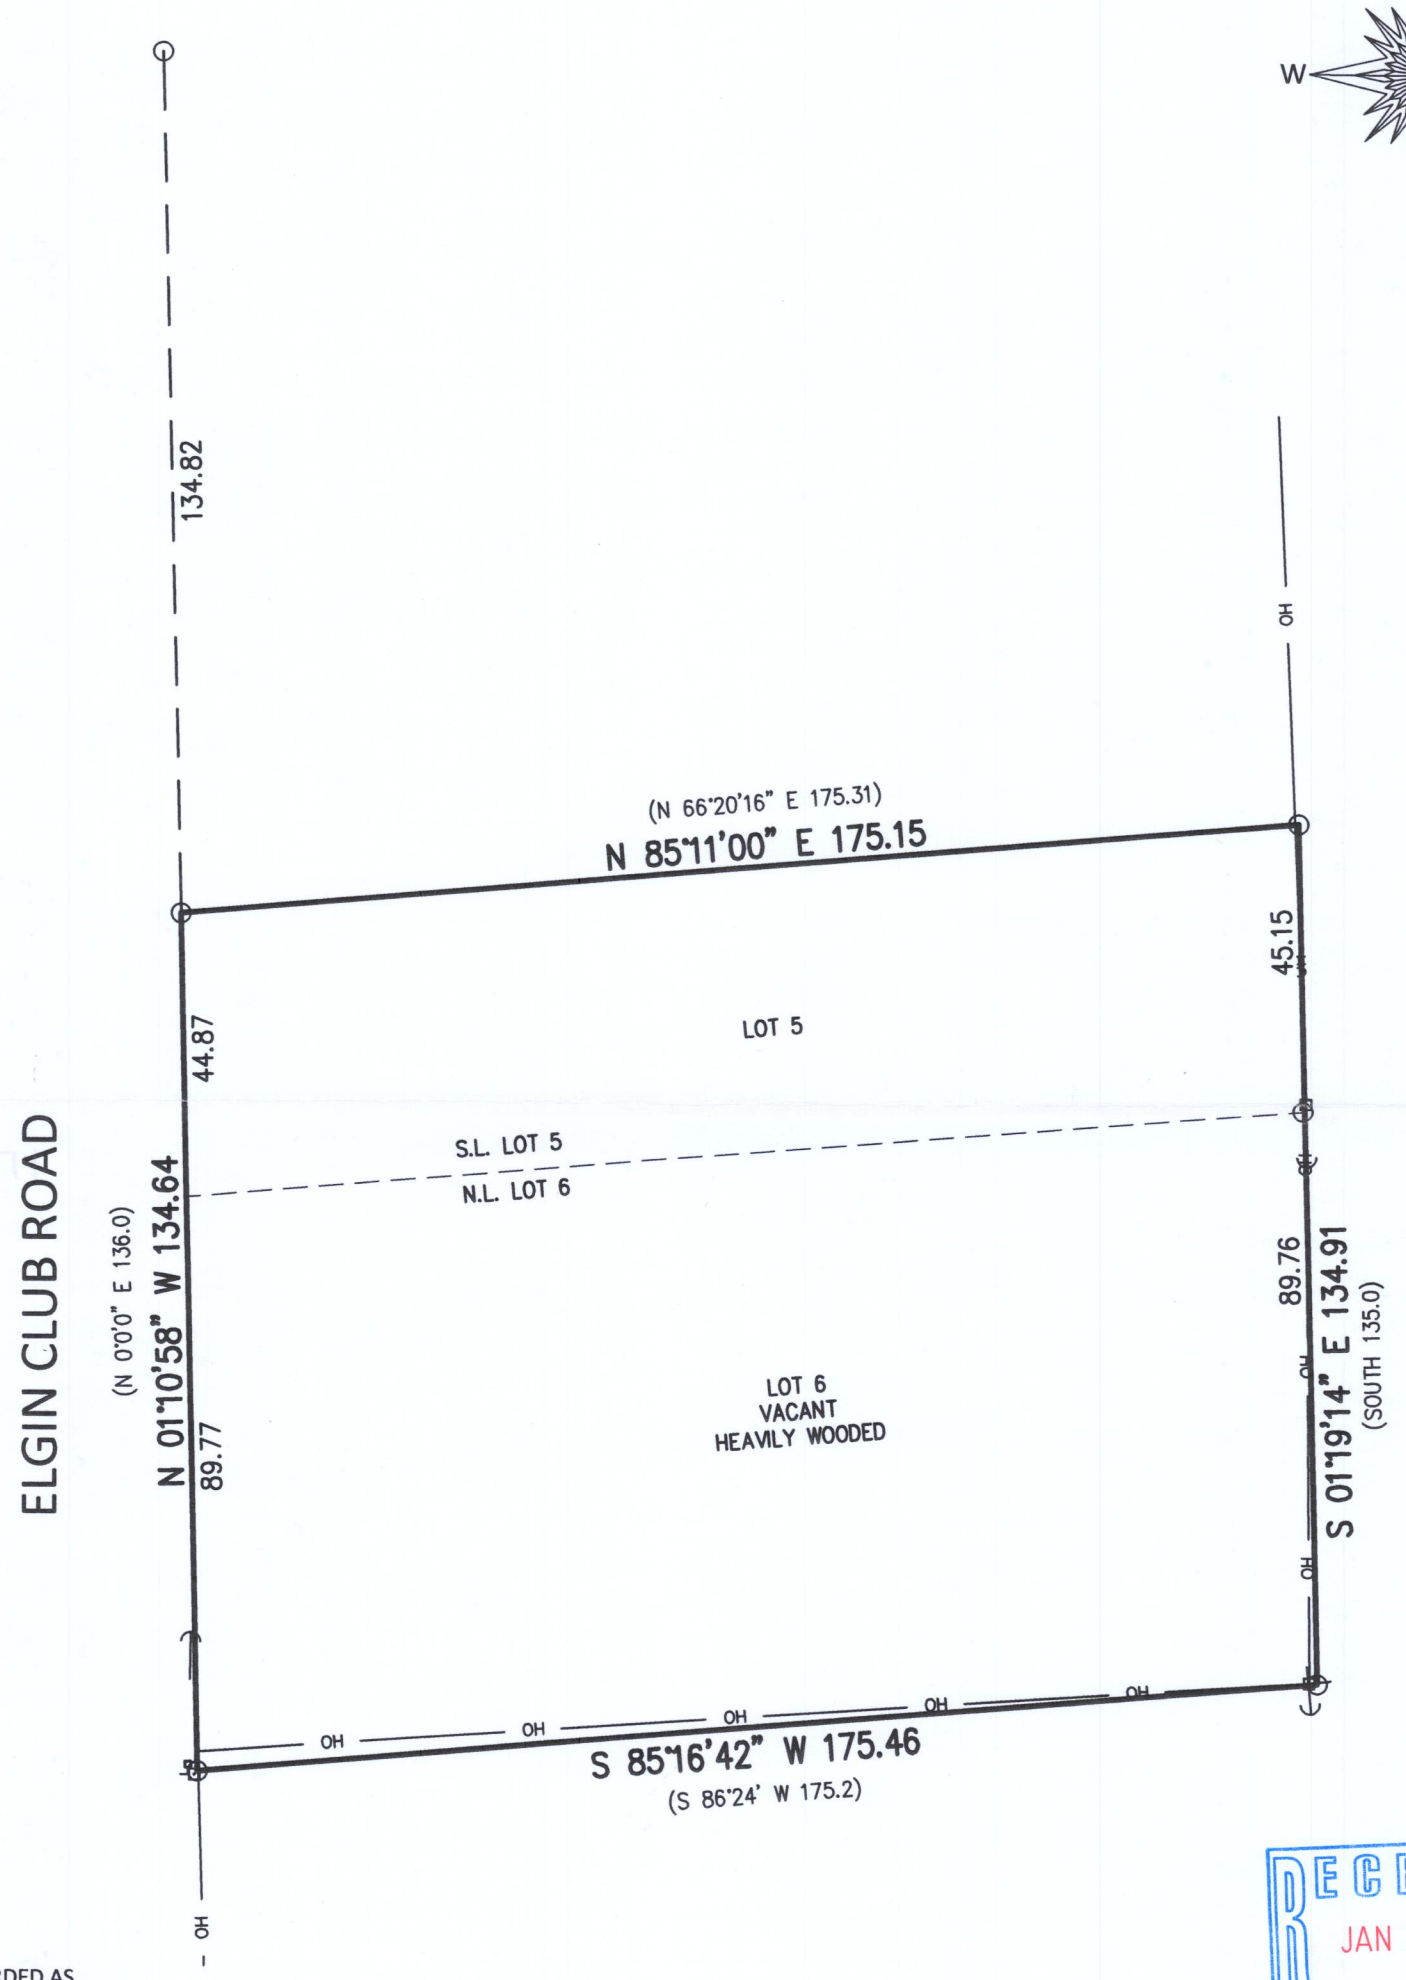

( ) RECORDED AS
○ 1 1/4" FOUND IRON PIPE
⊠ 2" FOUND IRON PIPE
—OH— OVERHEAD WIRES
□ COMMUNICATION BOX
POWER POLE
GUY WIRE

SCALE 1" = 30'

JOB # 2020.0232.01

TAX ID # IOP 00004A

30 0 30 60 90

Basis of Bearing of this plat: The US State Plane Coordinate System South Zone, NAD 83. WISCORS.

I hereby certify that I have surveyed the above- described property and the above map is a is a true representation thereof and shows the size and location of the property, its exterior boundaries, the location and dimensions of all structures thereon, fences, apparent easements and roadways and visible encroachments if any to the best of my knowledge and belief.

This survey is made for the present owners of the property, and those who purchase, mortgage, or guarantee the title thereto, within one year from the date hereof.

Dated this 8th day of October, 2020.

RECEIVED
JAN 19 2021
By SMF

WISCONSIN
MARK R. MADSEN
S-2271
RACINE, WI
LAND SURVEYOR

MARK R. MADSEN S - 2271
Wisconsin Professional Land Surveyor

IOP-4A

117-4426