

Legal Description:	Tax ID: IL 60045
Lot 5, Academy Estates, Township of Linn, as per the recorded plat thereof in Vol. 18 of Plats on pages 18 and 19 of Document No. 694770, in the Office of the Register of Deeds in and for Walworth County, Wisconsin	

# Plat of Survey for Steve Schwefel

N. Creekside Lane, Lake Geneva, WI



Project No.

Drawn By: TJM  
Field Work: LG



**LYNCH & ASSOCIATES**  
ENGINEERING CONSULTANTS, LLC












  


5482 S. WESTRIDGE DRIVE  
NEW BERLIN, WI 53151

440 MILWAUKEE AVENUE  
BURLINGTON, WI 53105

(262) 402-5040

 


Legend:

- |   |                      |
|---|----------------------|
|    | Found 1" Iron Pipe   |
|    | Electric Transformer |
|    | Electric Meter       |
|    | Air Conditioner      |
|    | Telephone Pedestal   |
|    | Utility Pedestal     |
|    | Utility Manhole      |
|    | Septic Vent          |
|    | Well                 |
|    | Gas Meter            |
|    | Air Conditioner      |
|    | Flag Pole            |
|   | Light Pole           |
| CMP = Corrugated Metal Pipe   |                      |
|  | Retaining Wall       |

*I have surveyed the above-described property and the above map is a true representation thereof and shows the size and location of the property, its exterior boundaries, the location and dimensions of all structures thereon, fences, apparent easements and roadways, and visible encroachments, if any.*

*No title commitment or results of a title search were provided to this office pertaining to this survey. This Plat of Survey may not reflect easements of record, encumbrances, restrictions, ownership, title evidence, or other facts that a current and accurate title search may disclose.*

*This survey is made for the exclusive use of the present owners of the property, and also those who purchase, mortgage, or insure the title thereto within one (1) year from date hereof; and as to them I warrant the accuracy of said survey map.*

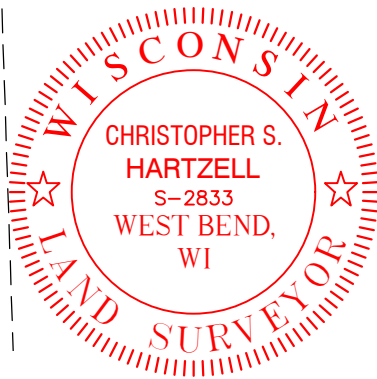

  
Christopher S. Hartzell, Professional Land Surveyor, S-2833