


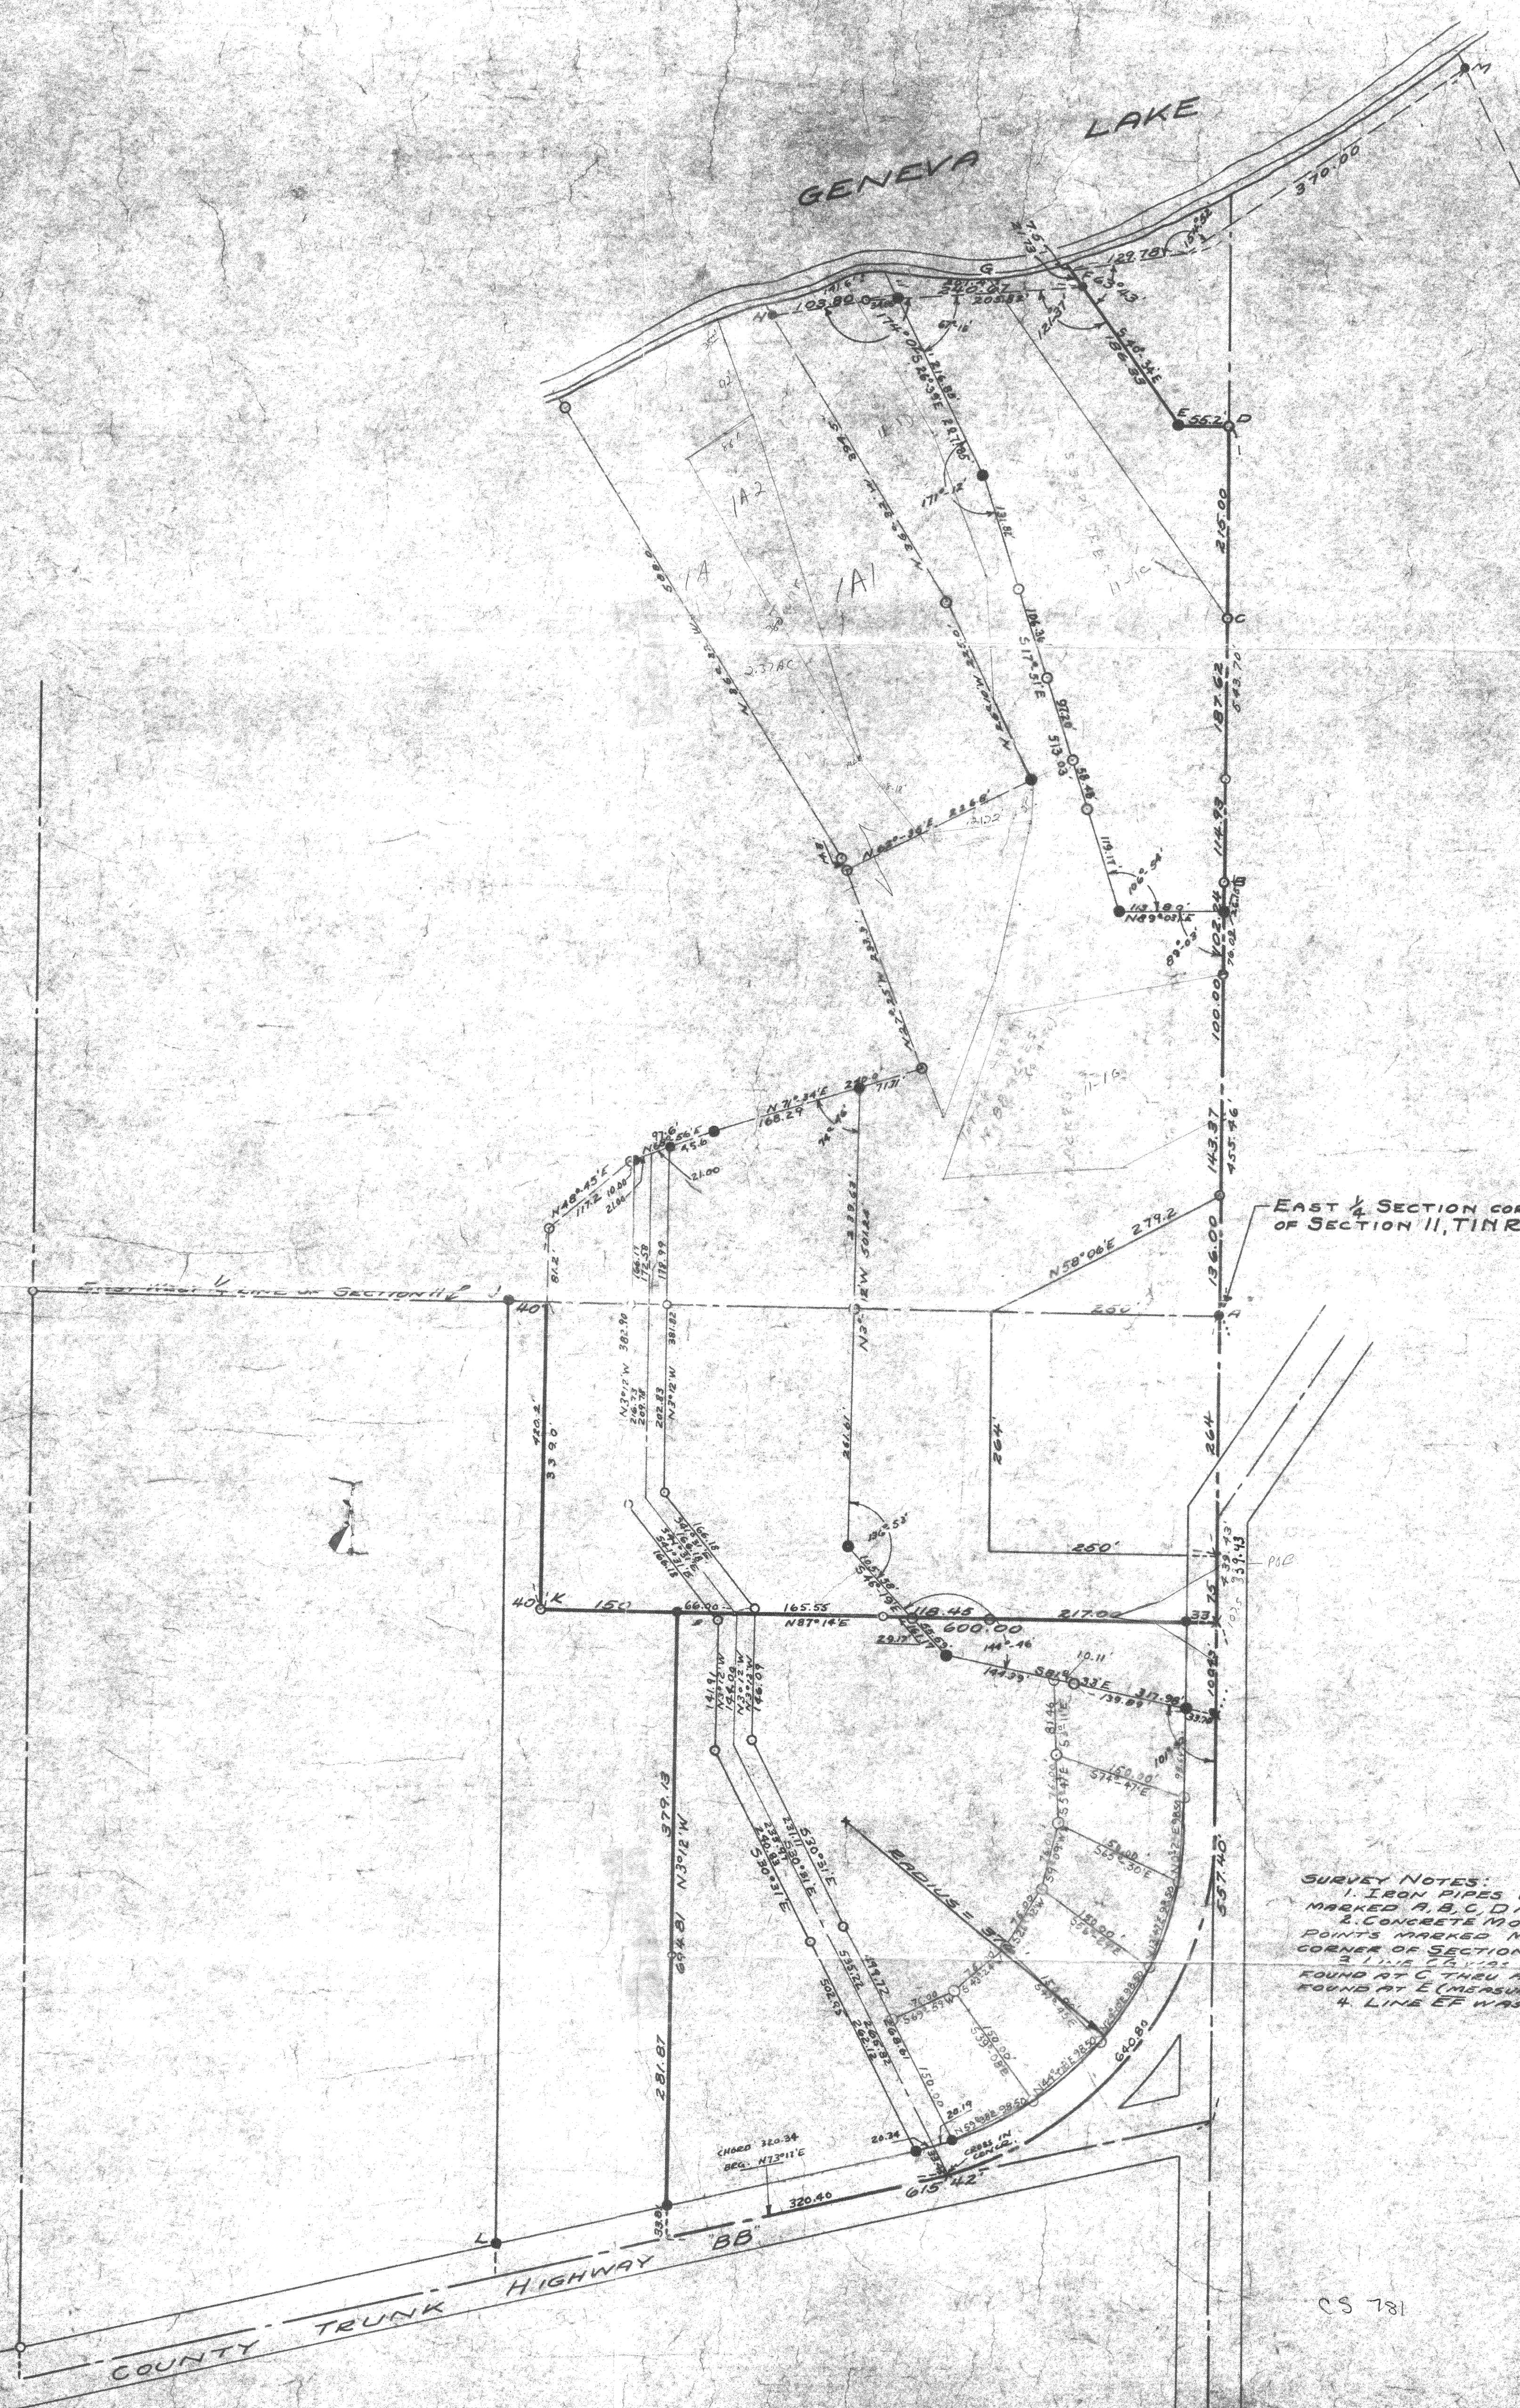

EAST 1/4 SECTION CORNER OF SECTION 11, T1N R17E

SCALE - 1" = 100'  
 ○ = IRON PIPE  
 ● = CONC. MONU.

**SURVEY NOTES:**  
 1. IRON PIPES WERE FOUND AT POINTS MARKED A, B, C, D AND K.  
 2. CONCRETE MONUMENTS WERE FOUND AT POINTS MARKED M, H, J & L AND AT THE SE CORNER OF SECTION 11.  
 3. LINE CB WAS MADE A BAIL FROM THE I. PIPE FOUND AT C THEN A POINT 80' FROM THE I. PIPE FOUND AT E (MEASURED AT 90° TO CB).  
 4. LINE EF WAS MADE PARALLEL TO LINE CB.

PLAT OF SURVEY OF LAND LOCATED IN THE SOUTHEAST QUARTER AND THE NORTHEAST FRACTIONAL 1/4 OF SECTION 11, TOWN 1 NORTH, RANGE 17 EAST OF WALKORTH COUNTY, WISCONSIN.  
 DECEMBER, 1946  
W.E. Johnson  
 SURVEYOR

CS 781  
 L-11-1 L-11-1C  
 L-11-2 L-11-1A  
 -11-1E  
 11-1E1  
 11-1B  
 11-1B1  
 11-1G  
 11-1F