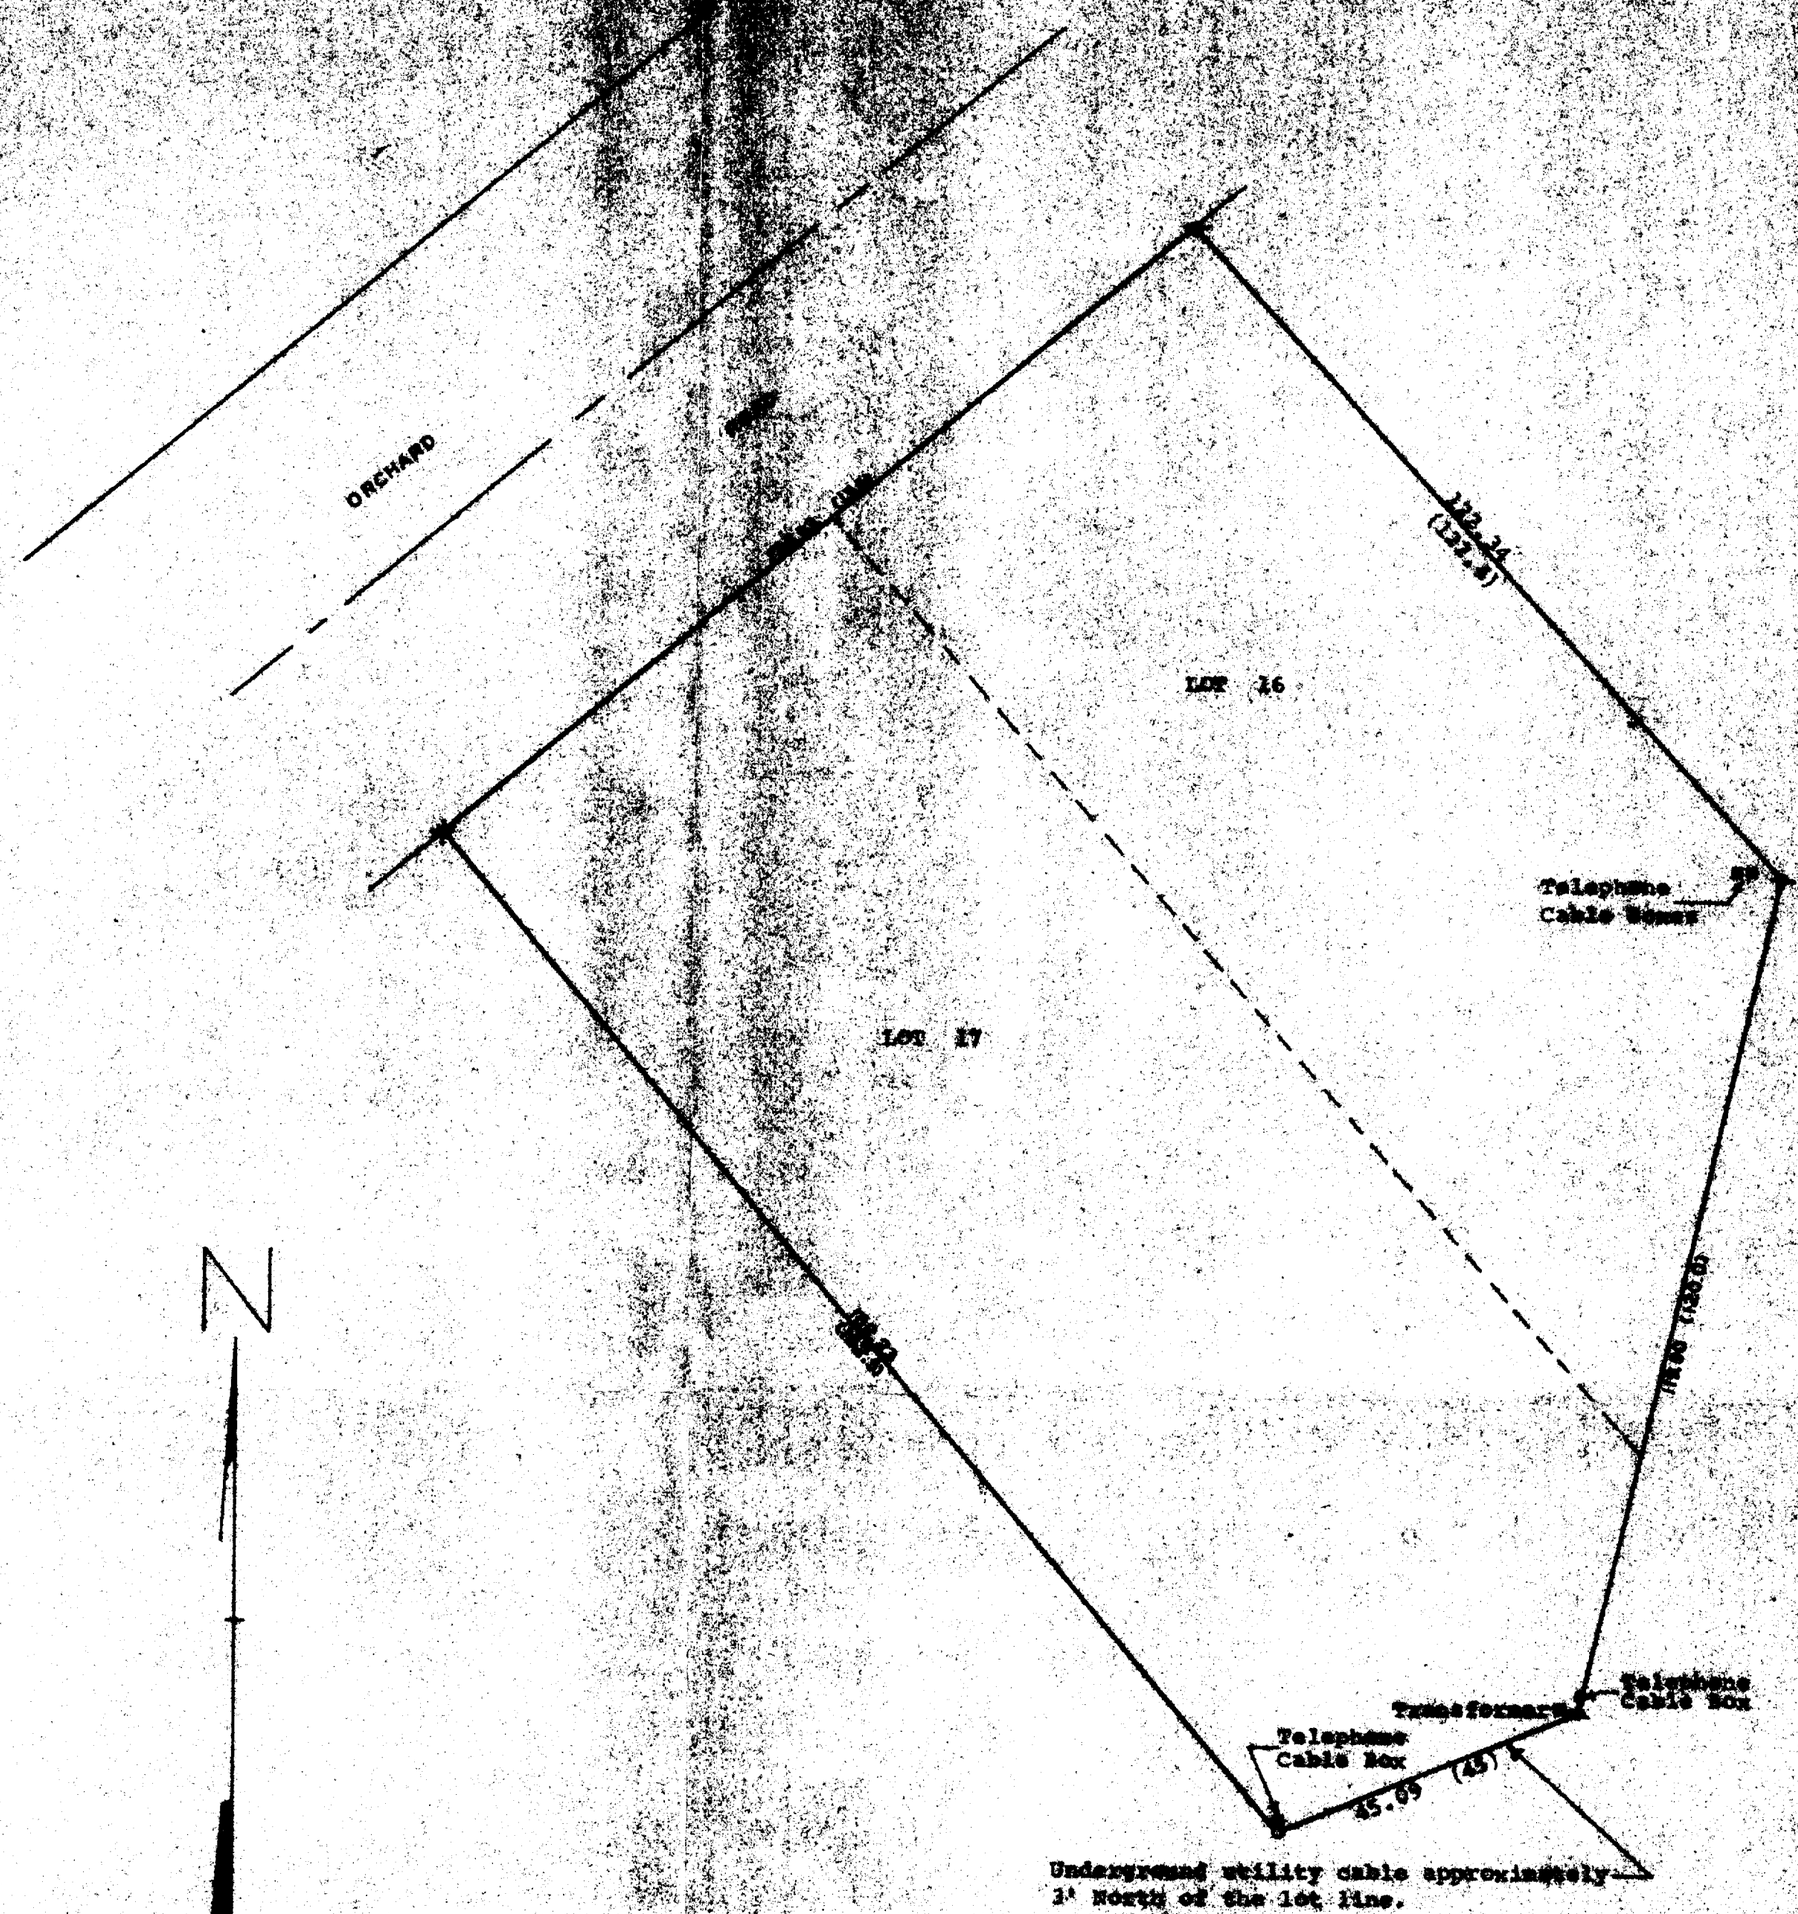

Scale - 1" = 20'
⊠ = Iron Pipe Found
o = Iron Pipe Set
⊠ = Iron Pin Found &
Iron Pipe Set
(0.00) = Distances according to
the recorded plat.

STATE OF WISCONSIN)
COUNTY OF WALWORTH) ss

I, George T. Dunham, Surveyor, certify that I have surveyed the property described as follows:

Lots 16 & 17, Block 15 of Meaddale Addition
located in Sections 9 and 16, T 1 N, R 17 E,
Walworth County, Wisconsin,

and the above map is a true representation thereof and shows the size and location of the property, its exterior boundaries, the location and dimensions of all structures thereon, fences, apparent easements and roadways and visible encroachments, if any.

February 21, 1978

George T. Dunham, Surveyor

WISCONSIN
GEORGE T.
DUNHAM
DELAVAN,
WIS.
LAND SURVEYOR