PREPARED FOR:
NANCY ANDERSON
W522 HIGHLAND RD.
GENOA CITY, WI
53128

PLAT OF SURVEY

-OF-

LOT 3 CERTIFIED SURVEY MAP NO. 4007, LOCATED IN THE SOUTHEAST 1/4 OF SECTION 26, TOWN 1 NORTH, RANGE 18 EAST, WALWORTH COUNTY, WISCONSIN.

KROTT SURVEYING INC.
N3705 WILLOW BEND LANE
LAKE GENEVA WI. 53147
PHONE # (262)248-3697
FAX # (262)249-0639

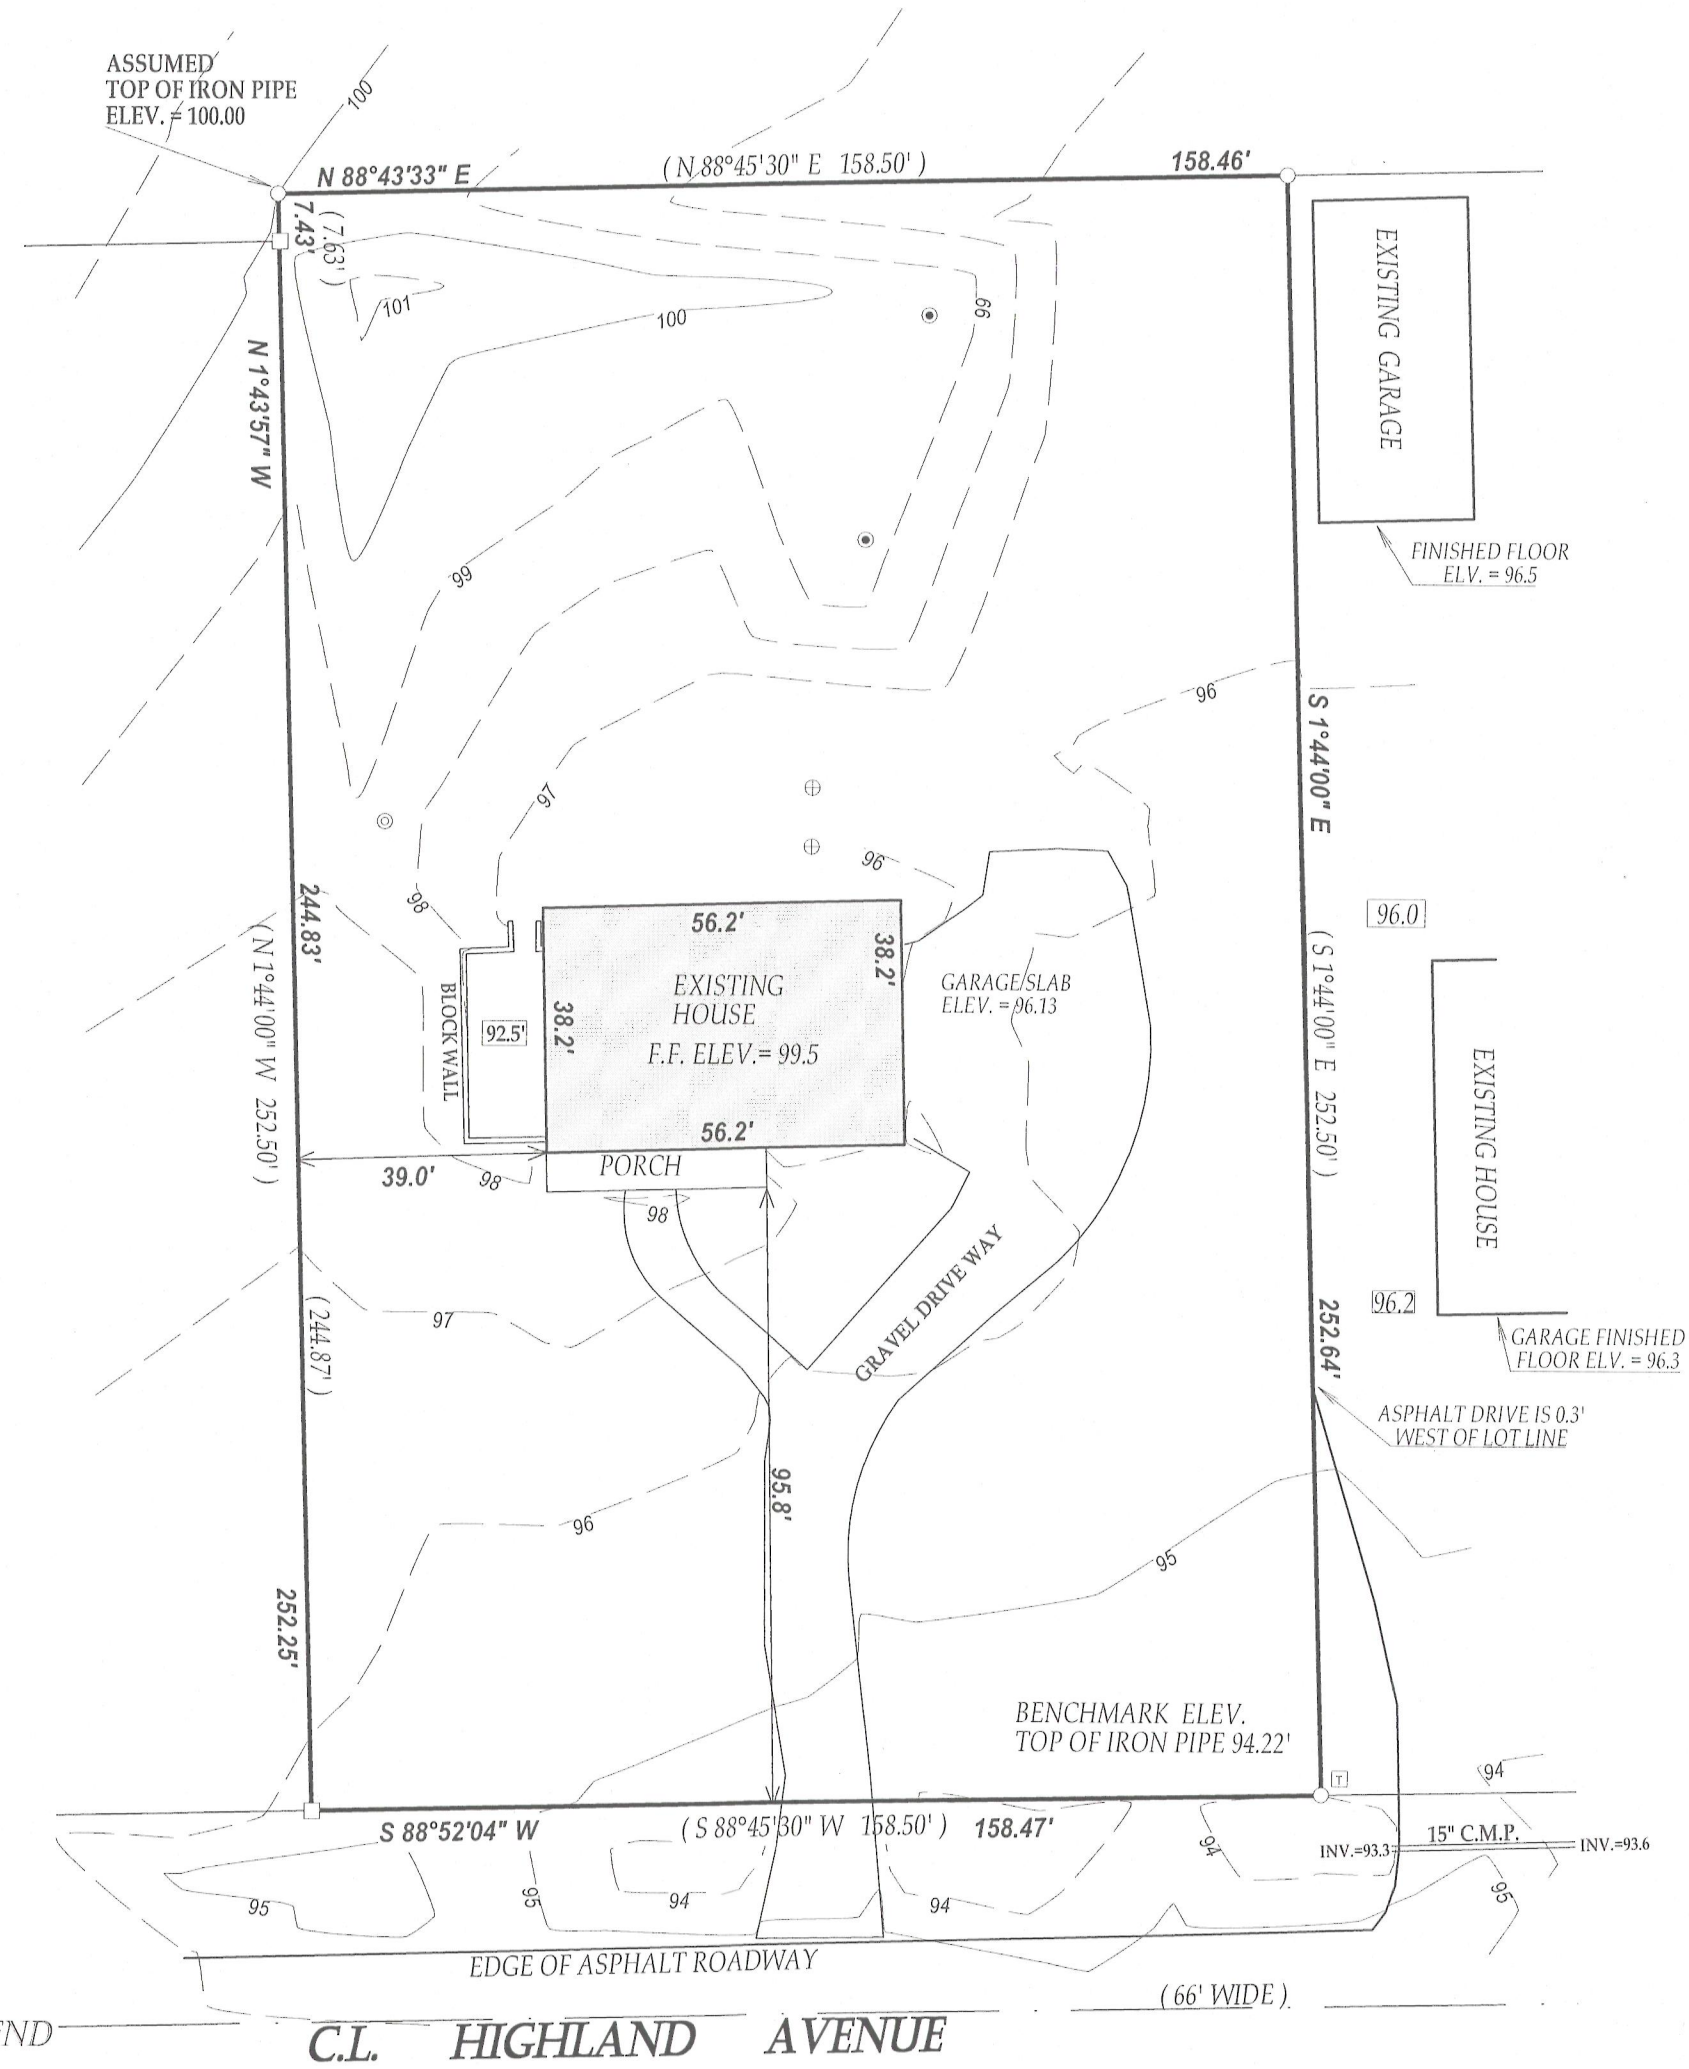

LEGEND

- ⊕ CONCRETE ACCESS COVER
- ◎ WELL
- ⊙ 4 " DIA. PVC PIPE
- ○ FOUND IRON PIPE
- □ FOUND IRON BAR
- T TRANSFORMER
- (XX) RECORDED AS

TAX ID # MA400700003

JOB # 11-153

N
W E
S

SCALE 1" = 30'

0 30 60 90

NOTE : BEARINGS ARE REFRENCED TO C.S.M. # 4007

I have surveyed the above-described property and the above map is a true representation thereof and shows the size and location of the property, its exterior boundaries, the location and dimensions of all structures thereon, fences apparent easements and roadways and visible encroachments. if any.

This survey is made for the exclusive use of the present owners of the property, and also those who puchase, mortgage,or insure the title therto within one (1) year from date hereof; and as to them I warrant the accuracy of said survey map.

RECEIVED
JAN 2 4 2013

WISCONSIN
JOHN P.
KROTT
S-2258
LAKE GENEVA
WIS.
LAND SURVEYOR

DATE OF LAST REVISION: 12/31/2012

DATED THIS 19th DAY OF OCTOBER 2011.

JOHN KROTT S - 2258
Wisconsin Registered Land Surveyor
(original if signed in red)

118-3130