


PLAT OF SURVEY

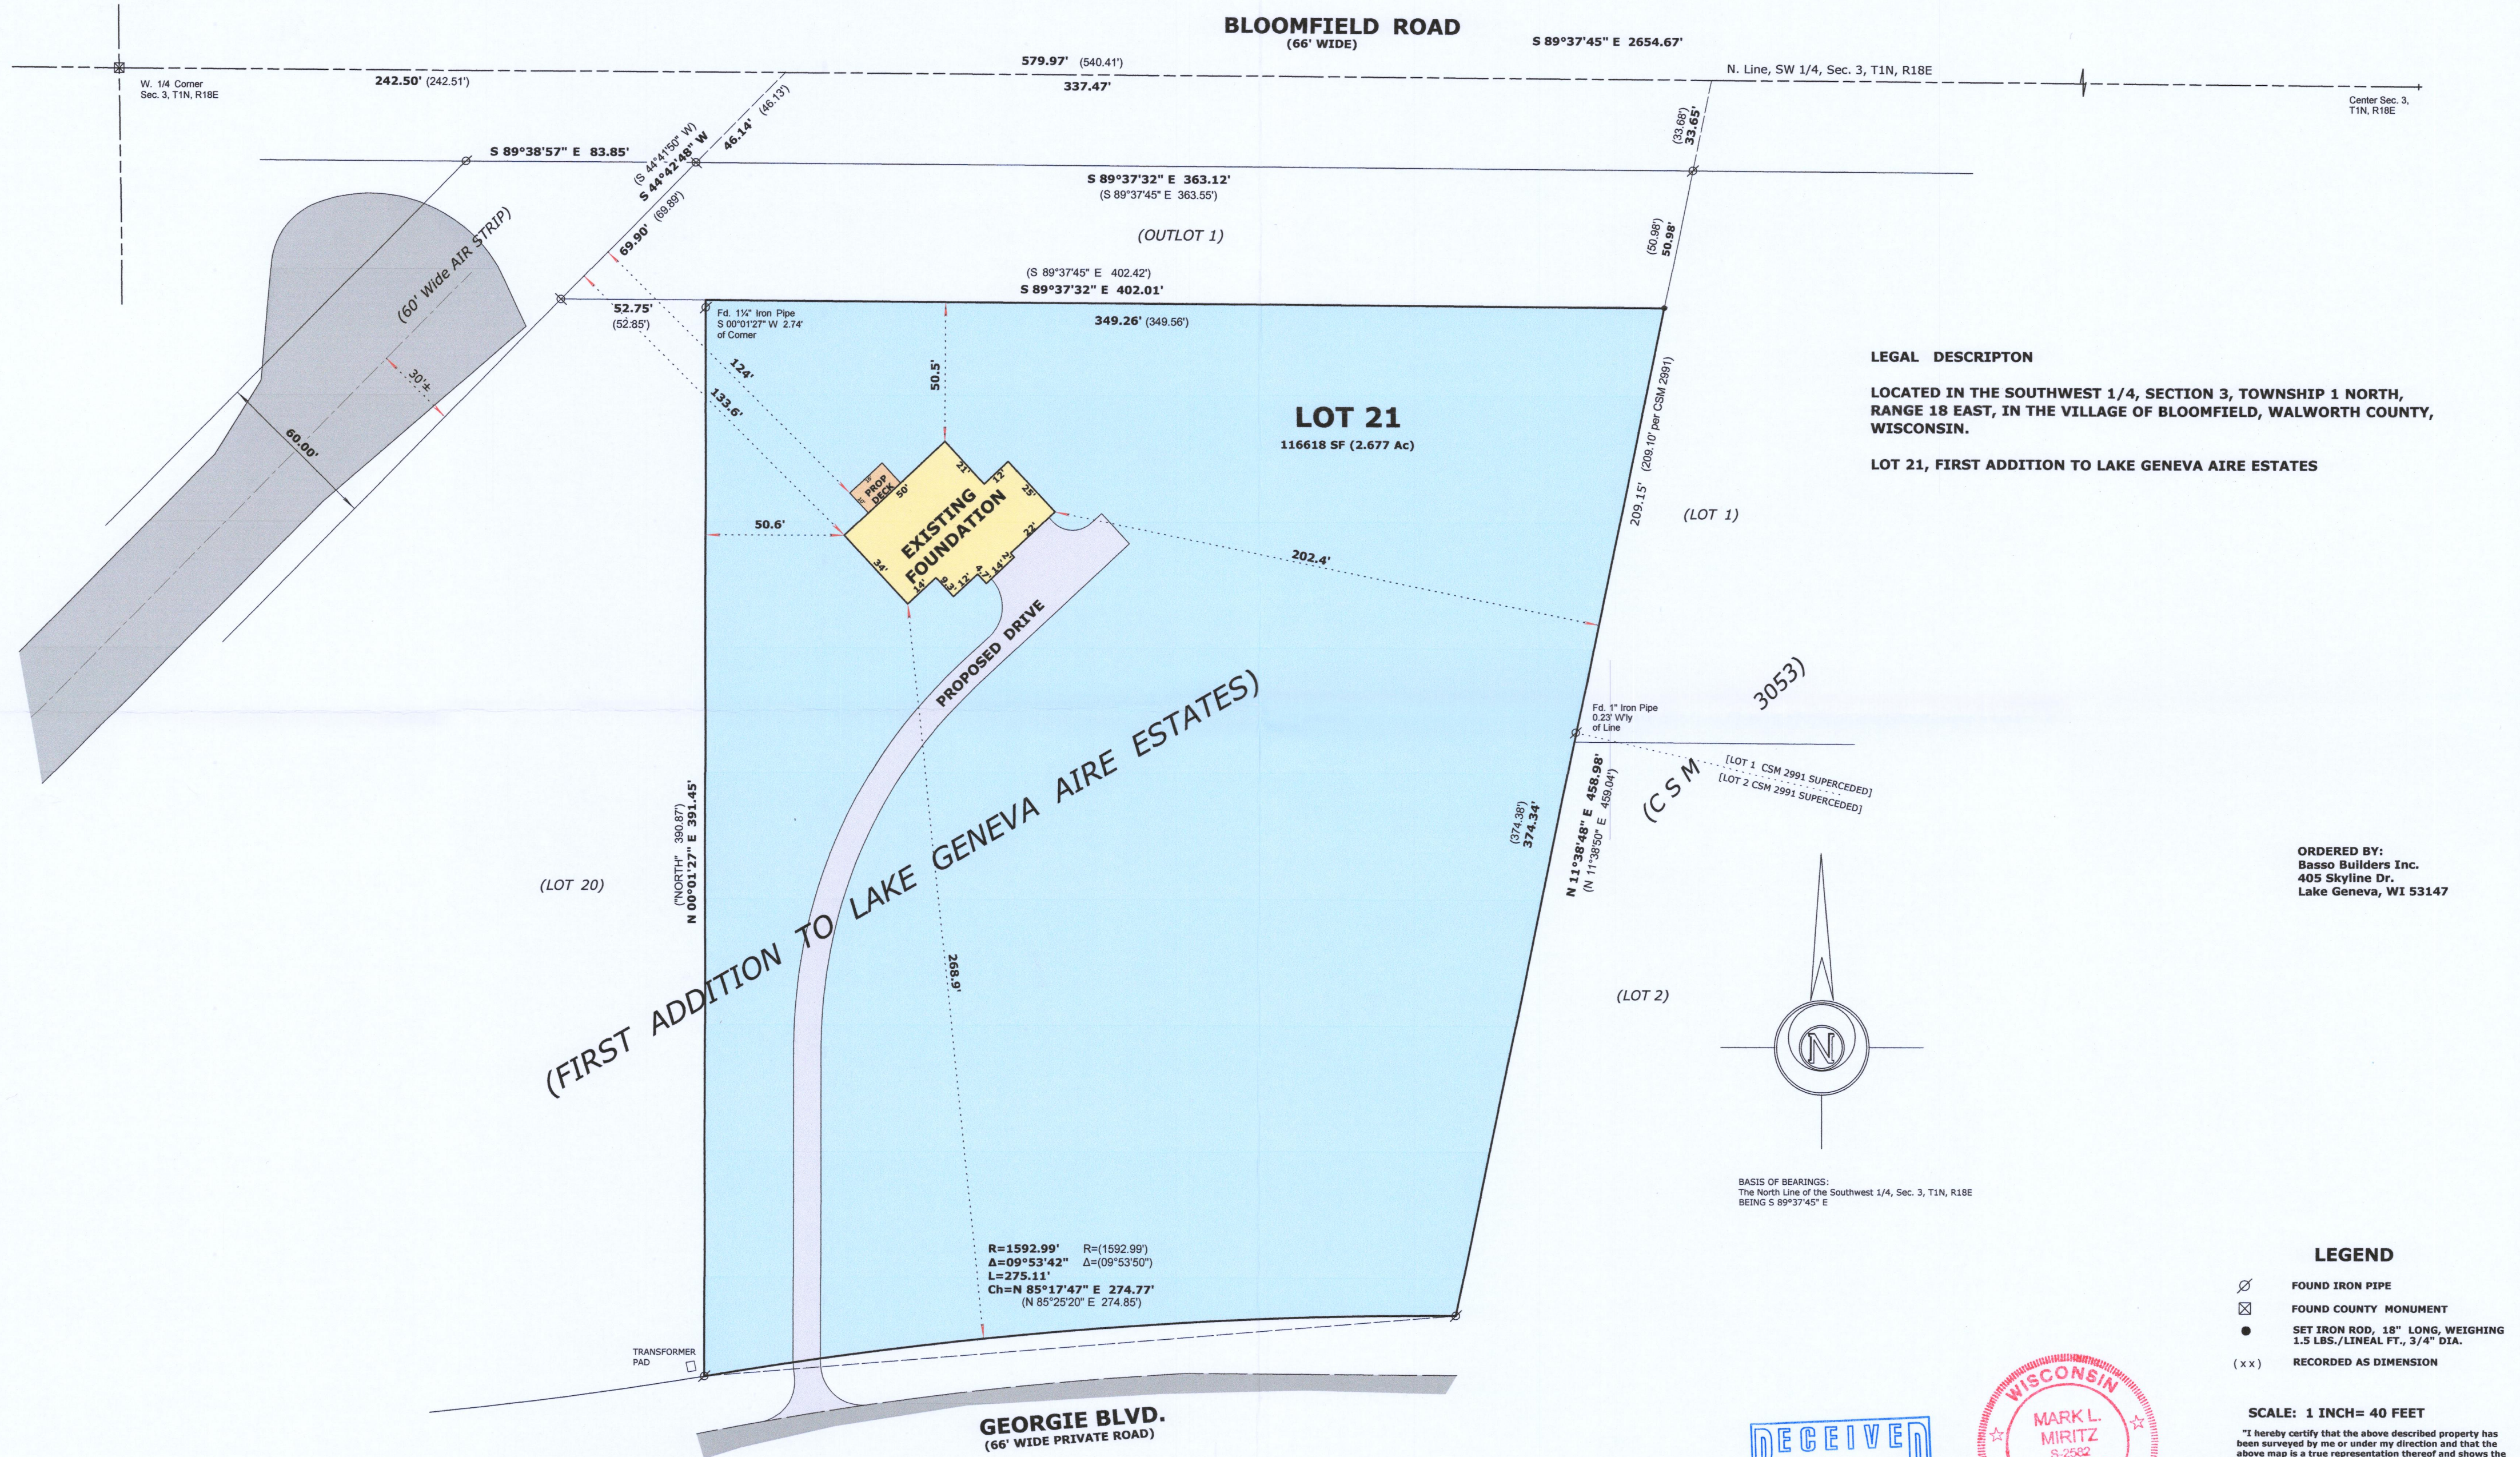

8LA1-14 118-3459