

of

Coordinates are referenced to the Wisconsin State Plane Coordinate System, South Zone, (NAD-27)

Tax Parcel
&W 00001

Point computed using distances
as shown on survey by Peter S.
Gordon dated April 7, 2017 falls
in roots of pine tree near metal
T post. Could not find pipe.

Tax Parcel
&W 00011


5.477 Acres
238,586 Sq.Ft.
5.075 Acres
221,076 Sq.Ft.
Exclusive of R.O.W.

Tax Parcel
MB 500007

Tax Parcel
&W 00010

Tax Parcel
&W 00003

Huntington Drive

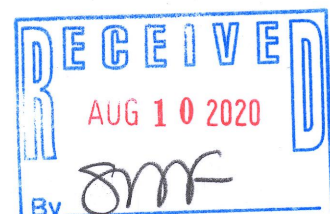

All rights reserved. No part of this survey plat may be reproduced or transmitted in any form by any means - graphic, electronic, or mechanical, including photocopying, tracing, or information storage and retrieval systems - without permission in writing from Douglas G. Olson, Olson Land Surveying, LLC.

Douglas G. Olson
Wisconsin Professional Land Surveyor - 2093

- 1) This Plat of Survey is not certified unless signed and sealed in red ink.
- 2) This survey is subject to Wisconsin lien laws. This Plat of Survey is the notice of intent to file lien. Lien waiver required.
- 3) The Survey Date shown on this Plat of Survey is the completion date of the field work.

2020.057

Drawing Name:

Job Reference Number
2020.057

■ Found County Section Corner
 ⌀ Found Iron Pipe
 ● Found Iron Rod
 ○ Set Iron Pipe, 1" dia.
 () Recorded Information
 ✕ Utility Pole
 ☒ Utility Pedestal
 ○ Concrete Cover
 ◇ Septic Vent
 ■ Asphalt Surface
 ■ Concrete Surface
 ■ Gravel Surface
 ■ Brick Pavers

N North
S South
E East
W West
In Bearings
° Degrees
' Minutes
" Seconds
In Distances
' Feet
" Inches
No. Number
NW. Northwest
NE. Northeast
Dia. Diameter



OLSON
LAND SURVEYING, LLC

Rural | Residential | Commercial

45 South Wisconsin Street | P.O. Box 322
Elkhorn, Wisconsin. 53121
Telephone: (262) 723-3434
Facsimile: (262) 723-8044
Email: doug@olsonsurveying.com
Website: www.olsonsurveying.com


Survey date: June 8, 2020.
Revisions: