


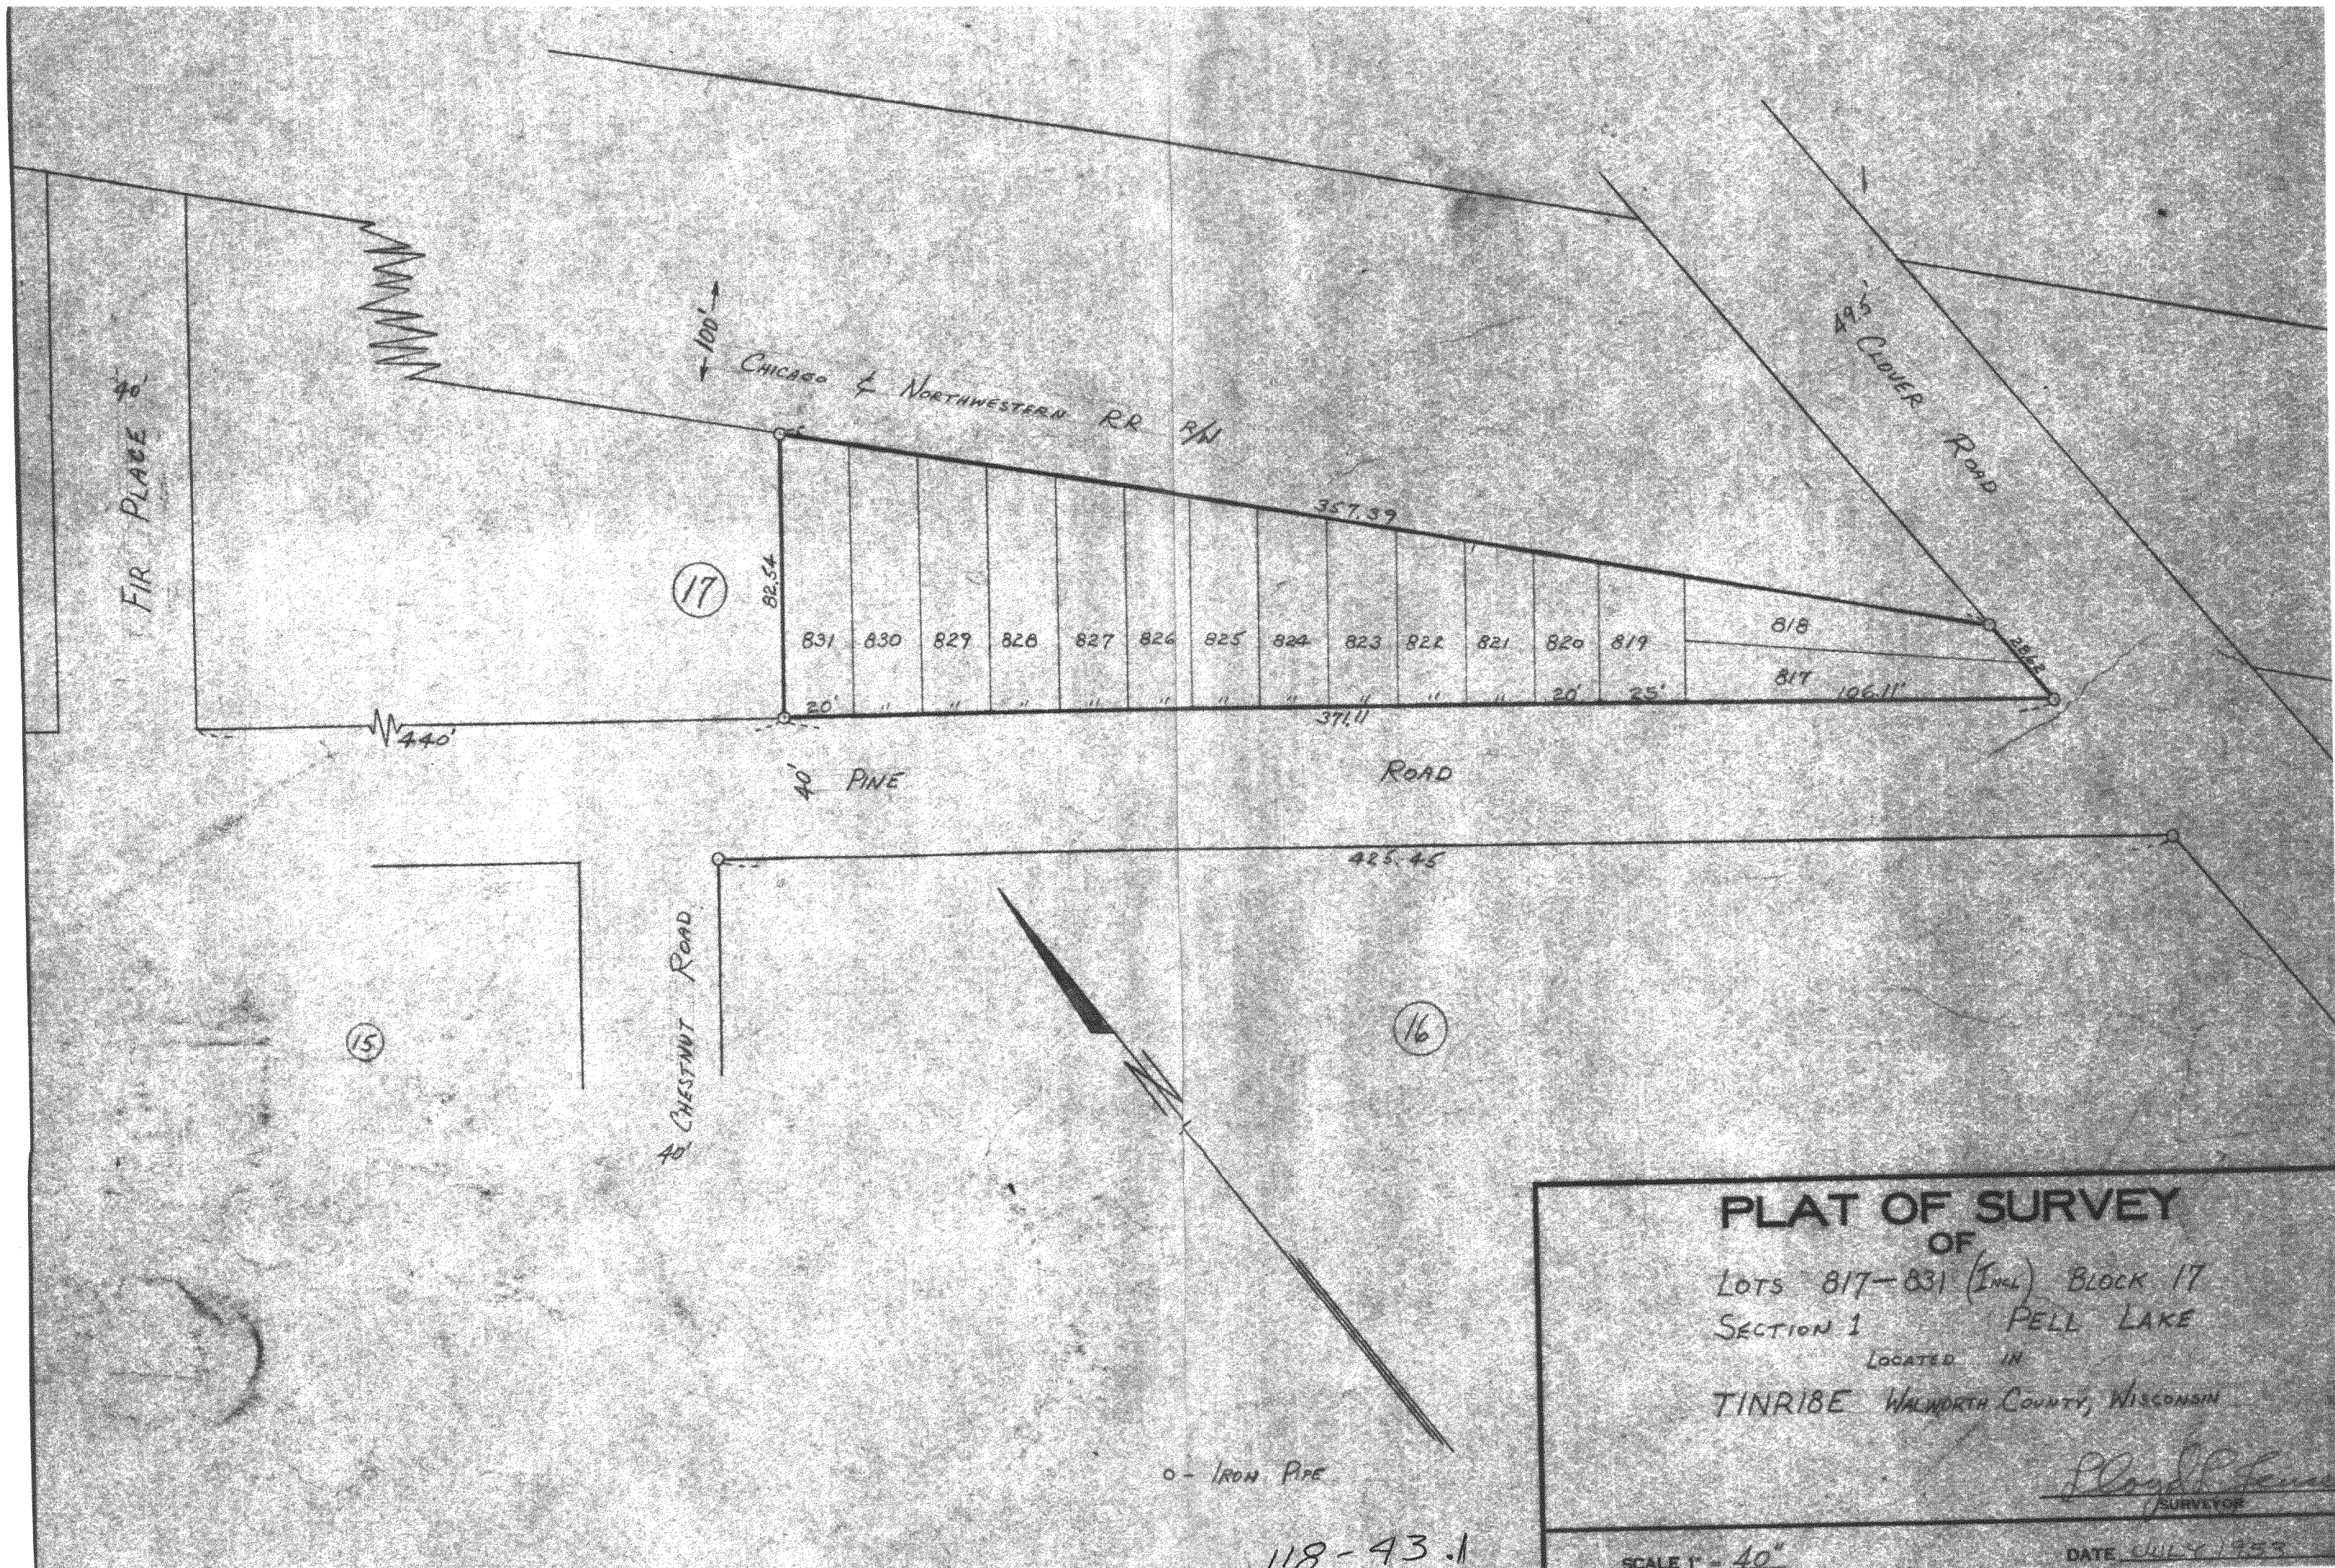

40' FIR PLACE

100' CHICAGO & NORTHWESTERN RR 9/4

40' CLOVER ROAD

(17)

82.54

831 830 829 828 827 826 825 824 823 822 821 820 819

818

817

440'

20'

371.11

40' PINE ROAD

425.45

(15)

40' CHESTNUT ROAD

(16)

0 - IRON PIPE

118-43.1

PLAT OF SURVEY OF

LOTS 817-831 (Incl) BLOCK 17
SECTION 1 PELL LAKE

LOCATED IN
TINRIBE WALWORTH COUNTY, WISCONSIN

Floyd P. Lewis
SURVEYOR

SCALE 1" = 40'

DATE JULY 1953