


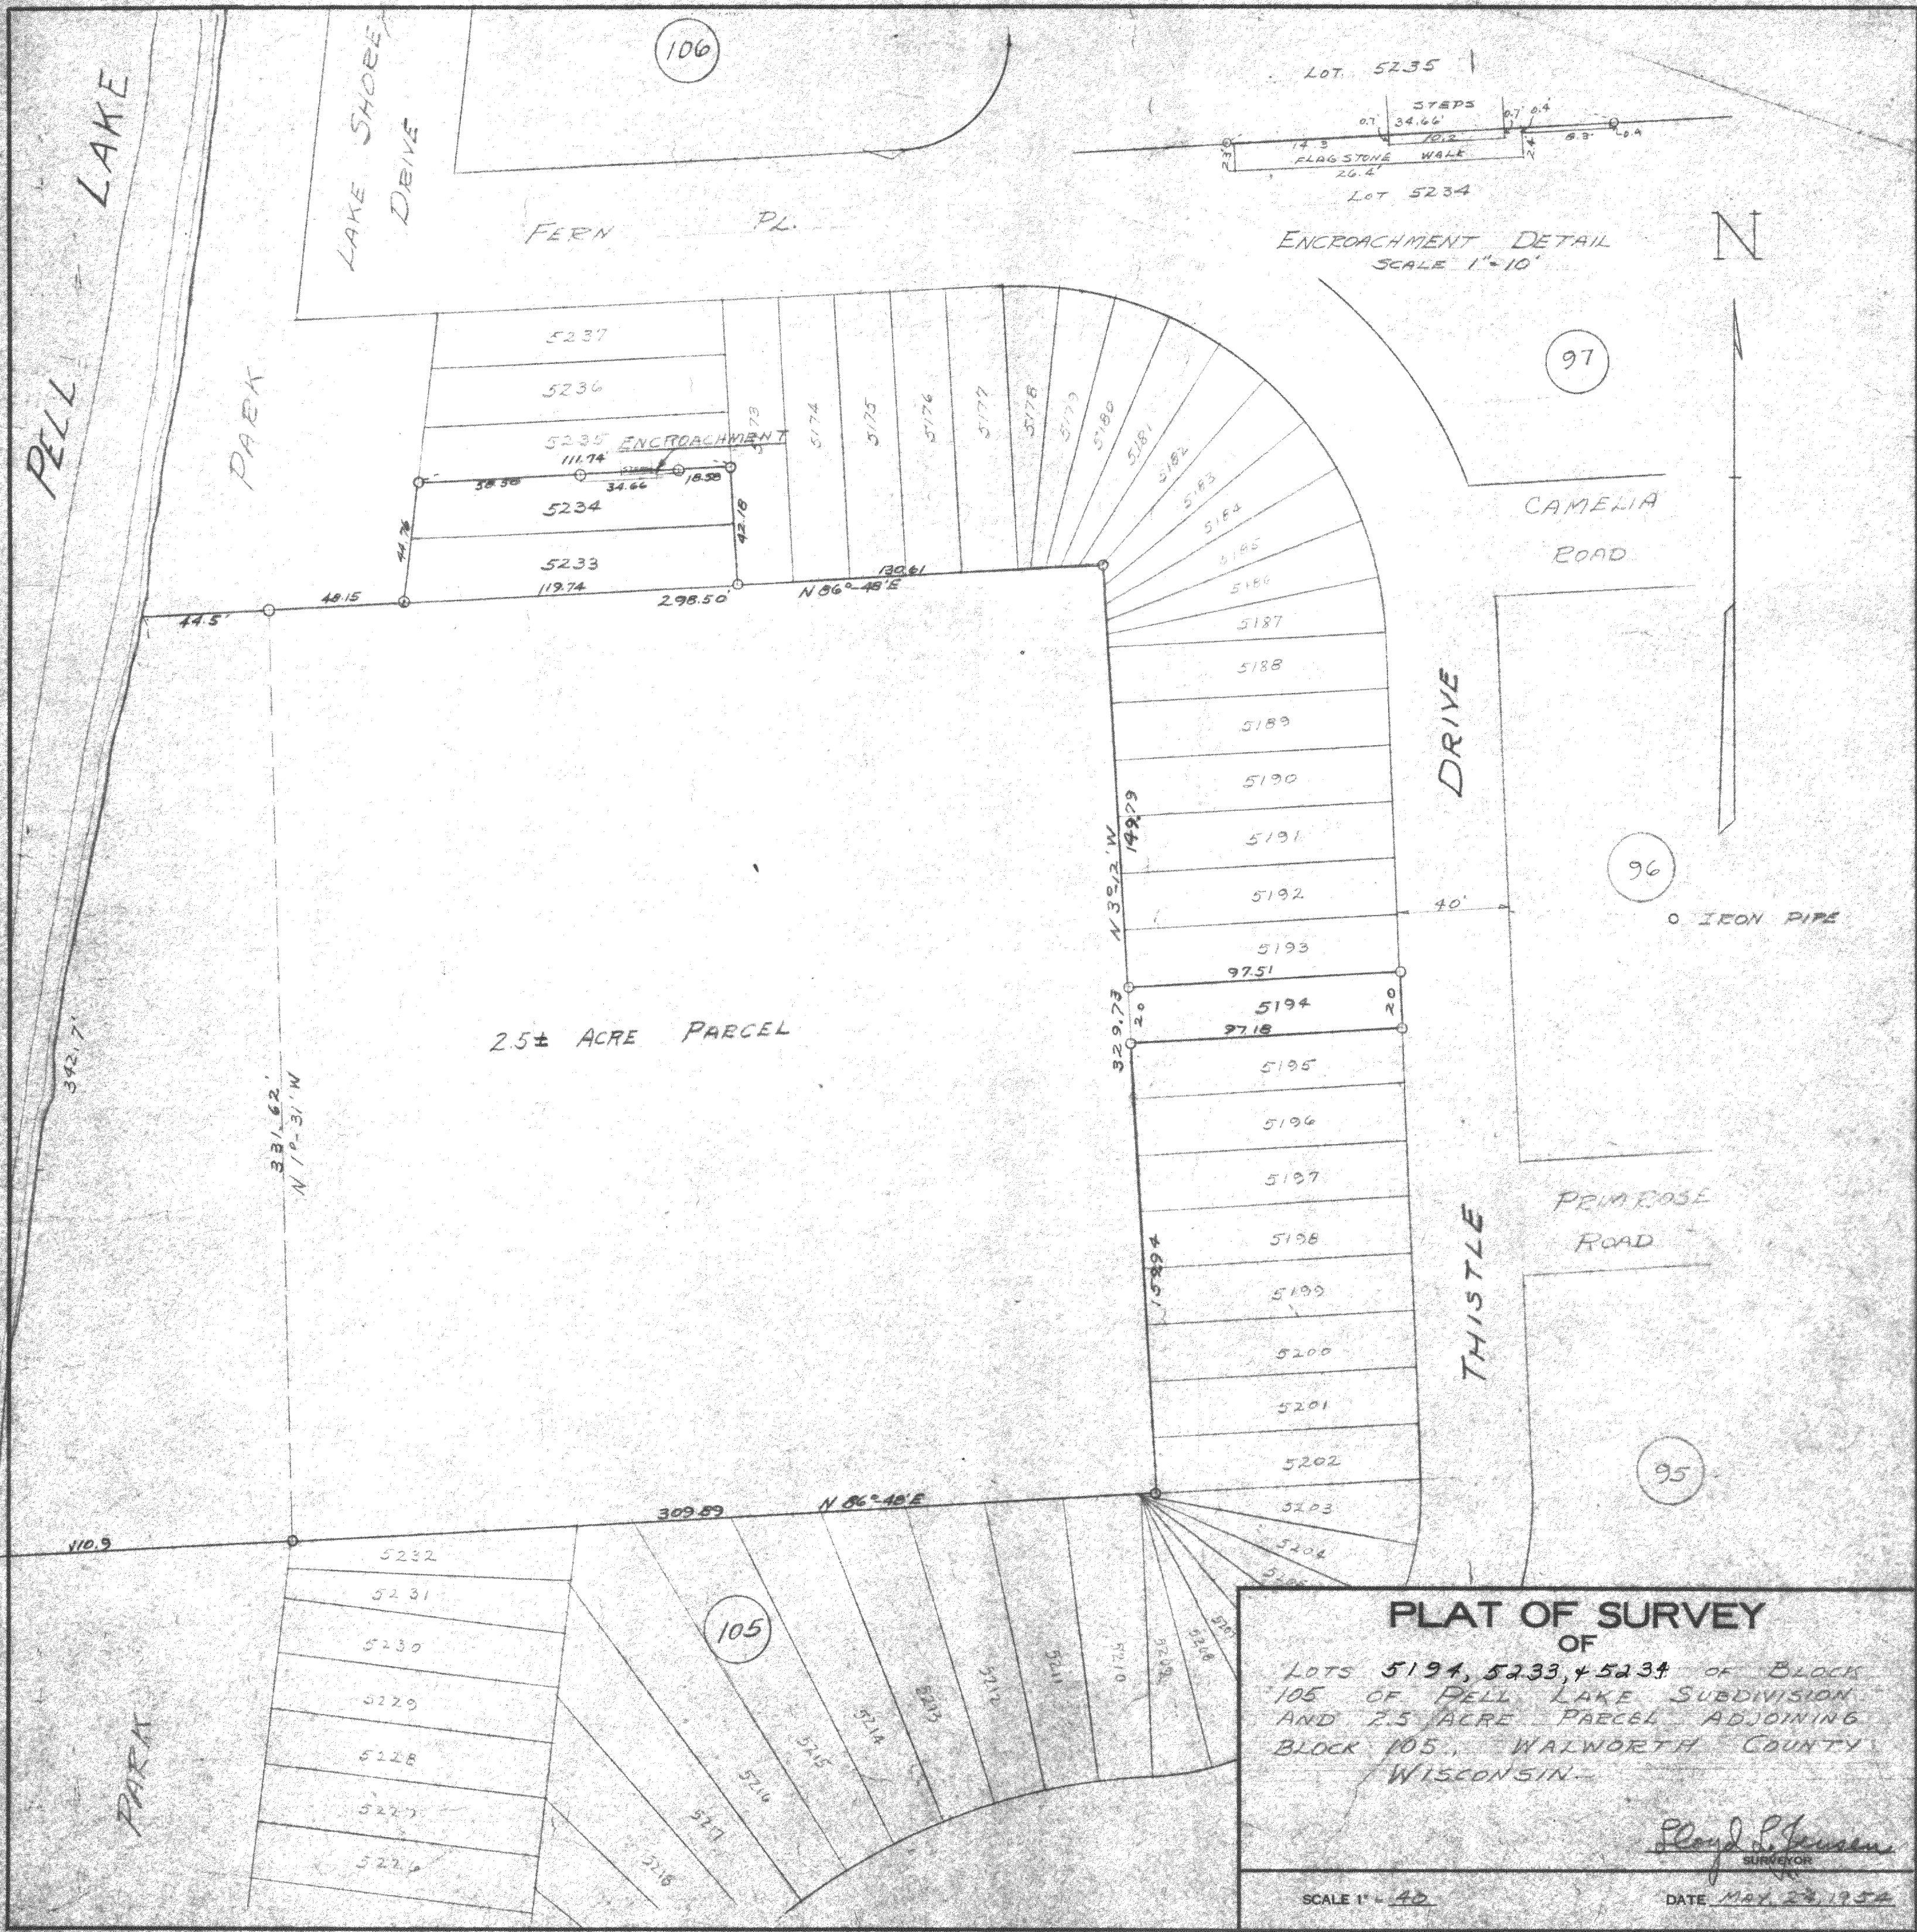

**PLAT OF SURVEY
OF**

LOTS 5194, 5233, & 5234 OF BLOCK
105 OF PELL LAKE SUBDIVISION
AND 2.5 ACRE PARCEL ADJOINING
BLOCK 105, WALNORTH COUNTY
WISCONSIN

Lloyd L. Jensen
SURVEYOR

SCALE 1" = 40'

DATE MAY 23, 1954

118-59.1