KOLB LAND CONSULTING, INC.

LAND SURVEYING · SUBDIVIDING · LAND PLANNING

929 WILLIAMS STREET LAKE GENEVA, WISCONSIN 53147 414-248-3697

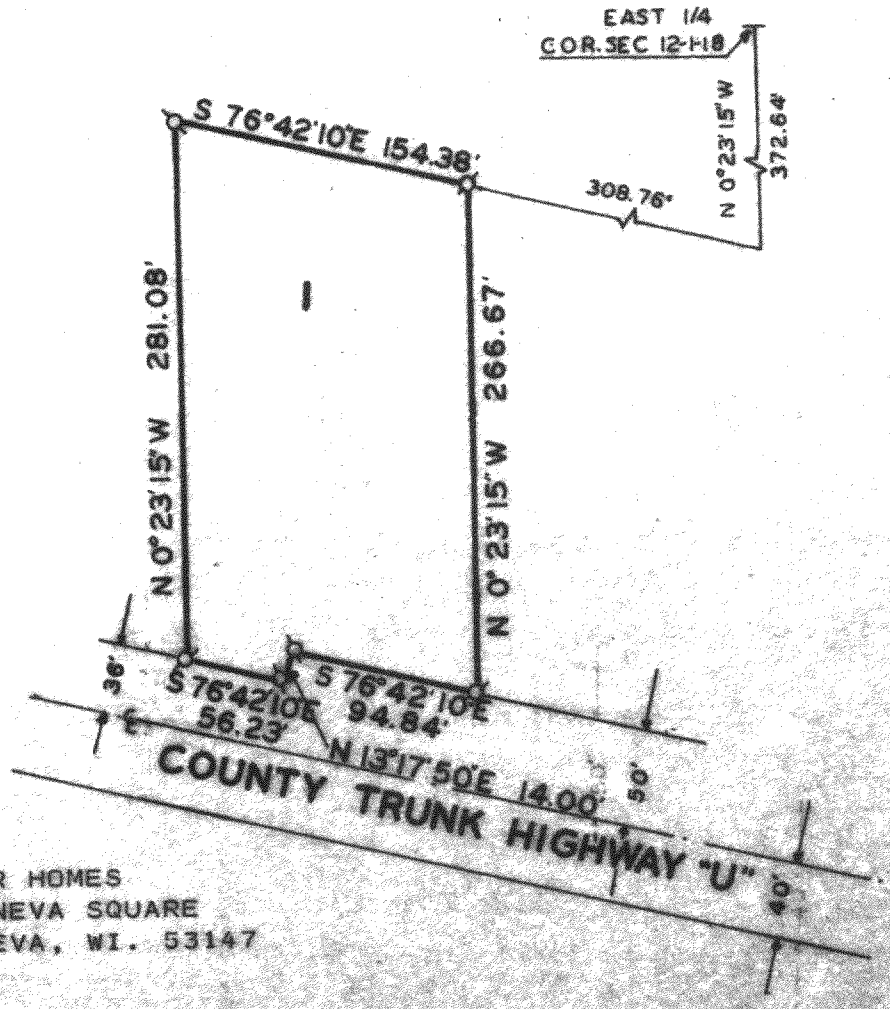

SCALE: 1" = 100'

LEGEND

ø- IRON PIPE FOUND

ORDERED BY: FIVE STAR HOMES
90 E. GENEVA SQUARE
LAKE GENEVA, WI. 53147

NOTE: THE EAST LINE OF SECTION 12-1-18 IS ASSUMED N 0°23'15" W AS SHOWN ON EXISTING SURVEY RECORDS.

PLAT OF SURVEY OF

LOT 1 OF CERTIFED SURVEY MAP #474, AND LOCATED IN THE NE 1/4 OF THE SE 1/4 OF SECTION 12, T1N, R18E, TOWN OF BLOOMFIELD, WALWORTH COUNTY, WISCONSIN.

RECEIVED
SEP 16 1987

WISCONSIN
HAROLD H. KOLB
S-187
LAKE GENEVA, WIS.
LAND SURVEYOR

I, HAROLD H. KOLB, DO HEREBY CERTIFY THAT I HAVE SURVEYED THE PROPERTY HEREON DESCRIBED ACCORDING TO THE OFFICIAL RECORDS, AND THAT THE PLAT HEREON IS A CORRECT REPRESENTATION OF THE LOT LINES TO THE BEST OF MY KNOWLEDGE AND BELIEF.

Harold H. Kolb

HAROLD H. KOLB

WISCONSIN REGISTERED LAND SURVEYOR, S-187

DATE AUGUST 19, 1985

REVISED

REVISED

MA474-1

KOLB LAND CONSULTING, INC.

LAND SURVEYING · SUBDIVIDING · LAND PLANNING

929 WILLIAMS STREET LAKE GENEVA, WISCONSIN 53147 414-248-3697

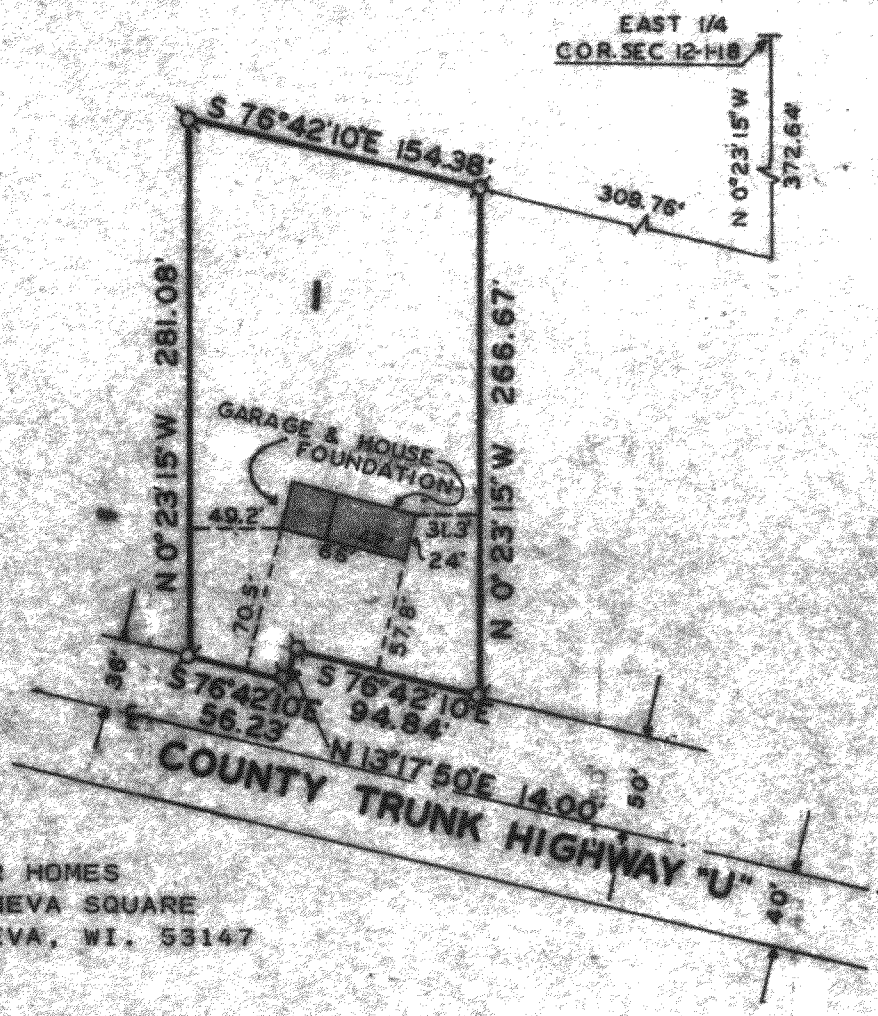

SCALE: 1" = 100'

LEGEND

ø- IRON PIPE FOUND

ORDERED BY: FIVE STAR HOMES
90 E. GENEVA SQUARE
LAKE GENEVA, WI. 53147

NOTE: THE EAST LINE OF SECTION 12-1-18 IS ASSUMED N 0°23'15" W AS SHOWN ON EXISTING SURVEY RECORDS.

PLAT OF SURVEY OF

LOT 1 OF CERTIFED SURVEY MAP #474, AND LOCATED IN THE NE 1/4 OF THE SE 1/4 OF SECTION 12, T1N, R18E, TOWN OF BLOOMFIELD, WALWORTH COUNTY, WISCONSIN.

9-4-85: LOCATED HOUSE FOUNDATION. H. Kolb

RECEIVED
NOV 13 1985

WISCONSIN
HAROLD H. KOLB
S-187
LAKE GENEVA, WIS.
LAND SURVEYOR

I, HAROLD H. KOLB, DO HEREBY CERTIFY THAT I HAVE SURVEYED THE PROPERTY HEREON DESCRIBED ACCORDING TO THE OFFICIAL RECORDS, AND THAT THE PLAT HEREON IS A CORRECT REPRESENTATION OF THE LOT LINES TO THE BEST OF MY KNOWLEDGE AND BELIEF.

Harold H. Kolb

HAROLD H. KOLB

WISCONSIN REGISTERED LAND SURVEYOR, S-187

DATE AUGUST 19, 1985

REVISED SEPT. 4, 1985

REVISED

MA 474-1

1-18-355 118-703K