


DUNHAM SURVEYING, S.C.
SURVEYING & SUBDIVIDING
DELAVER, WISCONSIN 53115

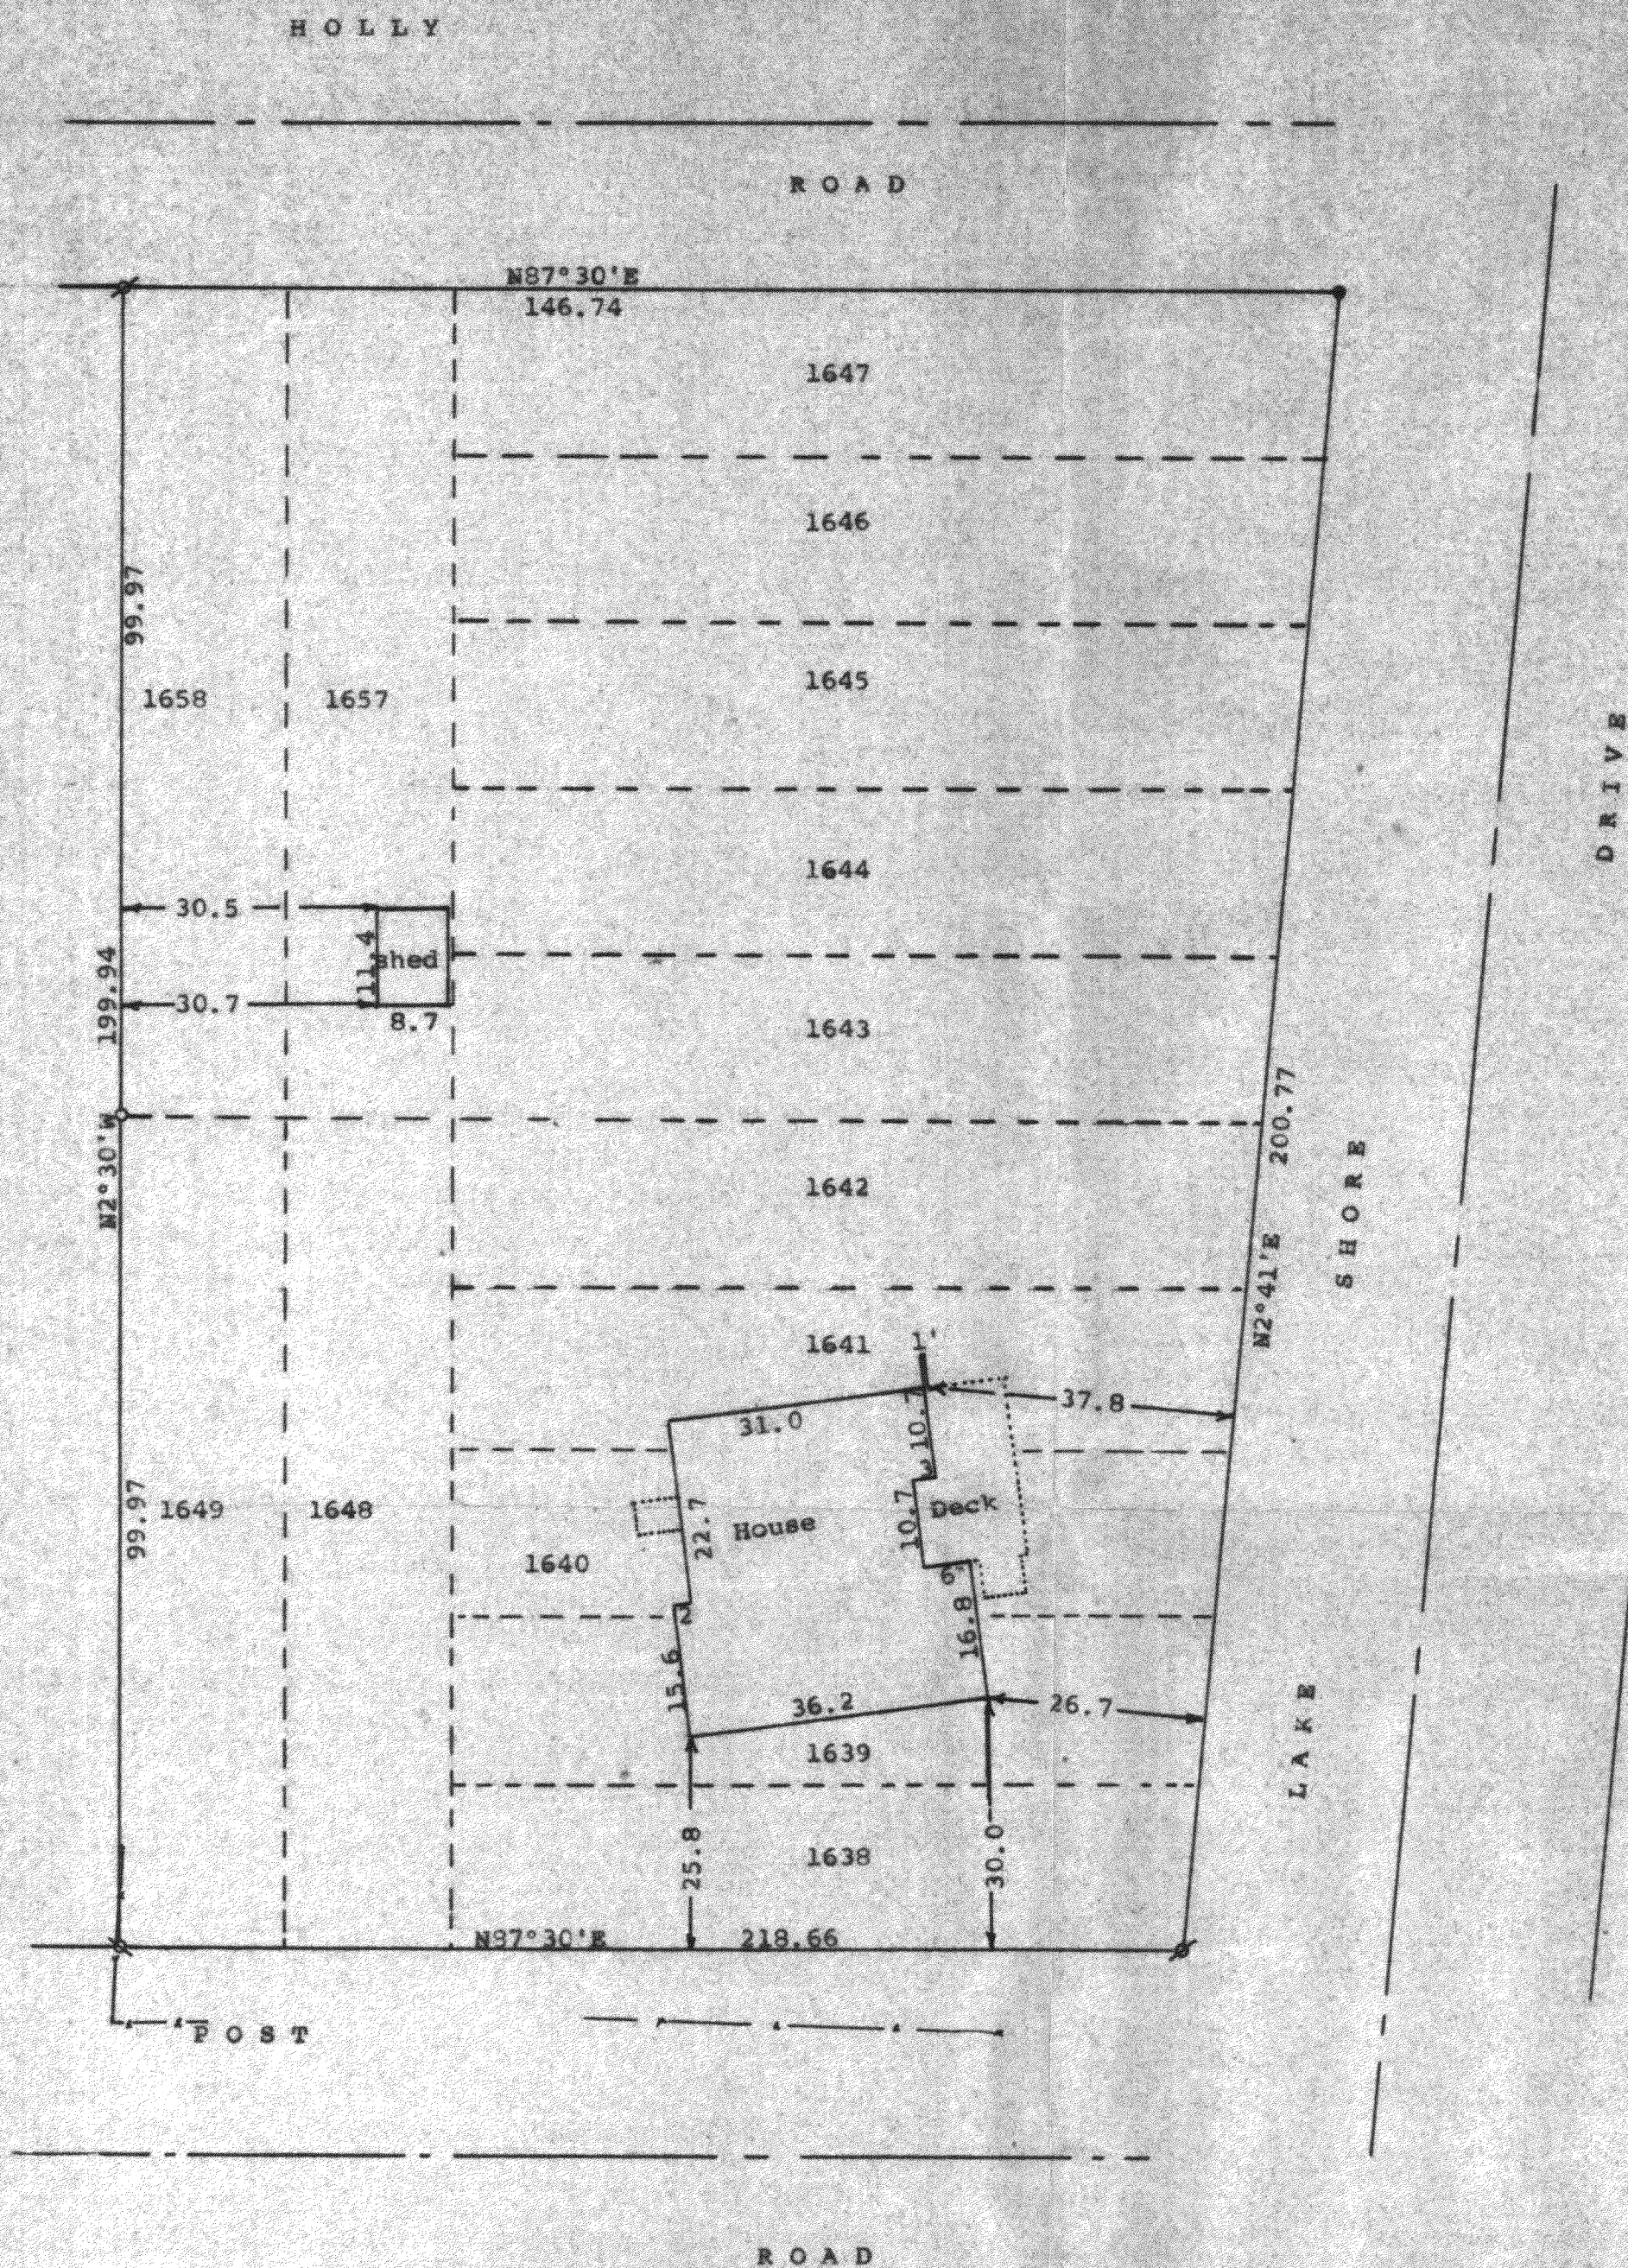


Scale - 1" = 20'
 ● = 1" Iron Pipe Found 1.6' below ground. Set 1 1/2" X 24" above.
 ○ = 1" Iron Pipe Found
 ◐ = 3/4" Iron Pipe Found
 ○ = 1 1/4" Iron Pipe Found
 --- = Fence Line
 Bearings referenced to the recorded bearing of N87°30'E along the northerly line of Post Road.
 Survey ordered by: Barb Lepkowaki
 484 Orchard Street
 Antioch, IL 60002

STATE OF WISCONSIN) SS
 COUNTY OF WALWORTH)

I, George T. Dunham, Surveyor, certify that I have surveyed the property described as follows:

Lots 1638-1647 inclusive and Lots 1648, 1649, 1657, and 1658, all in Block 37, Pell Lake Subdivision, Section 1, located in the Town of Bloomfield, Walworth County, Wisconsin.

and that the map shown hereon is a correct representation thereof and shows the size and location of the property, its exterior boundaries, the location of all visible structures and dimensions of all principal buildings thereon, boundary fences, apparent easements, roadways and visible encroachments, if any, and that I have surveyed the property hereon described according to the official records, to the best of my knowledge and belief.
 March 10, 1988

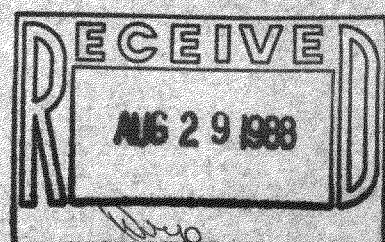

George T. Dunham
 George T. Dunham, Surveyor

