


DUNHAM SURVEYING, S.C.
SURVEYING & SUBDIVIDING
DELAVER, WISCONSIN 53115

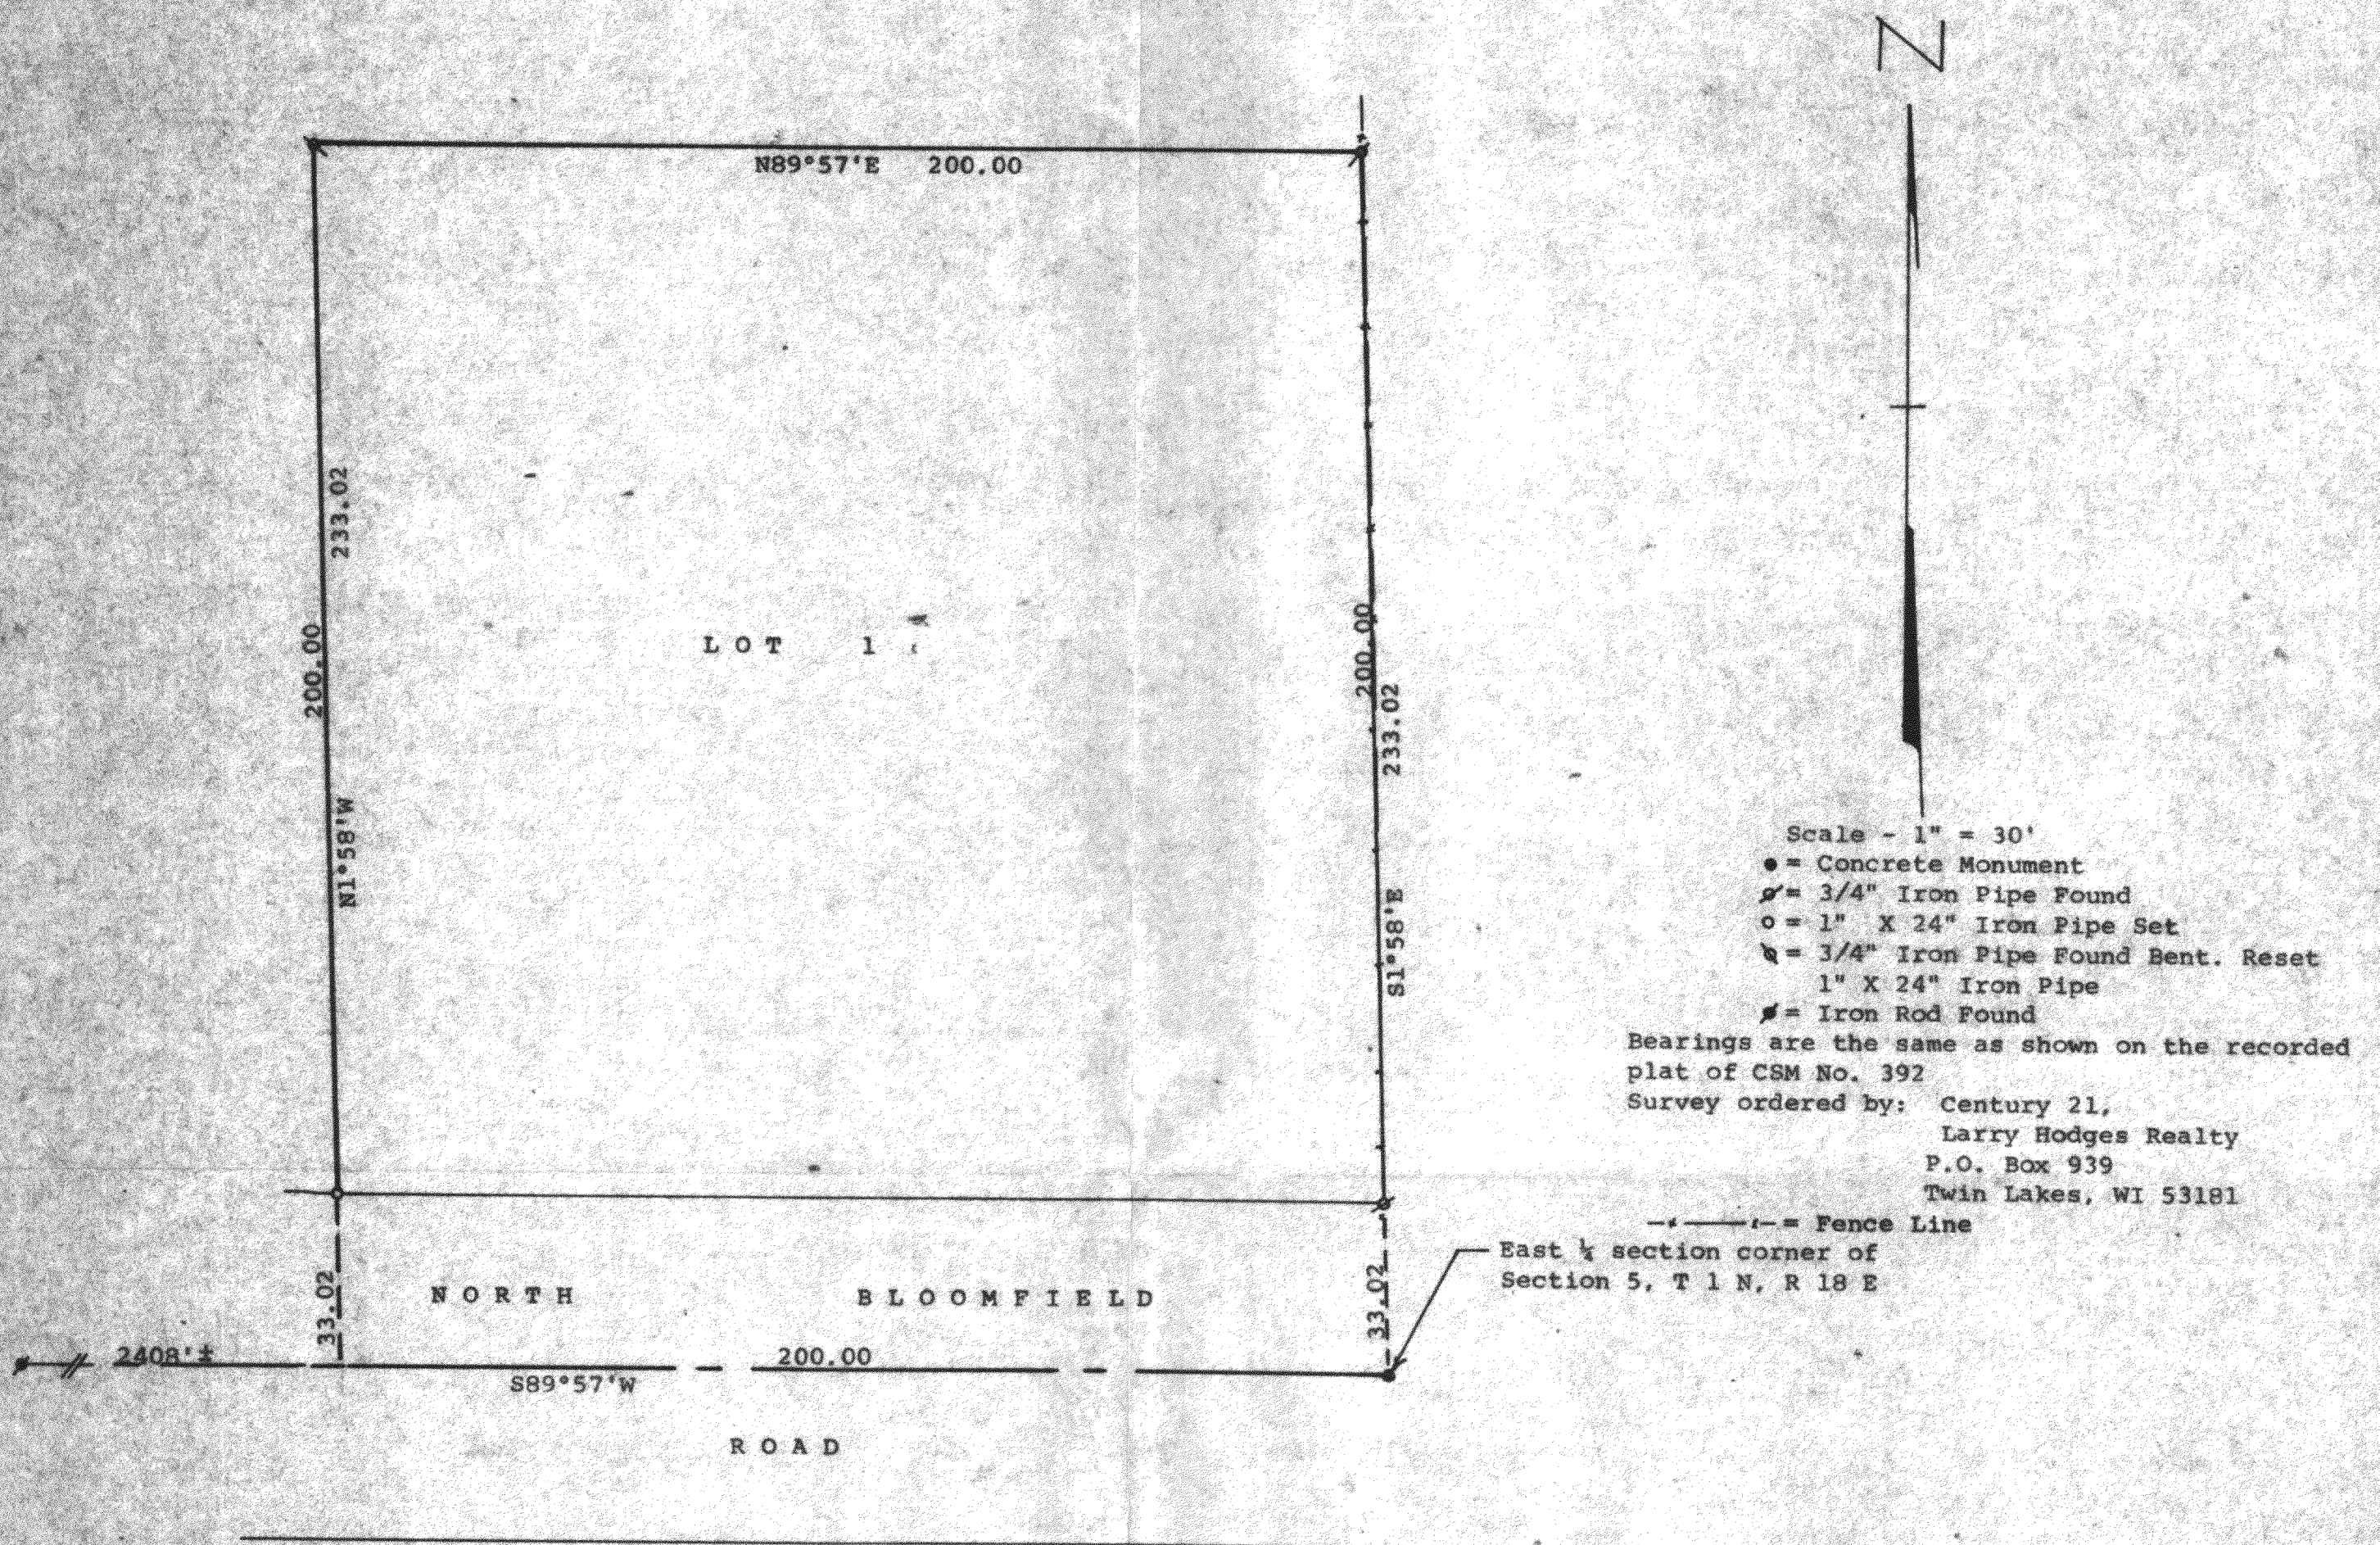



STATE OF WISCONSIN) SS
COUNTY OF WALWORTH)

I, George T. Dunham, Surveyor, certify that I have surveyed the property described as follows:

Lot 1 of Certified Survey Map No. 392, recorded August 5, 1974 in Volume 2 of Certified Surveys on Page 187, in the Office of Register of Deeds in and for Walworth County, Wisconsin, Document No. 681614

and that the plat shown hereon is a correct representation thereof and shows the size and location of the property, its exterior boundaries, the location of all visible structures and dimensions of all principal buildings thereon, boundary fences, apparent easements, roadways and visible encroachments, if any, and that I have surveyed the property hereon described, according to the official records, to the best of my knowledge and belief.
November 7, 1989

George T. Dunham
George T. Dunham, Surveyor

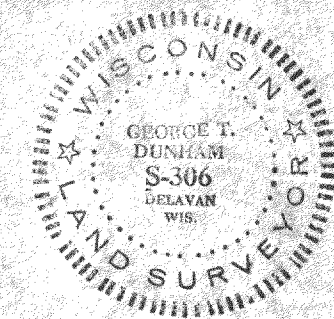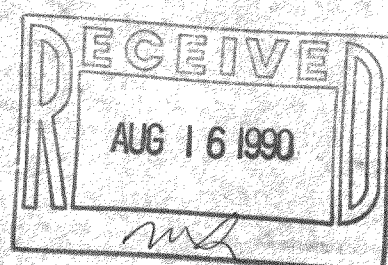

Survey # 118-923

TAX KEY # MA 392 00001