WALWORTH COUNTY
SURVEYING & MAPPING
LAKE GENEVA, WISCONSIN
414-248-0505

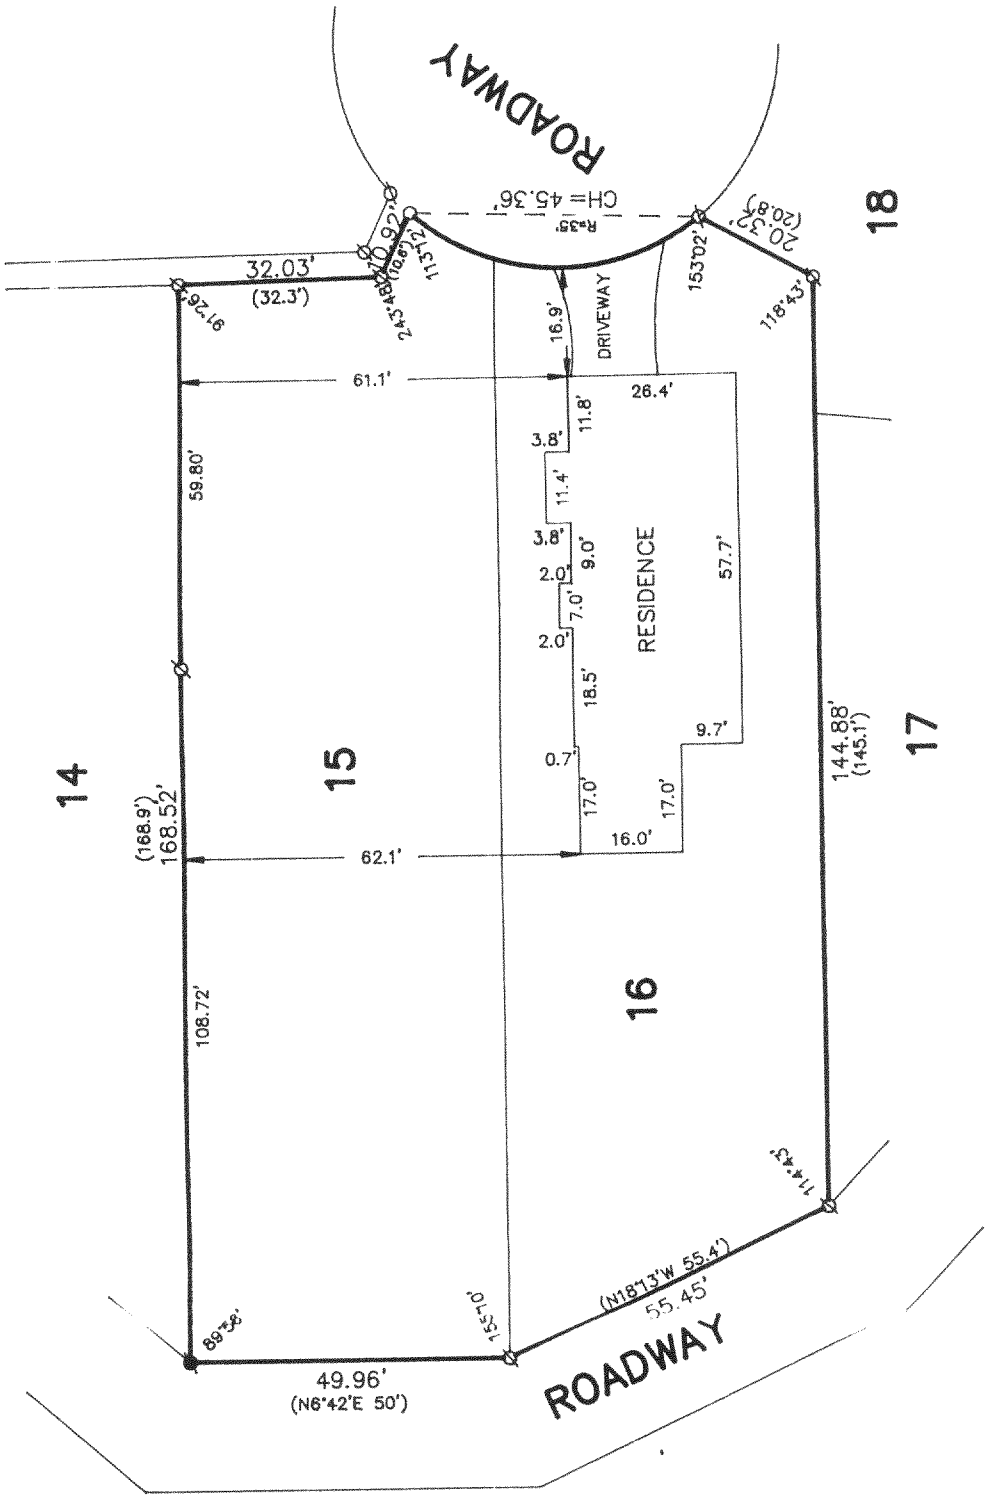

PLAT OF SURVEY OF

LOTS 15 AND 16 OF SHINNER'S FOURTH ADDITION TO
NIPPERSINK PARK, LOCATED IN SECTION 24, T 1 N,
R 18 E, WALWORTH COUNTY, WISCONSIN.

ORDERED BY: JACOBSEN-SORKIN
188 WEST RANDOLPH
CHICAGO, ILLINOIS 60601

RECEIVED
JAN 2 1991

SCALE IN FEET
0 30 60

()-RECORDED AS
ø-IRON PIPE FOUND
○-IRON PIPE PLACED
●-CONCRETE MONUMENT FOUND

I HEREBY CERTIFY THAT I HAVE SURVEYED THE ABOVE DESCRIBED PROPERTY AND THAT THE ABOVE MAP IS A TRUE REPRESENTATION THEREOF AND SHOWS THE SIZE AND LOCATION OF THE PROPERTY, ITS EXTERIOR BOUNDARIES, THE LOCATION OF ALL VISIBLE STRUCTURES AND DIMENSIONS OF ALL PRINCIPAL BUILDINGS THEREON, BOUNDARY FENCES, APPARENT EASEMENTS AND ROADWAYS AND VISIBLE ENCROACHMENTS, IF ANY, TO THE BEST OF MY KNOWLEDGE AND BELIEF.

THIS SURVEY IS MADE FOR THE USE OF THE PRESENT OWNERS OF THE PROPERTY AND ALSO THOSE WHO PURCHASE, MORTGAGE OR GUARANTEE THE TITLE THERETO WITHIN ONE (1) YEAR FROM DATE HEREOF.

Robert M. Baerenwald
ROBERT M. BAERENWALD
WISCONSIN REGISTERED LAND SURVEYOR, S-1508

DATE Jan. 23, 1990 JOB NO. 2332

NOTE: THIS IS NOT A CERTIFIED COPY UNLESS SEALED

Survey# 118-948

TAX KEY # MNPS 400055