


DUNHAM SURVEYING, S.C.
SURVEYING & SUBDIVIDING
DELAVER, WISCONSIN 53115

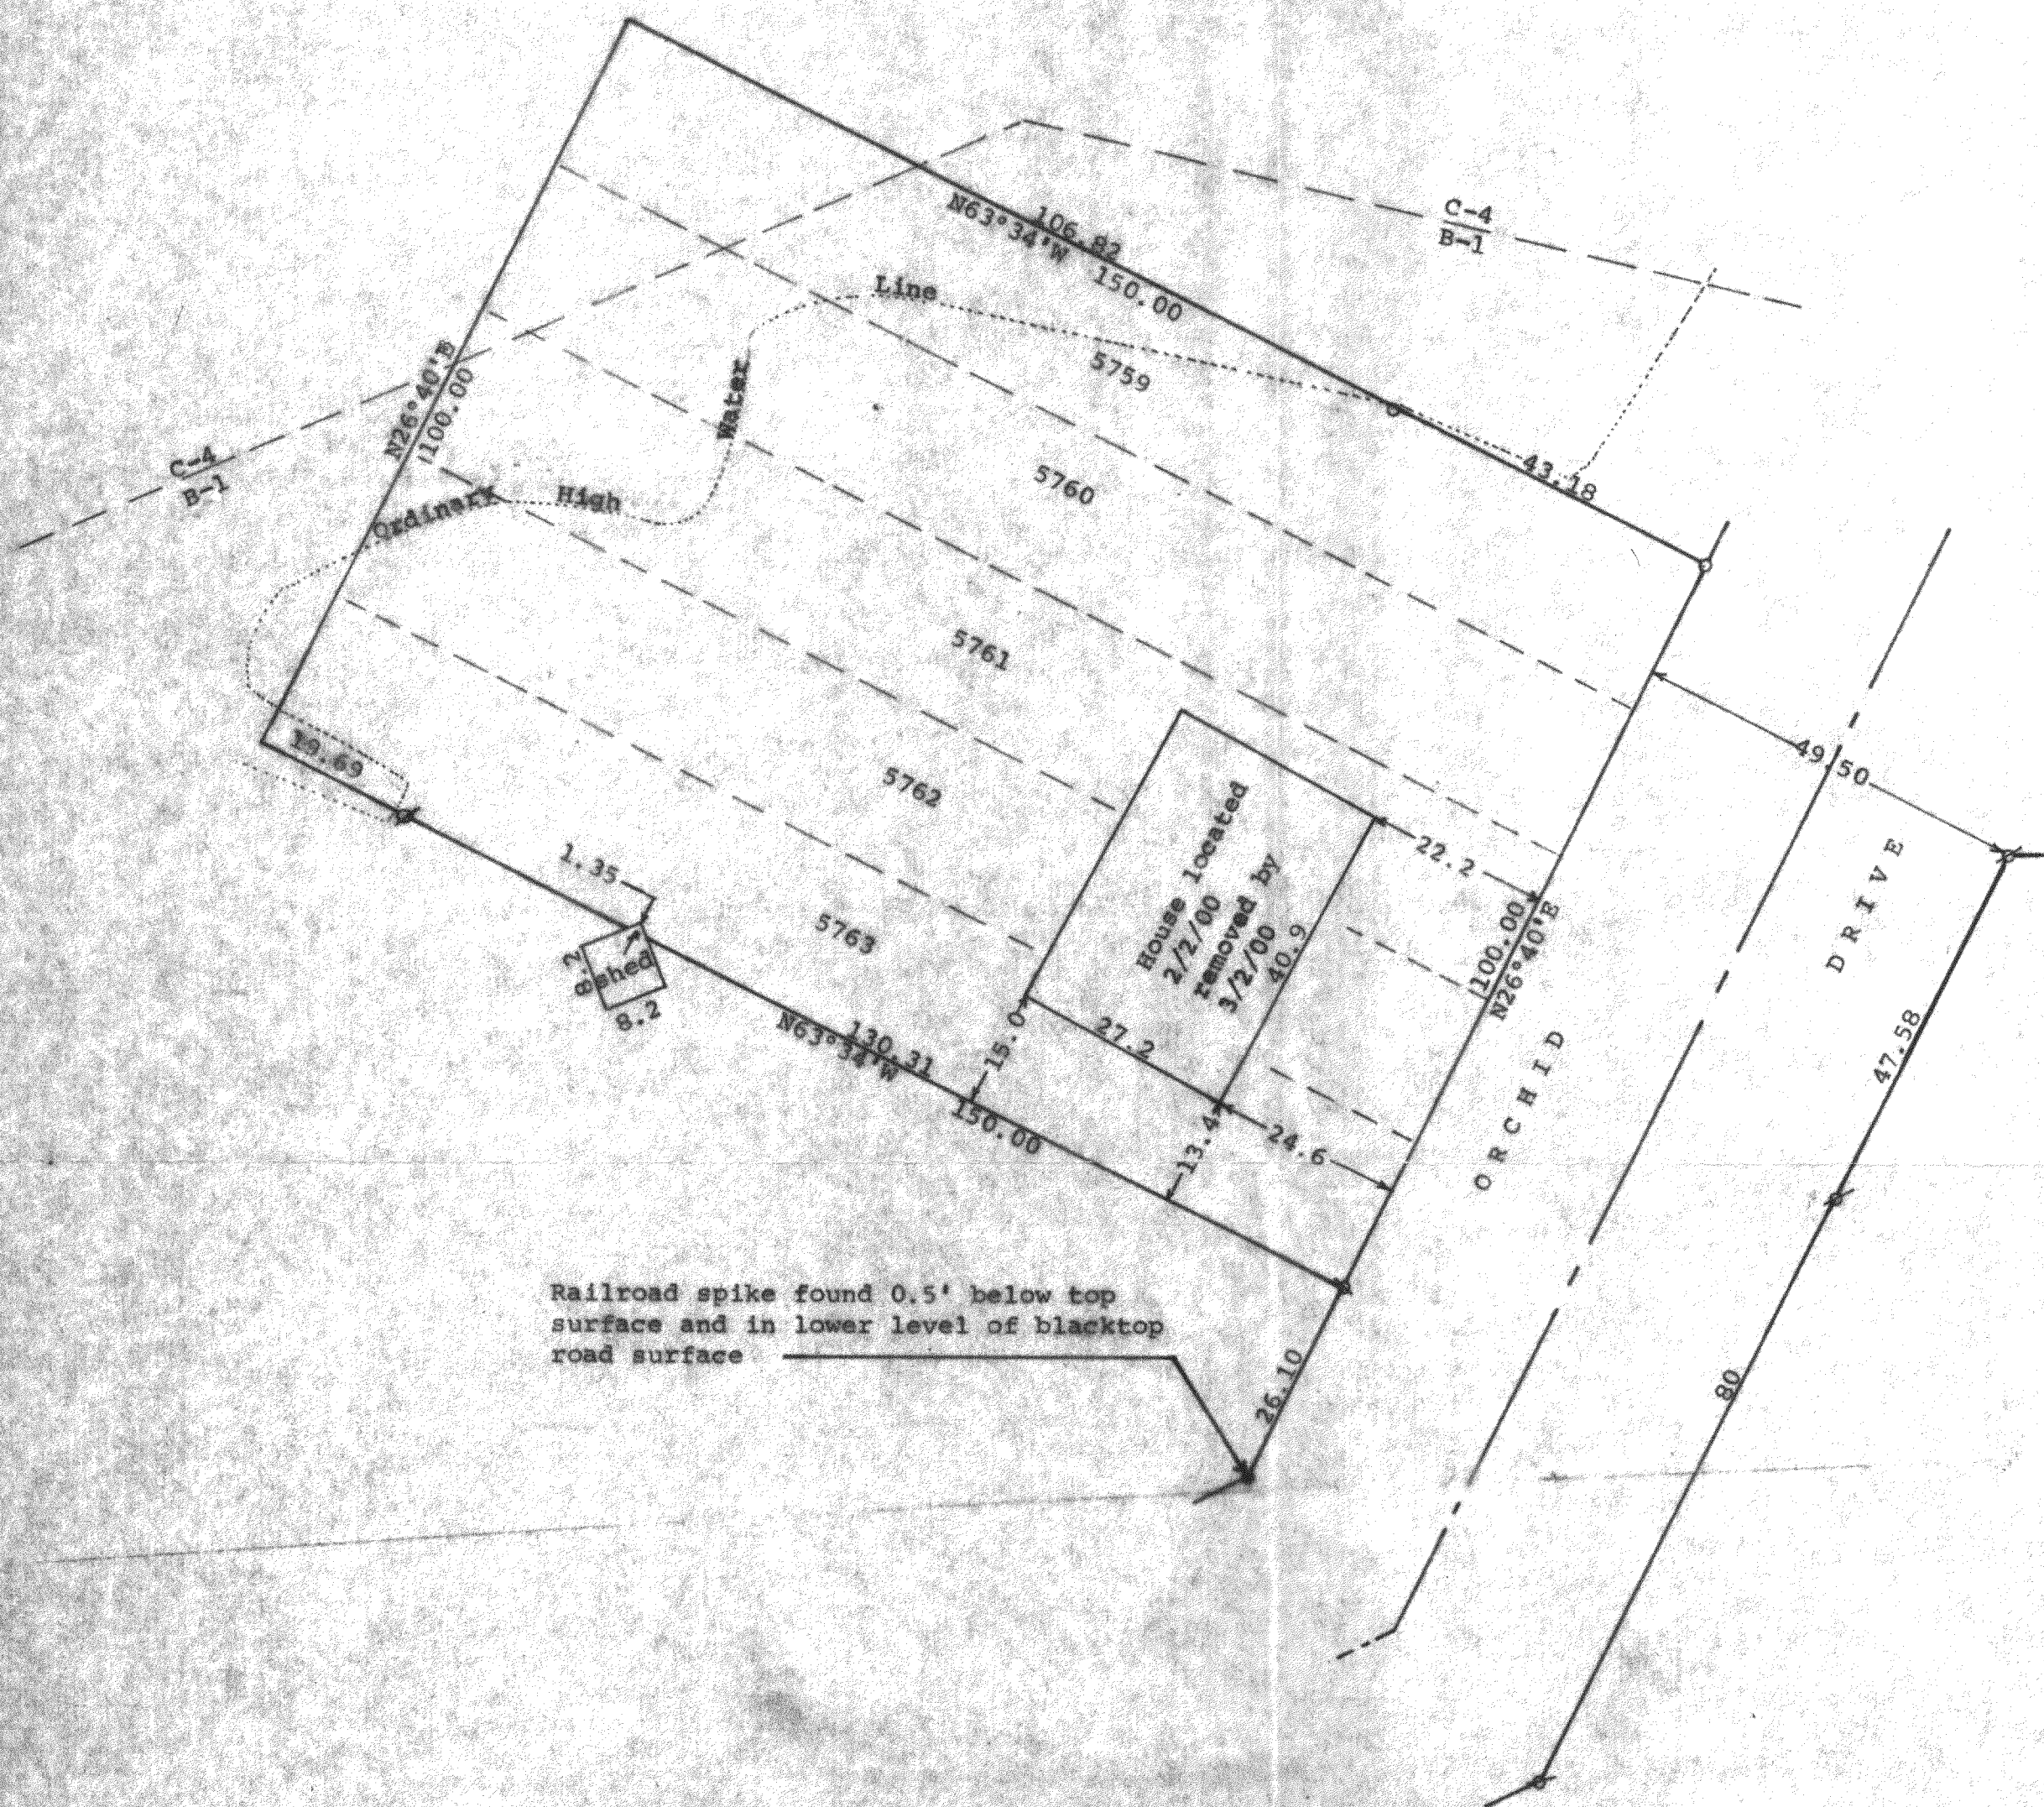

Scale - 1" = 20'
 Ø = Iron Pipe Found
 ● = Railroad spike Found
 α = 1/4" Iron Pipe set in blacktop
 o = 3/4" Iron Pipe Set
 Survey ordered by:
 Larry Morris
 9204 Creek Road
 Box 108
 Clinton, WI 53525
 Bearings referenced to the recorded

STATE OF WISCONSIN) ss
 COUNTY OF WALWORTH)

I, George T. Dunham, Surveyor, certify that I have surveyed
 the property described as follows:

Lots 5759-5763 in Block 101 of Section 3 of Pell Lake
 Subdivision located in Section 15, T 1 N, R 18 E, Walworth
 County, Wisconsin,

and that the above map is a true representation thereof and shows
 the size and location of the property, its exterior boundaries, the
 location of all visible structures and dimensions of all principal
 buildings thereon, boundary fences, apparent easements, roadways
 and visible encroachments, if any, and that I have surveyed the property
 hereon described, according to the official records, to the best of my
 knowledge and belief.

March 2, 2000

Updated April 5, 2000 to show
 Zoning designation and Ordinary
 High Water Line

George T. Dunham
 George T. Dunham, Surveyor

