HAROLD H. KOLB

REGISTERED PROFESSIONAL LAND SURVEYOR
LAKE GENEVA, WISCONSIN

PLAT OF SURVEY OF
Lots 4719 - 4723, Block 91, Pell Lake,
a subdivision located in T 1 N, R 18 E,
Walworth County, Wisconsin.

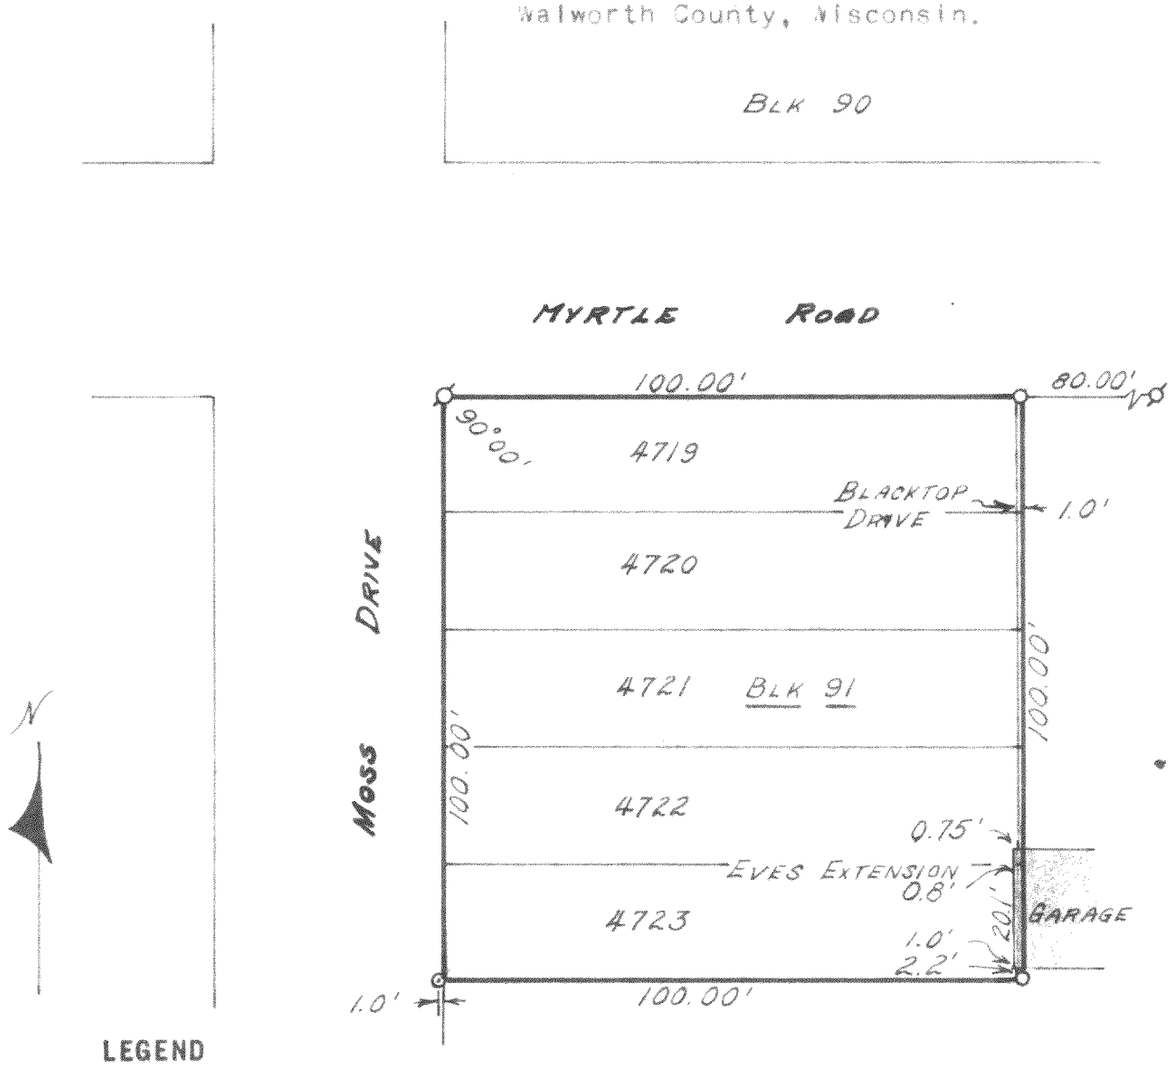

LEGEND

- ⌀ — IRON PIPE FOUND
- o — IRON PIPE PLACED
- ● — CONCRETE MONUMENT
- x — SPIKE

SCALE 1" = 30'

WISCONSIN
HAROLD H. KOLB
S-187
LAKE GENEVA, WIS
LAND SURVEYOR

I, HAROLD H. KOLB, DO HEREBY CERTIFY THAT I HAVE SURVEYED THE PROPERTY HEREON DESCRIBED ACCORDING TO THE OFFICIAL RECORDS, AND THAT THE PLAT HEREON IS A CORRECT REPRESENTATION OF THE LOT LINES.

Harold H. Kolb
HAROLD H. KOLB
WISCONSIN REGISTERED LAND SURVEYOR, S—187
DATE JUNE 20, 1968

118-233