PREPARED FOR
ROBERT BENJAMIN
PO BOX 706
PELL LAKE, WI. 53157

PATHFINDER SURVEYING INC.
(formerly)
J.K. SURVEYING INC.
P.O BOX 322
LAKE GENEVA, WI. 53147
WWW.PATHFINDERSURVEYING.NET
262-248-8303

PLAT OF SURVEY

- OF -

LOTS 2715 THRU 2720 AND THE EASTERLY 98.55 OF THE SOUTHERLY 1 FOOT OF LOT 2721, ALLIN BLOCK 68, PELL LAKE SUBDIVISION, LOCATED IN TOWN 1 NORTH, RANGE 18 EAST, VILLAGE OF BLOOMFIELD, COUNTY OF WALWORTH AND STATE OF WISCONSIN.

RECEIVED
JUN 21 2017
By SMF

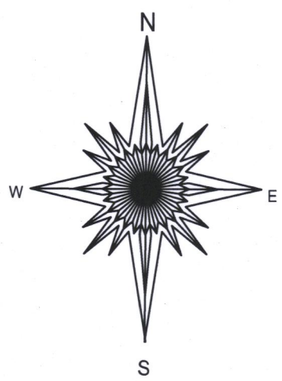

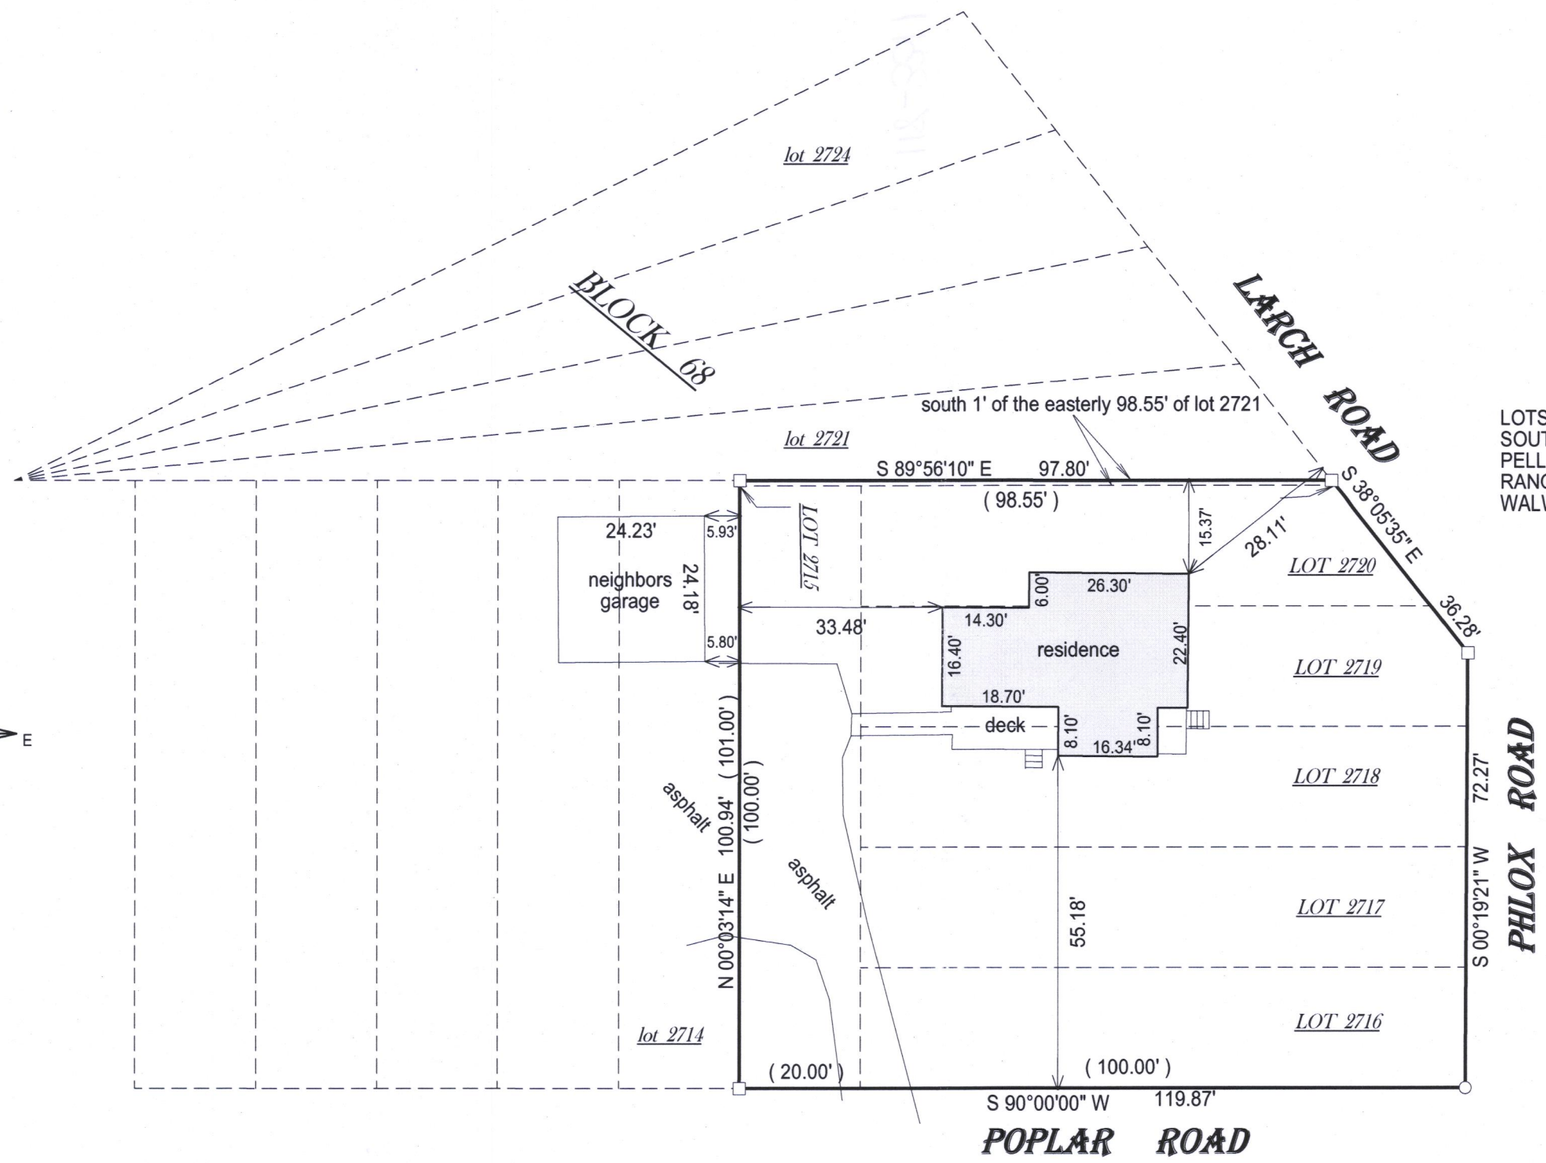

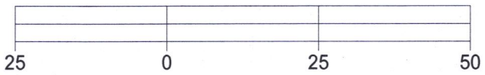

BASIS OF BEARING OF THIS PLAT: THE NORTH LINE OF POPLAR RD. WAS ASSUMED TO BEAR WEST AS MONUMENTED.

( )= recorded as
□ = found iron bar
○ = found iron pipe
● = set iron pipe
■ = set iron bar

SCALE 1" = 25'

JOB # 17-11

TAX ID # &PL00565

"I hereby certify that I have surveyed the above described property and that the above map is a true representation of its exterior boundary and shows the size and location of all visible structures, apparent easements and encroachments if any."

This survey is made for the present owners of the property, and those who purchase, mortgage, or guarantee the title thereto, within one year from the date hereof.

DATED THIS 24TH DAY OF JANUARY, 2017.

WISCONSIN
JEFFREY L. KIMPS
S-2436
LAKE GENEVA. WIS.
LAND SURVEYOR

JEFFREY L KIMPS S - 2436
Wisconsin Professional Land Surveyor
(original if signed in red)

118-3311