ROBERS & FISCHER, INC.
CONSULTING ENGINEERS & LAND SURVEYORS
PHONE (414) 763-2652 116 E. CHESTNUT ST. BURLINGTON, WIS. 53105

PLAT OF SURVEY AND HOUSE LOCATION

Lots 2410, 2411, 2412, 2413, 2414, 2480, 2481, 2482, 2483, 2484, 2485, 2486, of Block 61, Section 2, Pell Lake Subidivions, Walworth County, Wisconsin

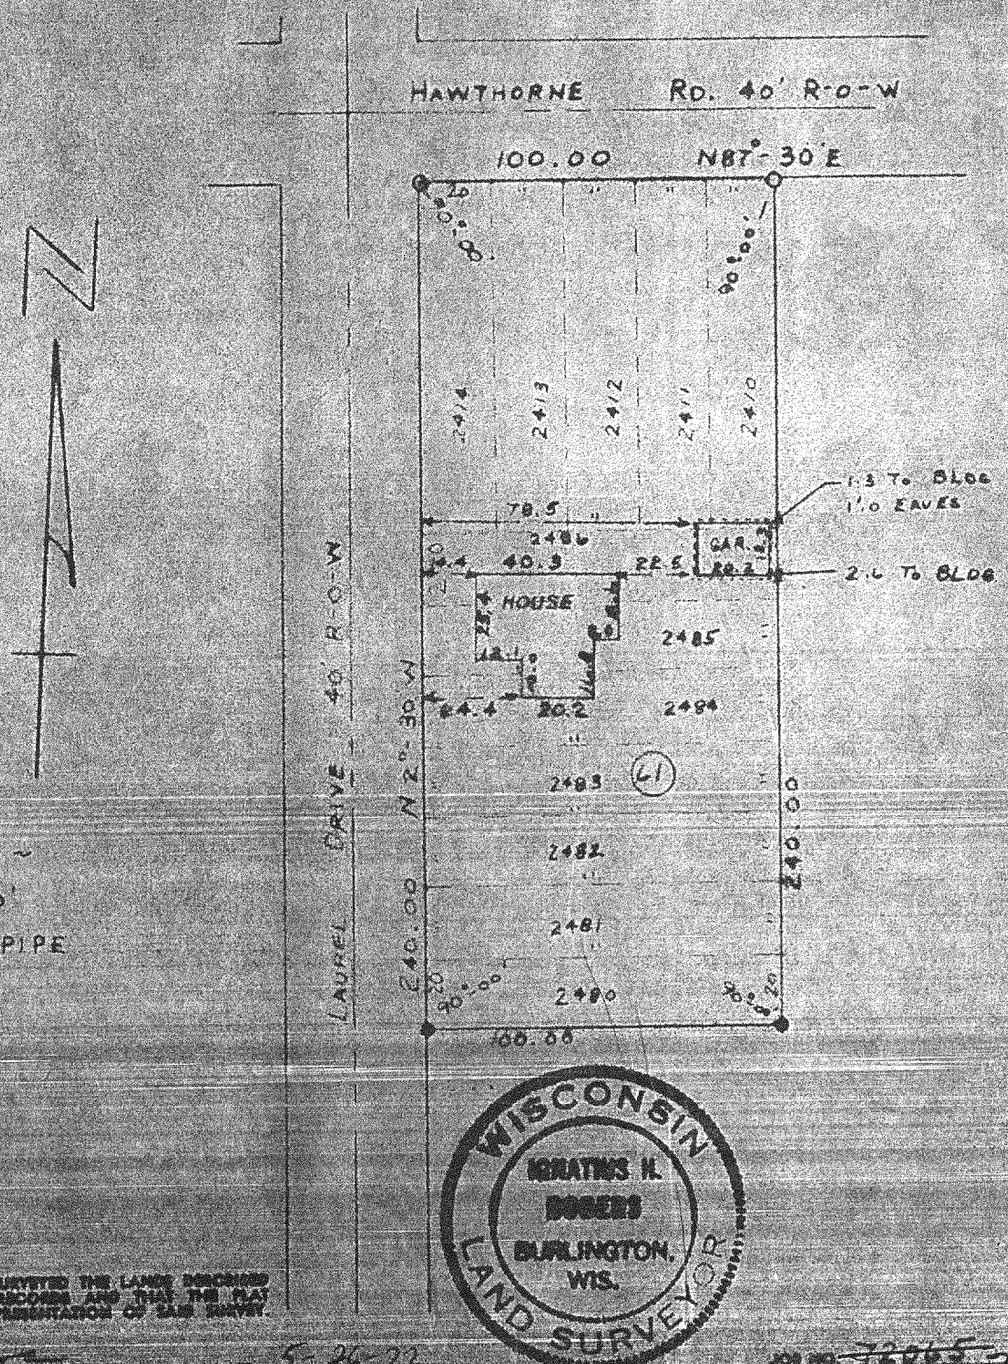

I HEREBY CERTIFY THAT WE HAVE SURVEYED THE LANDS DESCRIBED ABOVE ACCORDING TO OFFICIAL RECORDS AND THAT THE MAP DRAWN HEREON IS A CORRECT REPRESENTATION OF SAID SURVEY.

Signature: Jonathan H. Robers
WISC. LAND SURVEYOR S-00782

DATE 5-26-72

JOB NO. ~~74065~~ 356
114-20