


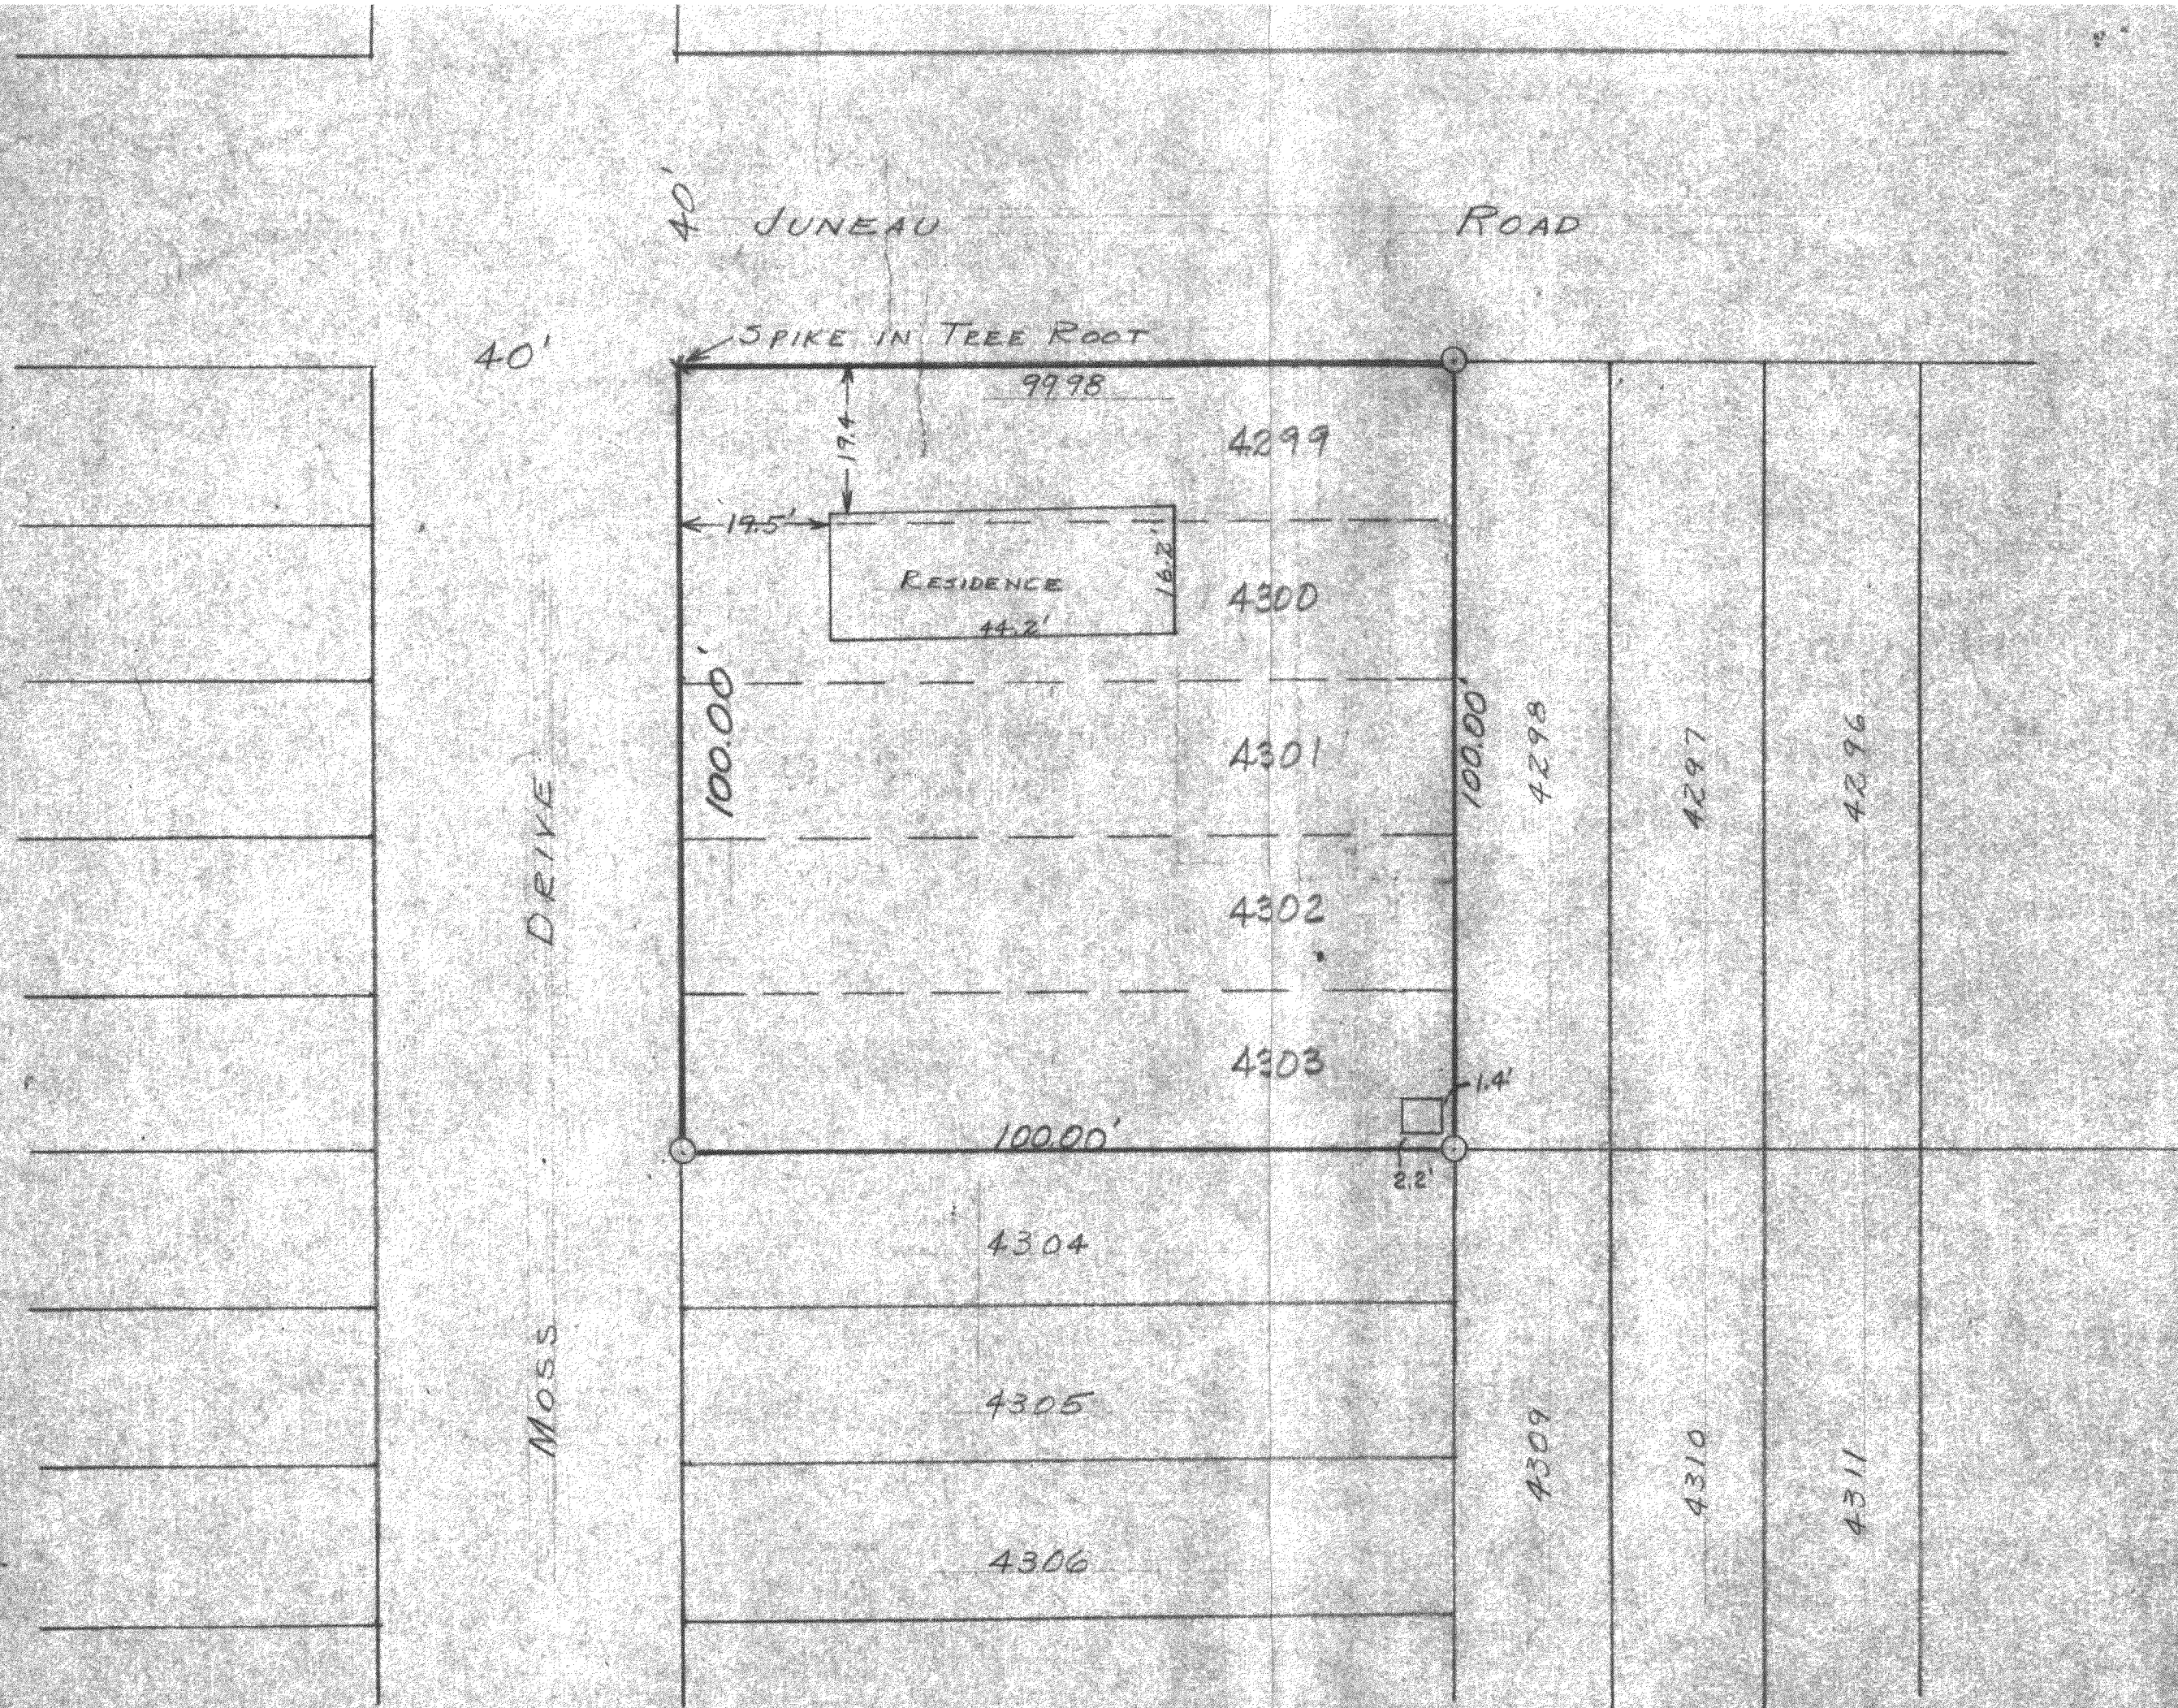

SCALE 1"=20'
 O = IRON PIPE
 X = 60d SPIKE

PLAT OF SURVEY OF LOTS 4299 TO 4306 INCLUSIVE BLOCK 85
 PELL LAKE SUBDIVISION, WALWORTH COUNTY, WISCONSIN.

JUNE 1952

Lloyd S. Jensen
 COUNTY SURVEYOR

118-42.1