PLAT OF SURVEY

LOTS 1 & 3, LAKE GROVE SUBDIVISION, LOCATED IN THE SOUTHEAST 1/4 OF SECTION 13, T. 1 N., R. 18 E. OF THE 4TH P.M., TOWNSHIP OF BLOOMFIELD, COUNTY OF WALWORTH, STATE OF WISCONSIN.

I HEREBY CERTIFY THAT I HAVE SURVEYED THE LAND DESCRIBED ABOVE AND THAT THE PLAT DRAWN HEREON IS A CORRECT REPRESENTATIONOF SAID SURVEY.

John F Degen 6-20-75

JOHN F. DEGEN, LAND SURVEYOR #242
589 N. PINE ST., BURLINGTON, WISCONSIN.

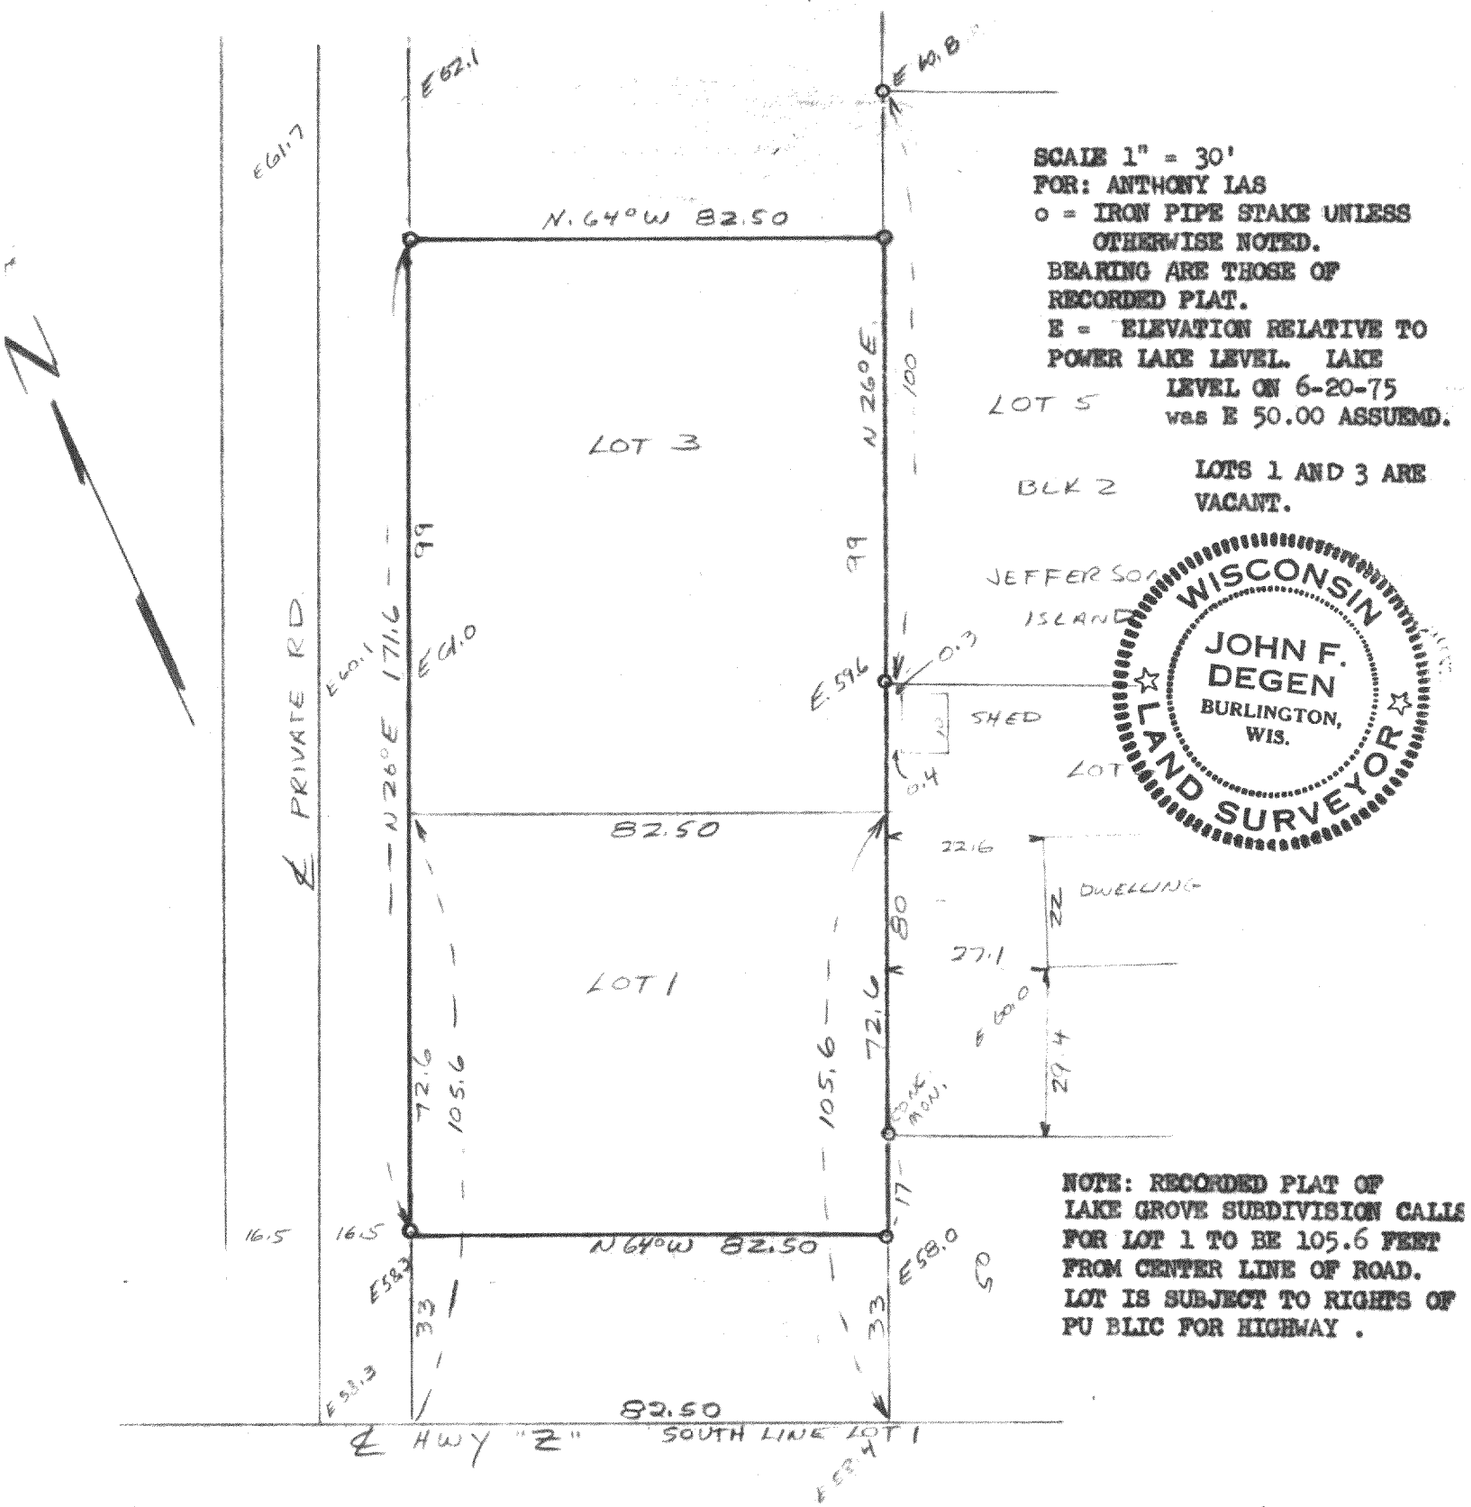

SCALE 1" = 30'
FOR: ANTHONY LAS
o = IRON PIPE STAKE UNLESS OTHERWISE NOTED.
BEARING ARE THOSE OF RECORDED PLAT.
E = ELEVATION RELATIVE TO POWER LAKE LEVEL. LAKE LEVEL ON 6-20-75 was E 50.00 ASSUEMD.

LOTS 1 AND 3 ARE VACANT.

WISCONSIN
JOHN F. DEGEN
BURLINGTON, WIS.
LAND SURVEYOR

NOTE: RECORDED PLAT OF LAKE GROVE SUBDIVISION CALLS FOR LOT 1 TO BE 105.6 FEET FROM CENTER LINE OF ROAD. LOT IS SUBJECT TO RIGHTS OF PU BLIC FOR HIGHWAY .

118-486

ML6-1

JFD 6-20-75 DRAWER 6C3 7