HAROLD H. KOLB

REGISTERED PROFESSIONAL LAND SURVEYOR
LAKE GENEVA, WISCONSIN

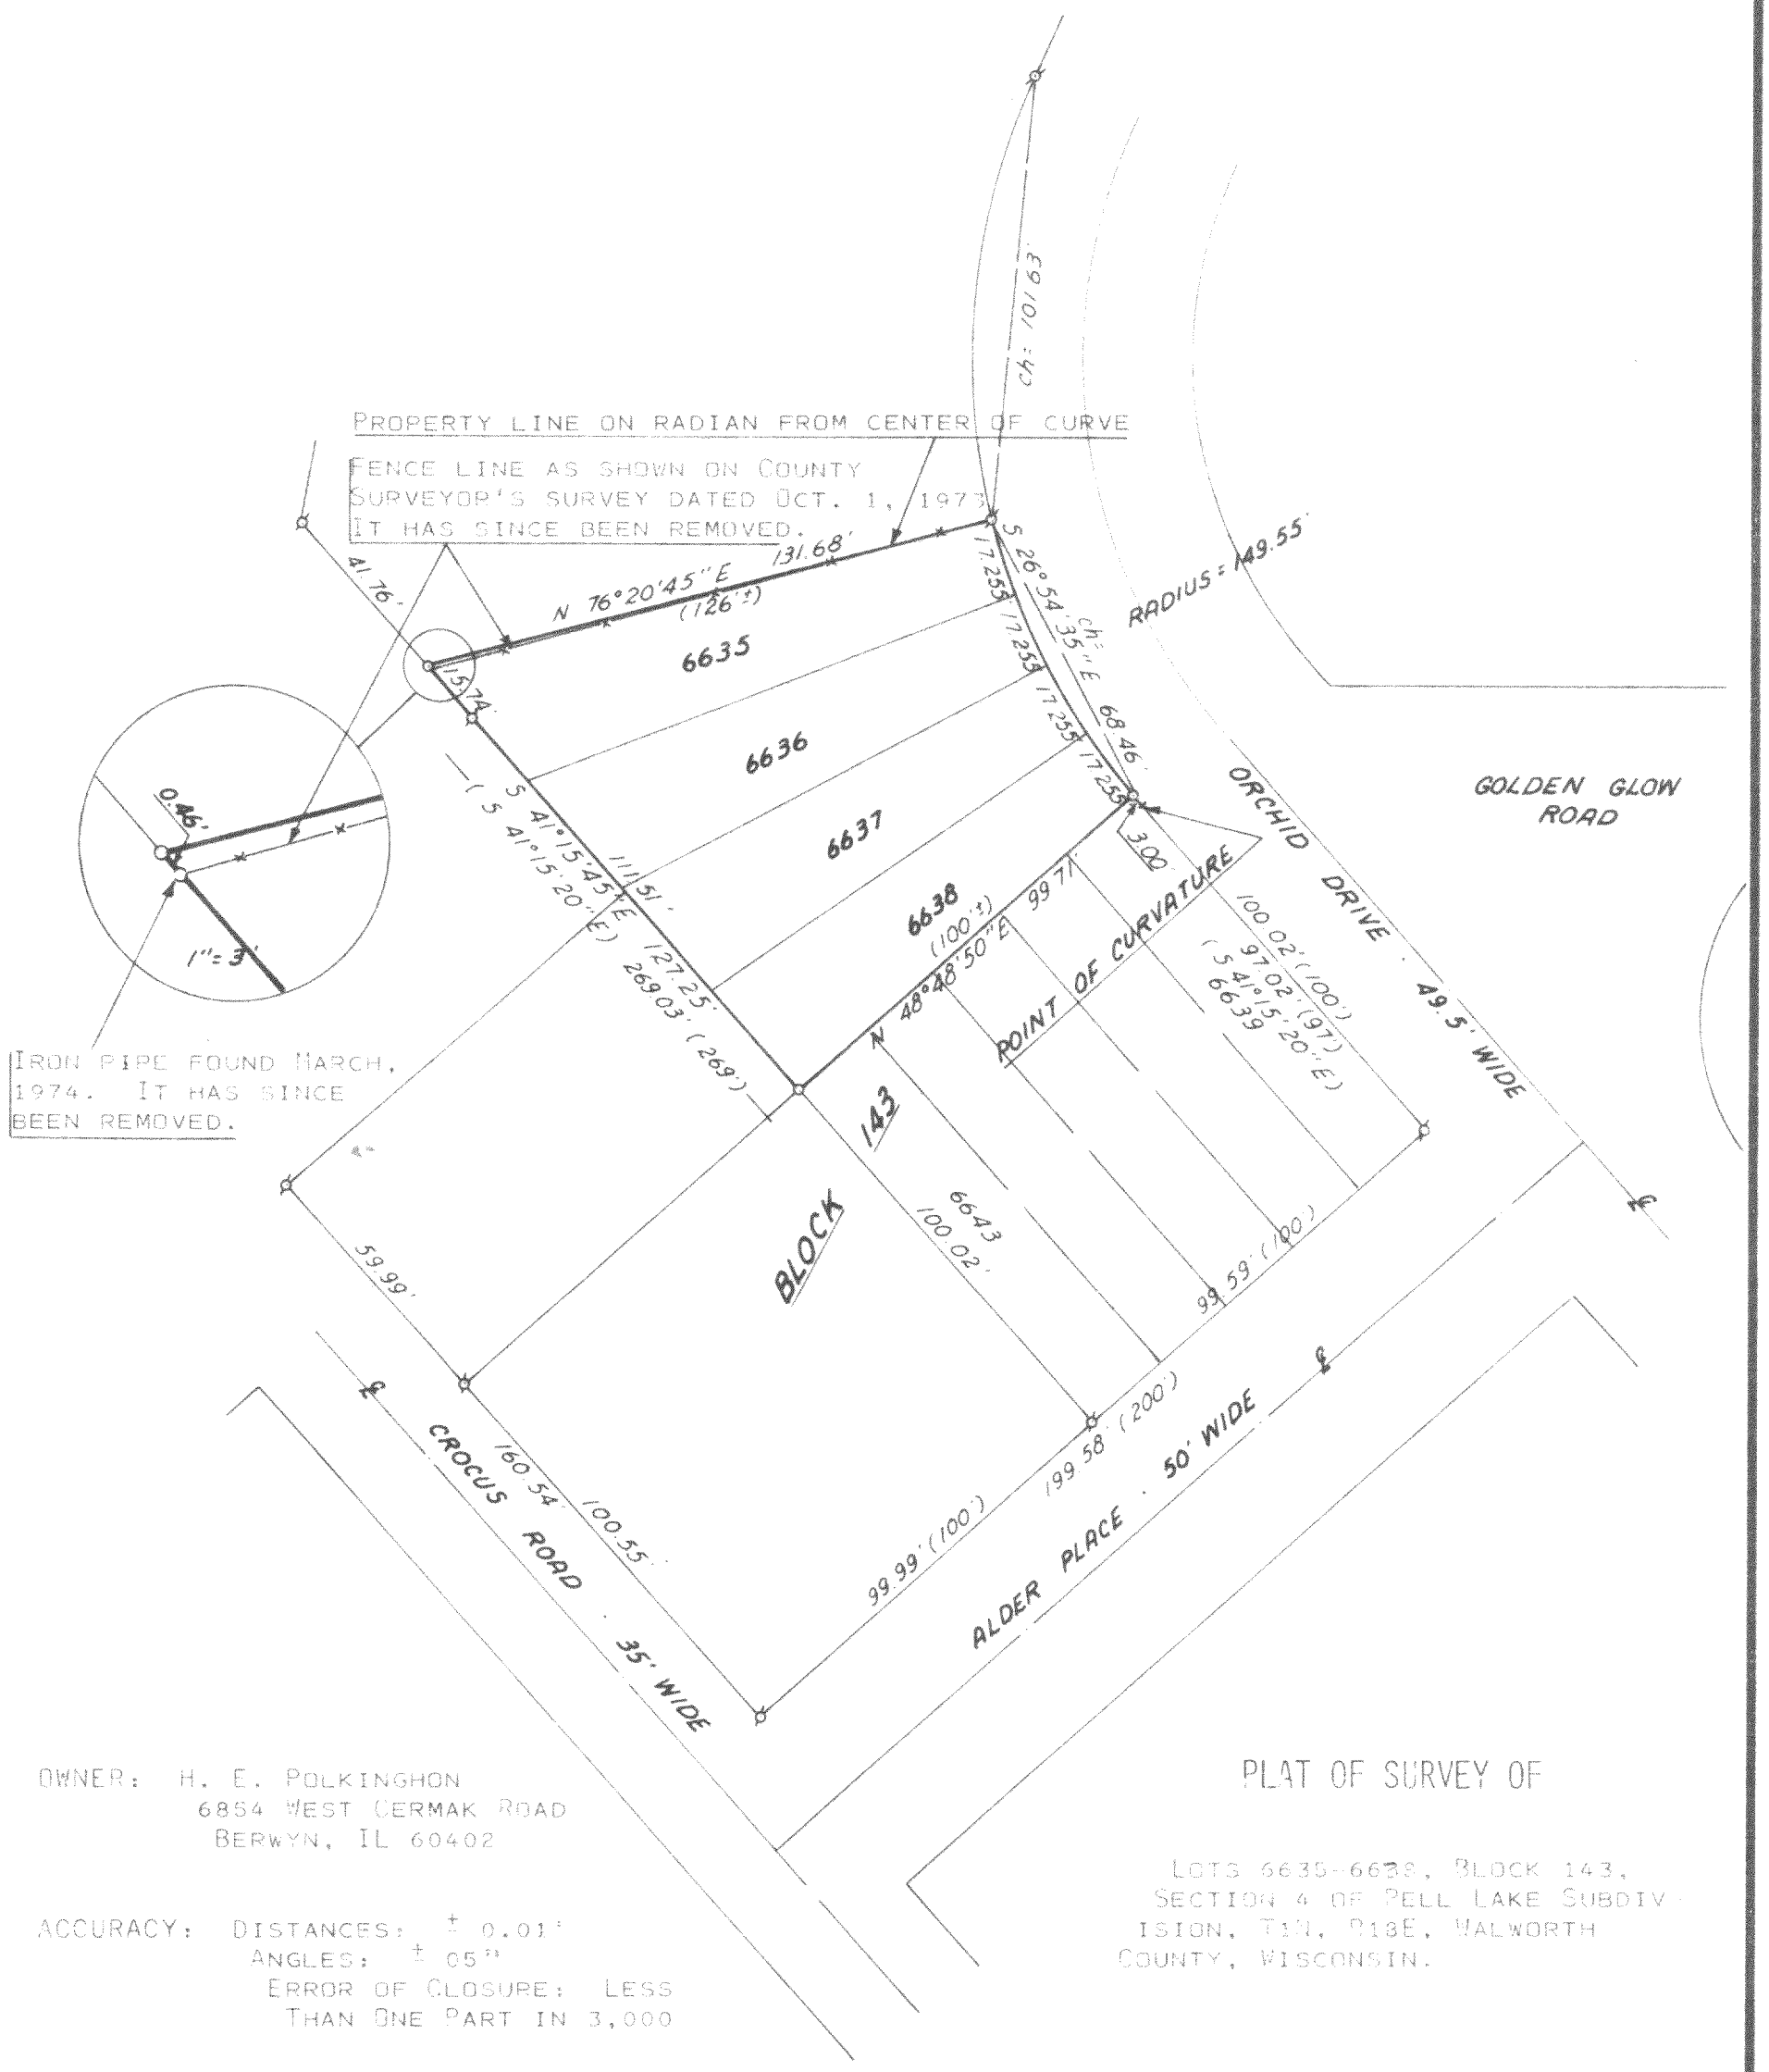

OWNER: H. E. POLKINGHON
6854 WEST CERMAK ROAD
BERWYN, IL 60402

ACCURACY: DISTANCES: ± 0.01'
ANGLES: ± 05"
ERROR OF CLOSURE: LESS THAN ONE PART IN 3,000

PLAT OF SURVEY OF

LOTS 6635-6639, BLOCK 143, SECTION 4 OF BELL LAKE SUBDIVISION, T1N, R18E, WALWORTH COUNTY, WISCONSIN.

N

SCALE: 1" = 40'

LEGEND

- ϕ — IRON PIPE FOUND
- O — IRON PIPE PLACED
- ● — CONCRETE MONUMENT
- x — SPIKE
- ( ) — RECORDED AS

WISCONSIN HAROLD H. KOLB S-187 LAKE GENEVA, WIS. LAND SURVEYOR

I. HAROLD H. KOLB, DO HEREBY CERTIFY THAT I HAVE SURVEYED THE PROPERTY HEREON DESCRIBED ACCORDING TO THE OFFICIAL RECORDS, AND THAT THE PLAT HEREON IS A CORRECT REPRESENTATION OF THE LOT LINES.

Harold H. Kolb
HAROLD H. KOLB
WISCONSIN REGISTERED LAND SURVEYOR, S-187
DATE Jan. 7, 1976

118-505

BRUNING 40-105 500-6-71