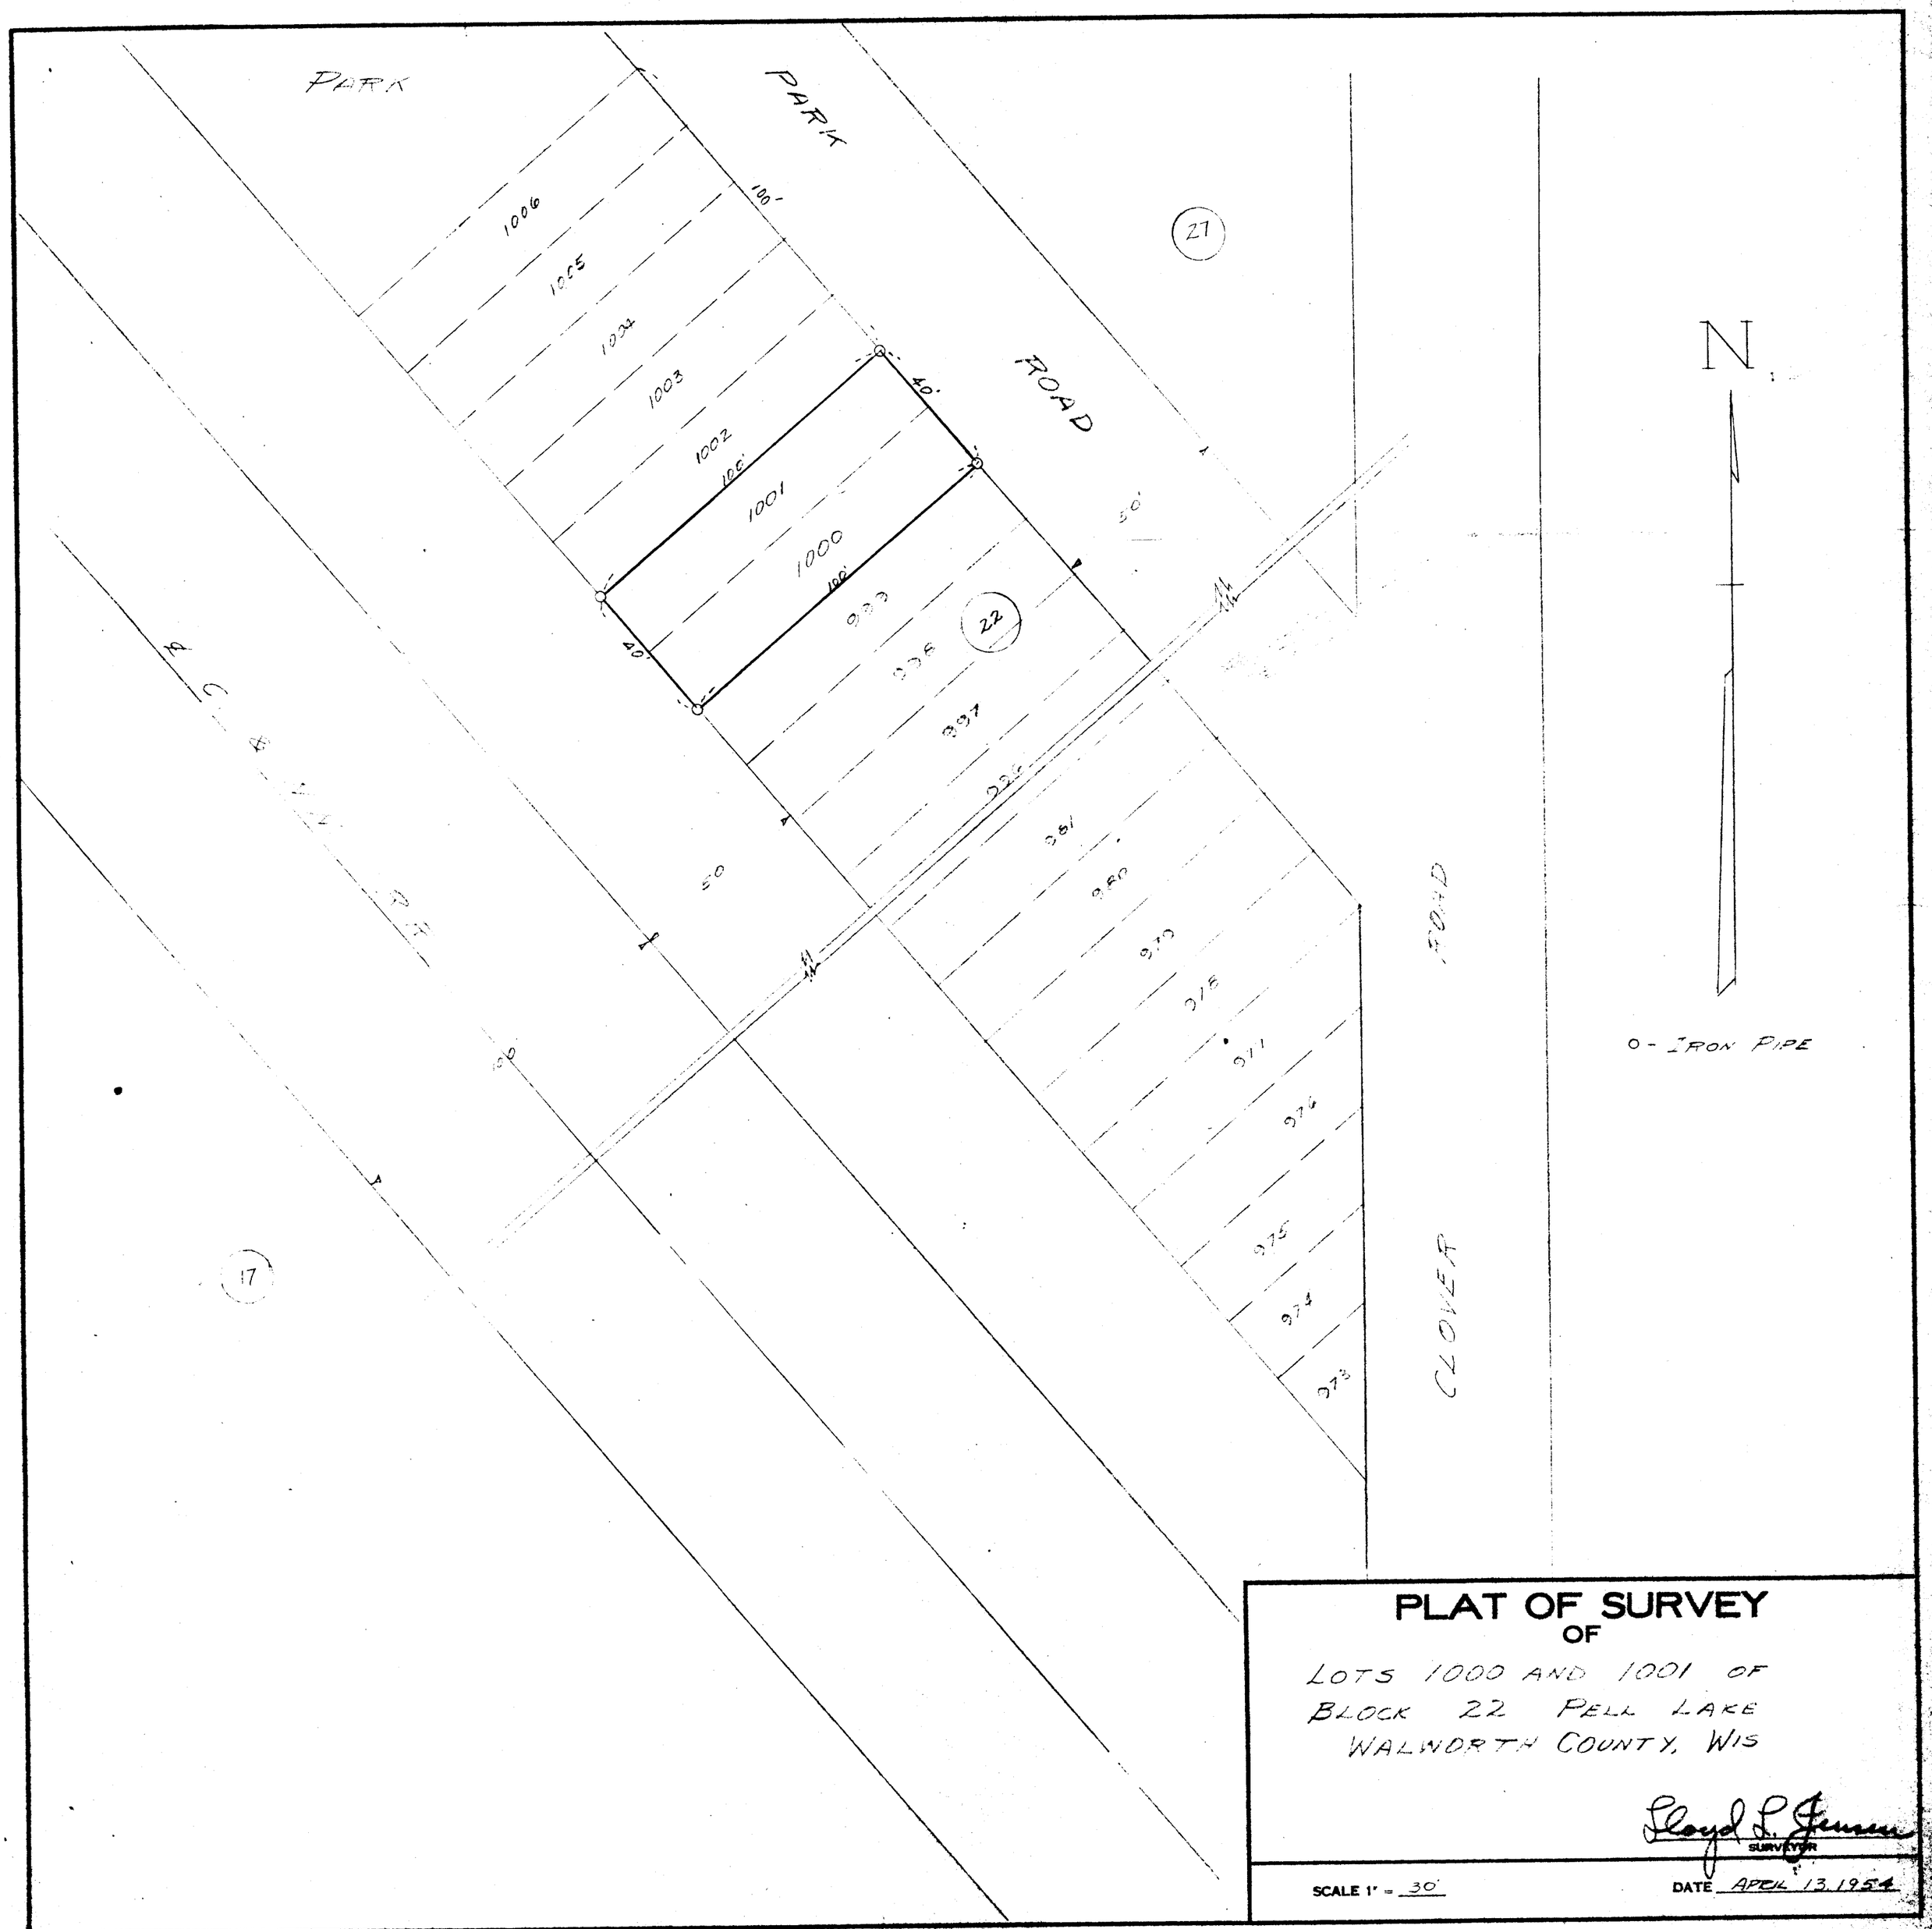

NO. 177H—400—3-10-53

118-60