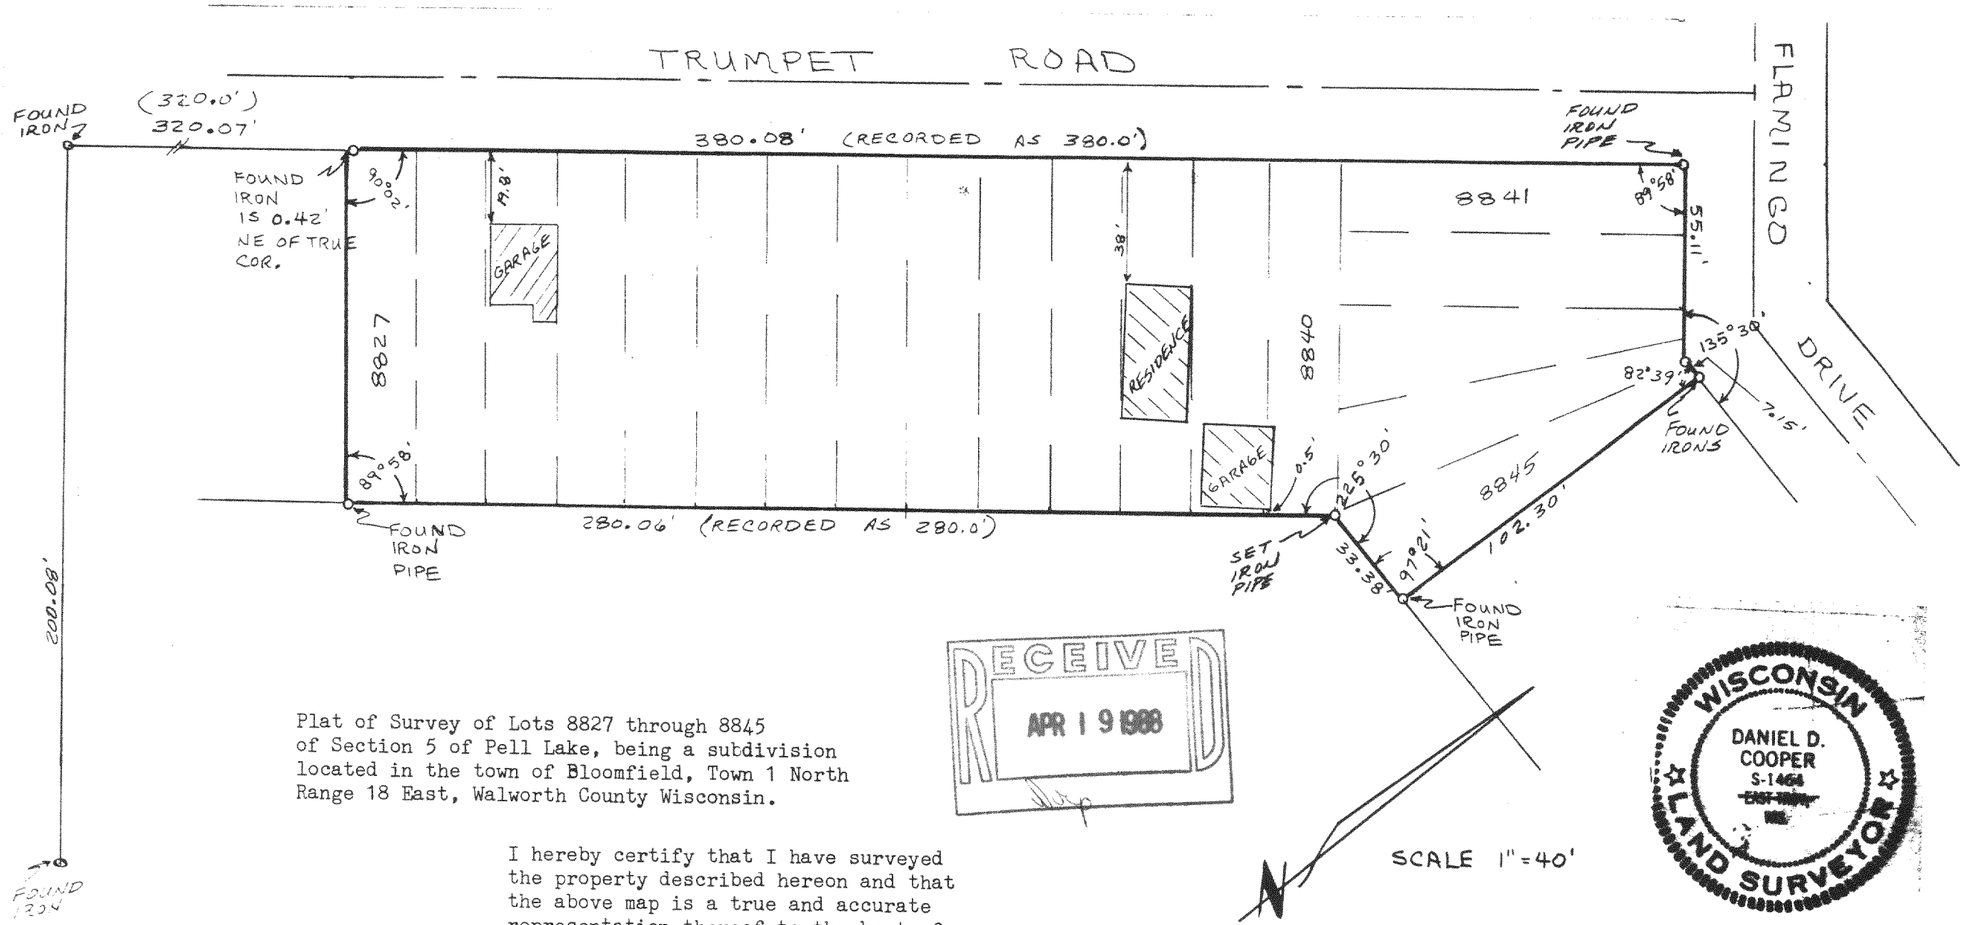


Plat of Survey of Lots 8827 through 8845 of Section 5 of Pell Lake, being a subdivision located in the town of Bloomfield, Town 1 North Range 18 East, Walworth County Wisconsin.

RECEIVED APR 19 1988

WISCONSIN DANIEL D. COOPER S-1464 LAND SURVEYOR

I hereby certify that I have surveyed the property described hereon and that the above map is a true and accurate representation thereof to the best of my professional knowledge and belief.

Dated this 7TH day of DEC., 1983

Daniel D. Cooper

Daniel D. Cooper, RLS No. S-1464

**COOPER SURVEYING SERVICES**
Rural - Residential - Commercial
Route 4, Box 508B :: Elkhorn, Wisconsin 53121
Phone (414) 723-6265

Work ordered by Randall Leece Atty.

118-787

DRAWING NO. 1893